WATER V				rm WWC				sion of Water			MANAG			
	al Record		rection	Change in W			Resou	rces App. No.	L	J Well ID	MW6			
1 LOCA	ATION OF V Leavenwood		WELL:		raction SE ¼ SE ¼	SE ½	NE 1/4		er Township Nur T 9	nber Range S R 2	Number 2 X E W			
2 WELI	L OWNER: 1	Last Nam	e:	F	irst:	_		1						
		Leavenworth County Cooperative Association from nearest town or intersection): If at owner's address, check here:												
I .	Address: 1101 Industrial Street 1205 N Main, Lansing KS Address:													
City		sing	State:	KS Z	IP: 66043									
3 LOCA	TE WELL		4 DEPTI	OF COMI	PLETED WELL:	19	ft f	Latitude:	39.26	727 (de	cimal degrees)			
1	WITH "X" IN Depth(s) Groundwater Encountered: 1) ft Longitude 94.90012 (decimal deg													
SECTION BOX: 2) ft 3) ft, or 4) Dry Well Horizontal Datum X WGS 84 NAD 83									83 NAD 27					
	N WELL'S STATIC WATER LEVEL: 6.96 ft. X below land surface, measured on (mo-day-yr) 6/21/2021								Source for Latitude/Longitude: GPS (unit make/model:					
	above land surface, measured on (mo.day.yr)													
I NW	NW NE Pump test data: Well water was fi								X Land Survey Topographic Map					
w	x after hours pumping gpm								Online Mapper					
l l	- 1		after		r well was pumping	ft gpm		Elevation	9/1 00 B	Cround L	wel V TOC			
sw .	SE		Estimated	 / ield:	gnm	Б]лп	6 Elevation 841.00 ft Ground Level X TOC Source X Land Survey GPS Topographic Map							
	Estimated Yield:gpm Bore Hole Diameter:7.25 in to				ft, an									
	S			*****	in to	fi				***************************************	/*************************************			
	WATER TO		DAC.											
1 Domestic:	WATER TO			Water Supply	y: well ID		10	Oil Field	Water Supply: leas	e				
I-louse	hold			ering: how m				Test Hole: wel						
==	& Garden		7 Aquife	-				Cased	Uncased	Geotechnic	al			
Livesto			8 X Monito	_			12	Geothermal: Ho						
2 Irrigati 3 Feedlo			9 Environme	_		nation		a) Closed Loc						
4 Industr			Air Sp		Soil Vapor Extra	actior		b) Open Loop Other (spe		ischarge	Inj. of Water			
										••••••••••••••••••••••••				
Was a chemic				ed to KDHE	E? Yes X	No	If yes, dat	e sample was su	ıbınitted:					
				v pvo l	704		10010 101	NES COL						
Casing diame	ter 2	in. to	5 ft.	Diameter	Otherin.	to	U ASING JOI	N15: []GIU Diameter	ed Clampled	Welded	X Threaded			
Casing height	t above land su	rface	-0.55 in.	Weig	ht	lbs./fi	t. Well t	hickness or gan	in. to					
TYPE OF S	CREEN OR	PERFOI	RATION MA	TERIAL:										
Steel	Stainle		Fib	_	X PVC			ther (Specify)						
Brass		nized Stee	-	ncrete tile	None used (c	pen hole)								
l —	R PERFORA	X Mill		Gauze W	/rannad	County Cout	[] D.:II.	d Halas	Cultura (Consider	,				
						orch Cut		d Holes (Open Hole)	Other (Specify	<u>/)</u>				
Louvered Shutter Kcy Punched Wire Wrapped Saw Cut None (Open Hole) SCREEN-PERFORATED INTERVALS: From 5 ft. to 19 ft, From ft. to ft,														
GRAVEL PACK INTERVALS: From 3 ft. to 19 ft, From ft. to ft, From ft. to ft,														
	MATERIAL:			Ceme	ent grout X B	entonite	X Other	Concrete: 0-0.	5'		114114444517144			
Grout interva				ft, Fro	mft. to)	ft, Fron	n ft.	to ft,	***************************************	***************************************			
Nearest sour	ce of possibl	e contan	nination:	••••		***************************************	•••							
Septic			Lateral		Pit Privy			tock Pens	Insecticide	_				
Sewer			Cess P		Sewage Lag	oon		Storage		d Water Well				
==	ight Sewer Lin	es	Seepag	e Pit	Feedyard		Fertil	izer Storage	Oil Well /	Gas Well				
Direction from	(Specity) well? W-SW			***************************************	Distance from		35		ft					
10 FROM	TO		1.17	rhologi	***	1 Well: ~.	FROM	ТО	I	DI I 100	IC INTERNAL : C			
0	10	Topsoil	LI	HOLOGI	CLOU		UNUM	ТО	LITHO. LOG (co	nt.) or PLUGGIN	G INTERVALS			
11_	2		ge gravel											
2	5	Clay												
5 8	8	Silty clay Clay												
10	12	Silty clay												
12	15	Clay Notes: KDHE ID: Leavenworth County Cooperative Association; U4-052-15271												
15	15 19 Silty clay Target of monitoring well is shallow groundwater, <20' of grout was installed at								was installed at					
the direction of KDHE. CONTRACTOR'S OR LANDOWNER'S CERTIFICATION: This water well was X constructed														
CONTRACTOR'S OR LANDOWNER'S CERTIFICATION: This water well was X constructed, reconstructed plugged under my jurisdiction and was completed on (mo-day-year) 6/16/21 and this record is true to the best of my knowledge and belief kansas Weet kell contractor's														
License No 757 This Water Well Record was completed on (mo-day-year) 7/8/21														
under the b	usiness name o		en & Associat	es, Inc.				Signature	\L	91				
									nent, Bureau of Weier		-			
Visit us a	1000 SW J at http://www.kd					to water wi	en Owner and	retain one for yo	ur récords. Telephone		17/10/2015			
	1111111									1407 1300				

DENNIS L HANDKE

1820 NW 59th Terrace TOPEKA, KANSAS 66618 785-286-4047 Home 785-286-1990 Fax

Jess Chapman Larsen & Assoc. 1311 E. 25th St., Suite B Topeka, Kansas 66046 June 28, 2021

RE: Monitor Well Elevation Survey 1205 N. Main, Lansing, Kansa

Proj. 21-00T Leavenworth County Cooperative Association KDHE ID U4-052-15271


Bench Mark: Chisled square on SW corner of concrete storm sewer inlet near the SE corner of property. Elev.: 841.16 North 2775.65 West 35.89 (from SE Cor. Sec. 13-9-22E)

MW-1	rim	840.68		2758.40	SE1/4,SE1/4,SE1/4,NE1/4
	top pipe	840.31	West	106.96	Lat = 39.26729 Long = 94.90024
MW-2	rim	840.63	North	2719.49	SE1/4,SE1/4,SE1/4,NE1/4
	top pipe	840.16	West	151.84	Lat = 39.26720 Long = 94.90040
MW-3	rim	836.82	North	2742.58	SE1/4,SE1/4,SE1/4,NE1/4
1,11, 5	top pipe	836.53	West	232.06	Lat = 39.26725 Long = 94.90069
3.4777.4		0.41 50	37 .1	0010.05	CP1 14 CP
MW-4	rim	841.78	North	2819.85	SE1/4,SE1/4,NE1/4
	top pipe	841.40	East	65.34	Lat = 39.26745 Long = 94.90010
MW-5	rim	843.32	North	2911.24	SE1/4,SE1/4,SE1/4,NE1/4
	top pipe	843.06	West	65.04	Lat = 39.26770 Long = 94.90010
MW		0.41 55	Mandle	2751 74	CE1/4 CE1/4 CE1/4 NE1/4
MW-6	rim .	841.55		2751.74	SE1/4,SE1/4,SE1/4,NE1/4
	top pipe	841.00	West	73.21	Lat = 39.26727 Long = 94.90012
MW-7	rim	833.52	North	2576.09	NE1/4,NE1/4,NE1/4,SE1/4
	top pipe	833.17	West	92.35	Lat = 39.26678 Long = 94.90020
MW-8	rim	841.29	North	2840.25	SE1/4,SE1/4,SE1/4,NE1/4
141 44 -0					The state of the s
	top pipe	841.05	East	261.82	Lat = 39.26751 Long = 94.90079
MW-9	rim	824.26	North	2590.42	NW1/4,NE1/4,NE1/4,SE1/4
	top pipe	823.77	West	386.90	Lat $= 39.26683$ Long $= 94.90124$

Lat & Long derived from Leavenworth 7.5' quad map. WGS84.

Elevation derived from City of Lansing. NAVD 88.

If you have any questions, please feel free to call me. Thank you for the opportunity to be

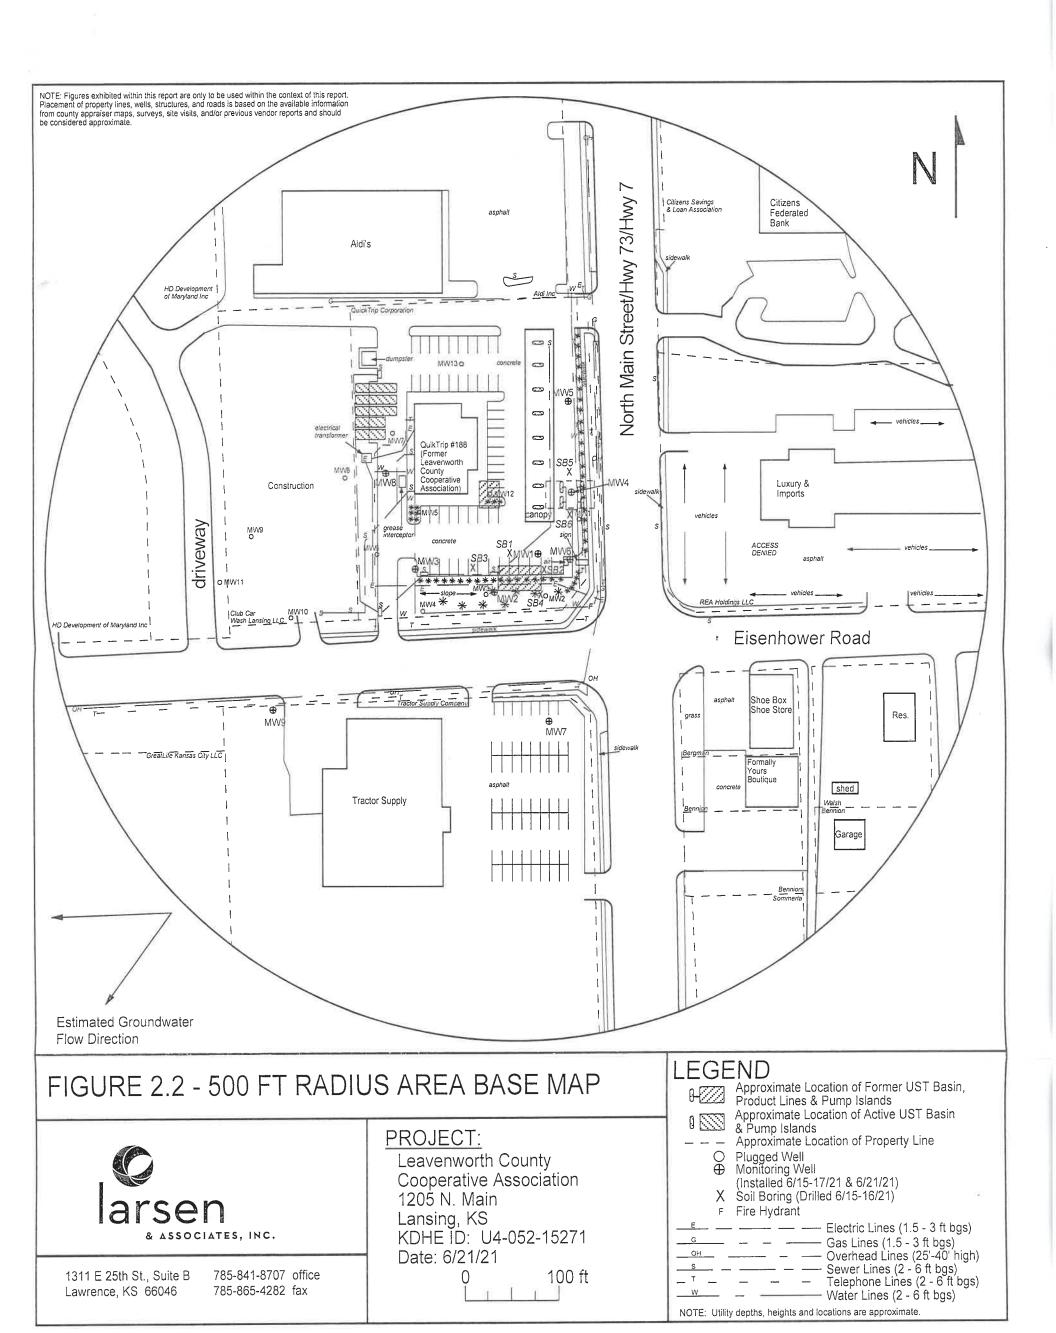

RECEIVED

AUG 0 6 2021