

WATER WELL RECORD Form WWC-5

Original Record Correction Change in Well Use

Division of Water Resources App. No.

Well ID

MW13

1 LOCATION OF WATER WELL: County: Riley Fraction NW 1/4 SW 1/4 SW 1/4 NW 1/4 Section Number 19 Township Number T 9 S Range Number R 8 E W

2 WELL OWNER: Last Name: First: Business: Kansas Dept. of Wildlife & Parks (KDWP) Address: 5800A River Pond Rd. City: Manhattan State: KS ZIP: 66502 Street or Rural Address where well is located

3 LOCATE WELL WITH 'X' IN SECTION BOX: N W E S 1 mile. 4 DEPTH OF COMPLETED WELL: 15 ft. 5 Latitude: 39.25647 Longitude: 96.57825

7 WELL WATER TO BE USED AS: 1. Domestic: 2. Irrigation 3. Feedlot 4. Industrial 5. Public Water Supply 6. Dewatering 7. Aquifer Recharge 8. Monitoring: well ID MW13 9. Environmental Remediation 10. Oil Field Water Supply 11. Test Hole 12. Geothermal 13. Other

Was a chemical/bacteriological sample submitted to KDHE? Water well disinfected?


8 TYPE OF CASING USED: Steel PVC Other CASING JOINTS: Glued Clamped Welded Threaded Casing diameter 2 in. to 5 ft. TYPE OF SCREEN OR PERFORATION MATERIAL: Steel Stainless Steel Fiberglass PVC Other SCREEN OR PERFORATION OPENINGS ARE: Continuous Slot Mill Slot Gauze Wrapped Torch Cut Drilled Holes Other Louvered Shutter Key Punched Wire Wrapped Saw Cut None

9 GROUT MATERIAL: Neat cement Cement grout Bentonite Other Grout Intervals: From 0.5 ft. to 2 ft. From 2 ft. to 4 ft. From 4 ft. to 15 ft.

Nearest source of possible contamination: Septic Tank Lateral Lines Pit Privy Livestock Pens Insecticide Storage Sewer Lines Cess Pool Sewage Lagoon Fuel Storage Abandoned Water Well Watertight Sewer Lines Seepage Pit Feedyard Fertilizer Storage Oil Well/Gas Well

Table with columns: 10 FROM, TO, LITHOLOGIC LOG, FROM, TO, LITHO. LOG (cont.) or PLUGGING INTERVALS. Row 1: 0, 1, Topsoil, silty clay loam, dk. brown. Row 2: 1, 15, Silty Clay (CL), dk. brown.

11 CONTRACTOR'S OR LANDOWNER'S CERTIFICATION: This water well was constructed, reconstructed, or plugged under my jurisdiction and was completed on (mo-day-year) 8-29-16 and this record is true to the best of my knowledge and belief. Kansas Water Well Contractor's License No. 585. This Water Well Record was completed on (mo-day-year) 8-12-16 under the business name of Associated Environmental, Inc. Signature

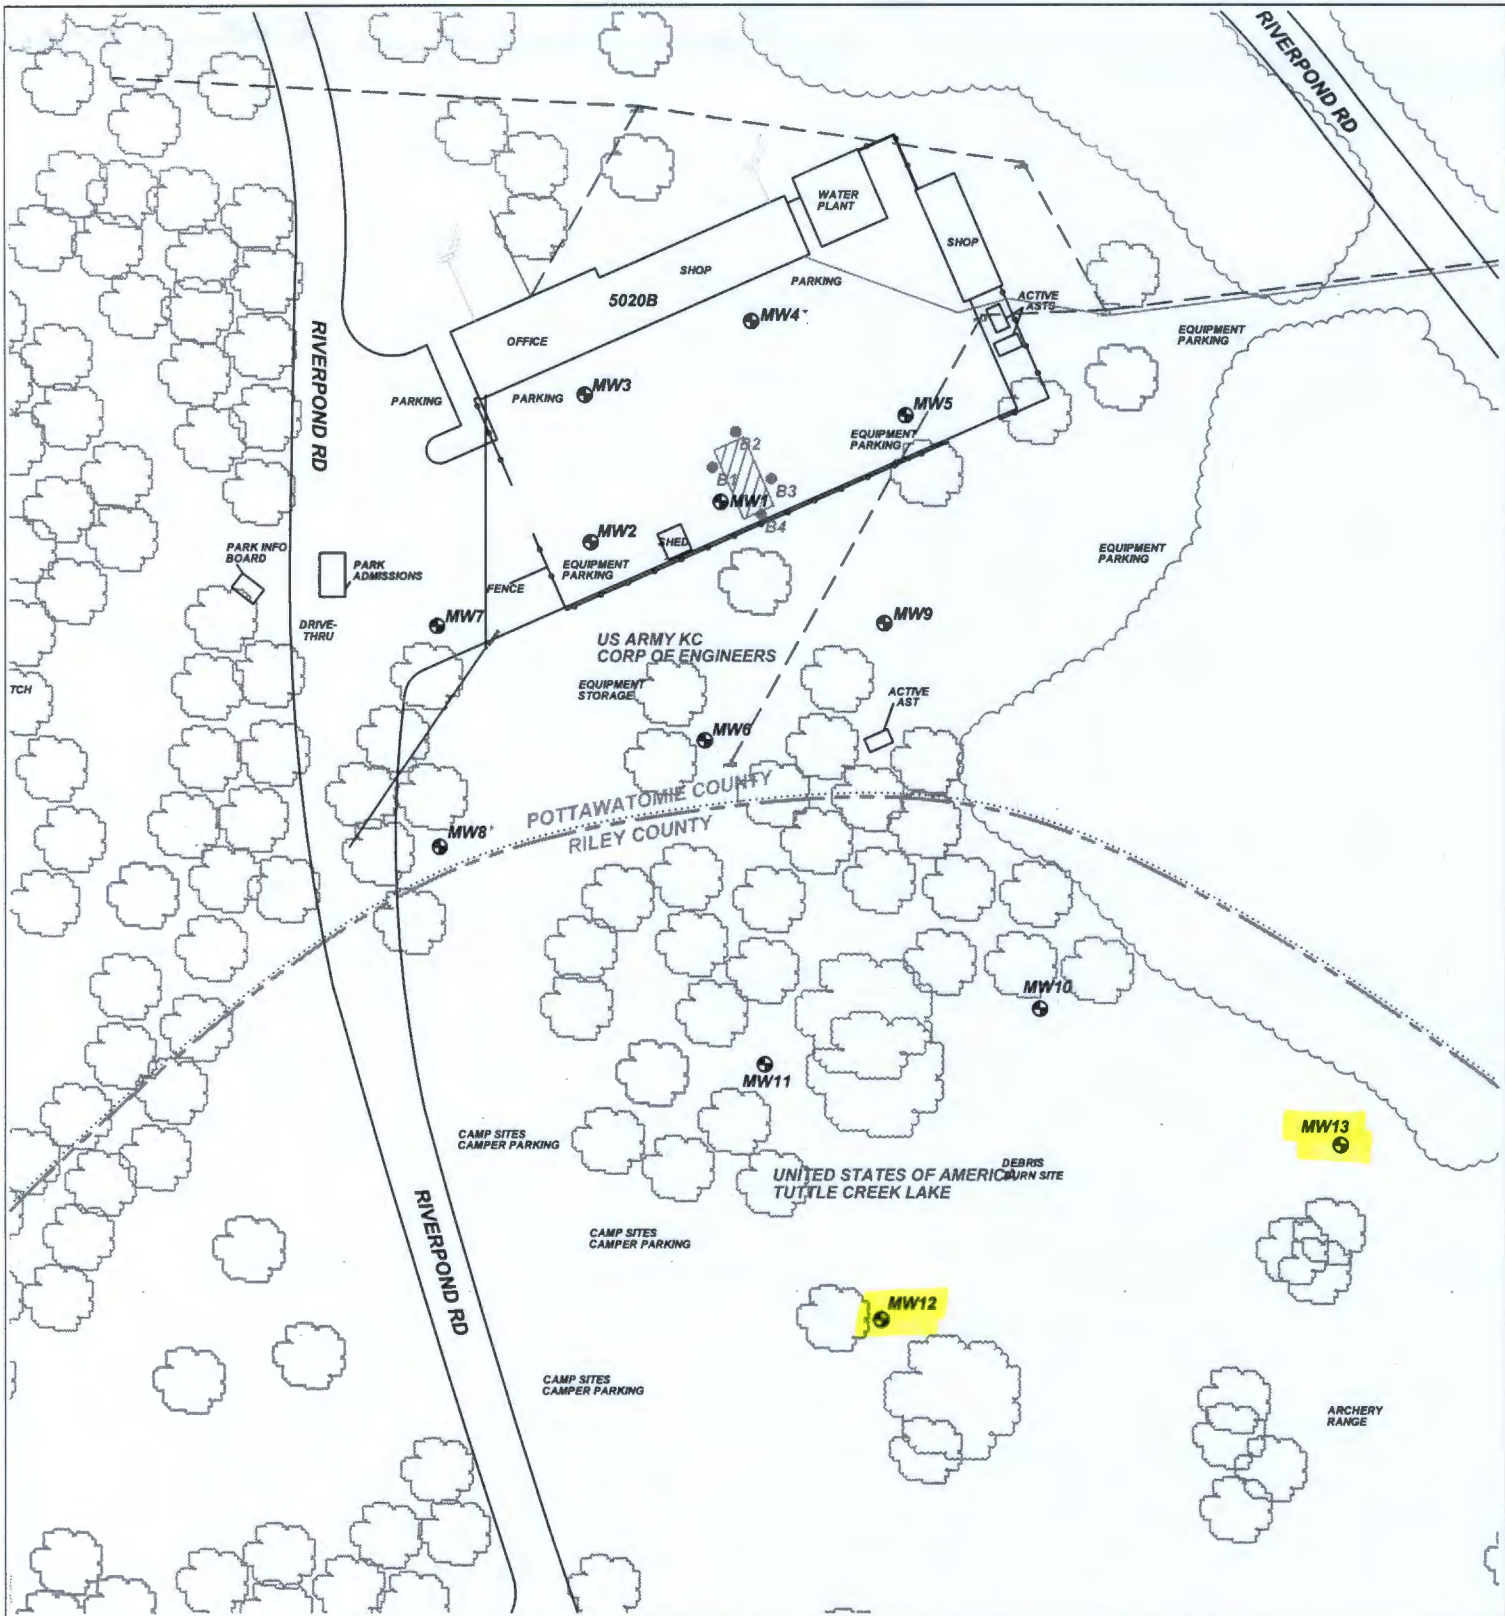

PROJECT: **TUTTLE CREEK STATE PARK**

ADDRESS: **5800A RIVER POND RD**

LOCATION: **MANHATTAN, KS**

DRAWN BY: **C. ROE** DATE: **10/19/15**

REVISED BY: **S. JOHNSON** DATE: **10/12/16**

AEI JOB #: **TF486** KDHE JOB #: **U5-081-00852**

TITLE: **Figure 2.1  
Site Map  
350' Radius**

**AEI ASSOCIATED ENVIRONMENTAL INC.**

- LEGEND:
- = Former UST Excavation Location  
1-1,000 g. gasoline, 1-1,000 g. diesel
  - = Monitor Well
  - = Soil Boring Location
  - = Site Property Boundary
  - = Parcel Boundary Lines
  - = Overhead Electric (15-25')
  - = Buried Water (3-6')
  - = Buried Propane (2-4')
  - = Buried Sewer (2-12')
  - = Buried Cable (2-5')

SCALE: **1" = 100'**

NOTES: \* Indicates boring for unsaturated and saturated zone hydrologic data.  
No basements observed within 500'.