
WATE	ER WELI	RECORD		WWC-5		Division of	Water					
Orig	inal Record	Correction	☐ Chan	ge in Well Use		Resources A			Well ID			
1 LOC	inty: Ottawa	WATER WEI	LL:	Fraction		Section N	umber	Township Numbe		nge Number		
		Last Name: Cro		SE 1/4 NW 1/4 NE		26		T 11 S	R 2	E W		
Busine	ESS:	Last Name: Cro	ouse	First: Bruce	Street or	Rural Add	ress who	ere well is located (if unknown	, distance and		
The second	Address: 749 N. 230th Road						direction from nearest town or intersection): If at owner's address, check here:					
	Address:						5 mi. E and 2.5 mi. N of Bennington					
City: Solomon State: KS ZIP: 67480												
	ATE WELL	4 DEPTH	OF COM	APLETED WELL:	74.5	0	w.w ==	20.00570				
0.00	I "X" IN	Depth(s) Gr	nundwater		5 Latitude: 39.06570 (decimal degrees)							
SECT	SECTION BOX: Depth(s) Groundwater Encountered: 1)						(decimal degrees					
	WELL'S STATIC WATER LEVEL: 26						16 1 NAD 65 LI N					
	below land surface, measured on (mo-day-yr). 4/17/20 Source for Latitude/Longitude:						
NW	NW NE Dabove land surface, measured on (mo-day-yr)						(WAAS enabled? ☐ Yes ☐ No)					
	Pump test data: Well water wasft.						☐ Land Survey ☐ Topographic Map					
W	E after hours pumping						Online Mapper: Google Earth					
SW	SW SE Well water was ft.											
	after hours pumping gpm Estimated Yield:gpm						6 Flavotion:					
	S Bore Hole Diameter:9 in. to75					ft. and 6 Elevation:ft. ☐ Ground Level ☐ To Source: ☐ Land Survey ☐ GPS ☐ Topographic M				Level TOC		
	1 mile in. to					3		Other	S □ 10	pographic Map		
7 WELI	WATER	TO BE USED A	S:		11.			Other				
1. Domest	ic:			ter Supply: well ID		10 [7 Oil Ein	14 W-+ C 1 1				
	Domestic: 5. ☐ Public Water Supply: well ID											
	Lawn & Garden 7. Aquifer Recharge: well ID						☐ Cased ☐ Uncased ☐ Geotechnical					
	☐ Livestock 8. ☐ Monitoring: well ID						12. Geothermal: how many bores?					
	2. \square Irrigation 9. Environmental Remediation: well ID						a) Closed Loop Horizontal Vertical					
A D Tallow 1.1						ł	b) Open Loop ☐ Surface Discharge ☐ Inj. of Water					
			Recovery	☐ Injection		13. Г	Other (specify).				
Was a chemical/bacteriological sample submitted to KDHE? ☐ Yes ■ No If yes, date sample was submitted:												
	TI GIDIIII COLO	4. 110	NO									
8 TYPE OF CASING USED: Steel PVC Other CASING JOINTS: Glued Clamped Welded Threaded												
Casing diameter 5 in to 39.5 ft., Diameter 5 in to 74.5 ft., Diameter in to 15 in to 16. Weight 16.												
Casing height above land surface 15 in. Weight lbs./ft. Wall thickness or gauge No. 160.lb. TYPE OF SCREEN OR PERFORATION MATERIAL:												
Steel Steinland												
☐ Brass ☐ Galvanized Steel ☐ Concrete tile ☐ None used (open hole)												
SCREEN OR PERFORATION OPENINGS ARE:												
Continuous Slot Mill Slot D Course Warrand D To 1 Co T D W 1												
Continuous Slot Mill Slot Gauze Wrapped Torch Cut Drilled Holes Other (Specify) Louvered Shutter Key Punched Wire Wrapped Screen-Perforated Intervals: From 39.5 ft. to 69.5 ft., From ft. to ft.												
SCREEN-	-PERFORA	ΓED INTERVA	LS: From	.39.5 ft. to 69.5	ft From	tione (Ope	t to	f From	0	2		
GRAVEL PACK INTERVALS: From												
9 GROU	T MATERI	AL: Neat ce	ment \square	Cement grout Re	ntonite \square	Other	1. 10	It., From	It. to	ft.		
Grout Inter	vals: From .	ft. to .	22.5	ft., From	ft. to	ft Fro		ft to	Α	• • • • • • • • • • • • • • • • • • • •		
	aree or bogge	ore containination	1:			10., 110	JIII	16. 10	It.			
☐ Septic	lank		iteral Lines			Livestock	Pens	☐ Insecticide	Storage			
	tight Sewer L		ess Pool	☐ Sewage Lag		Fuel Stora		☐ Abandone		ell		
Other	(Specify) N	one Known	epage Pit	☐ Feedyard		Fertilizer	Storage	☐ Oil Well/C	as Well			
Other (Specify) None Known Direction from well? Distance from well? ft.												
10 FROM	ТО	1.1	THOLOG	CLOC	EDOM	T TO	T 7000	ft.				
0	3	Clay, Brown	LIGHTON	C LOG	FROM	ТО	LITH	O. LOG (cont.) or PL	UGGING	INTERVALS		
3	11	Clay, Yellow to	Yellow	Brown								
11	27	Clay, Gray to	Dark Gray	/ JOWII		-						
27	39	Shale, wthrd.,	Grav				+					
39	57	Shale, Gray, w		nsum			+					
57	62	Sandstone, vf-	f grained	Journ			+					
62	67.5	Shale, Gray	granieu		Notes:				-			
67.5	75	Shale, Red mo	ottled I + 4	Grav	notes:							
11 CONTRACTOR'S OR LANDOWNER'S CERTIFICATION: This water well was constructed, reconstructed, or plugged under my jurisdiction and was completed on (mo day veer) 4/17/2020												
under my jurisdiction and was completed on (mo-day-year) .4/17/2020 and this record is true to the best of my knowledge and belief. Kansas Water Well Contractor's License No. 527 This Water Well Record was completed on (mo-day-year) .4/20/2020 under the business name of .GeoCore, LLC												
1000	3 W Jackson S	i., Suite 420, Topek	a, Kansas 66	612-1367. Mail one to W	ater Well Ow	ner and retain	n one for y	our records. Telephone	785-296-552	24.		
Visit us at http://www.kdheks.gov/waterwell/index.html KSA 82a-1212 Revised 7/10/2015												

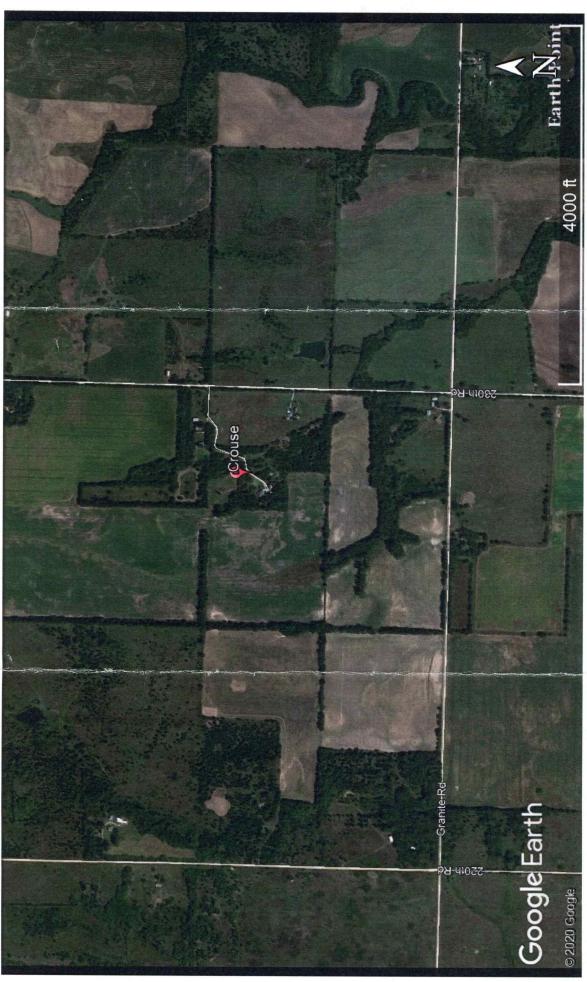

MAY 1 5 2020 BUREAU OF WATER

Domestic Well – Lawn and Garden Bruce Crouse, 5 mi. E and 2.5 mi. N of Bennington GPS Coordinates:

Crouse well: 39.06570, -97.50454