

WATER WELL RECORD Form WWC-5

Division of Water Resources App. No.

Well ID MW8

Original Record Correction Change in Well Use

1 LOCATION OF WATER WELL: County: ELLIS	Fraction SE ¼ SW ¼ NE ¼ SW ¼	Section Number 5	Township Number T 13 S	Range Number R 20 <input type="checkbox"/> E <input checked="" type="checkbox"/> W
--	---------------------------------	----------------------------	----------------------------------	--

2 WELL OWNER: Last Name: Haney First: Gerald Business: Love's Travel Shops Address: 10601 N. Pennsylvania Address: City: Oklahoma City State: OK ZIP: 73120	Street or Rural Address where well is located (if unknown, distance and direction from nearest town or intersection): If at owner's address, check here: <input type="checkbox"/> 200 Washington St. Ellis, KS 67637
---	--

3 LOCATE WELL WITH "X" IN SECTION BOX:

N

NW	NE
SW	SE

S

W E

1 mile

4 DEPTH OF COMPLETED WELL: **50** ft.

Depth(s) Groundwater Encountered: 1) **41** ft.
2) ft. 3) ft., or 4) Dry Well

WELL'S STATIC WATER LEVEL: **42.09** ft.
 below land surface, measured on (mo-day-yr) **3/24/21**
 above land surface, measured on (mo-day-yr)

Pump test data: Well water was ft.
after hours pumping gpm
Well water was ft.
after hours pumping gpm

Estimated Yield: gpm
Bore Hole Diameter: **8.5** in. to **50** ft. and
..... in. to ft.

5 Latitude: **38.94713** (decimal degrees)
Longitude: **99.56062** (decimal degrees)
Horizontal Datum: WGS 84 NAD 83 NAD 27
Source for Latitude/Longitude:
 GPS (unit make/model:)
(WAAS enabled? Yes No)
 Land Survey Topographic Map
 Online Mapper:

6 Elevation: **2136.53** ft. Ground Level TOC
Source: Land Survey GPS Topographic Map
 Other

7 WELL WATER TO BE USED AS:

1. Domestic: <input type="checkbox"/> Household <input type="checkbox"/> Lawn & Garden <input type="checkbox"/> Livestock	5. <input type="checkbox"/> Public Water Supply: well ID 6. <input type="checkbox"/> Dewatering: how many wells? 7. <input type="checkbox"/> Aquifer Recharge: well ID 8. <input checked="" type="checkbox"/> Monitoring: well ID MW8	10. <input type="checkbox"/> Oil Field Water Supply: lease 11. Test Hole: well ID <input type="checkbox"/> Cased <input type="checkbox"/> Uncased <input type="checkbox"/> Geotechnical
2. <input type="checkbox"/> Irrigation	9. Environmental Remediation: well ID <input type="checkbox"/> Air Sparge <input type="checkbox"/> Soil Vapor Extraction <input type="checkbox"/> Recovery <input type="checkbox"/> Injection	12. Geothermal: how many bores? a) Closed Loop <input type="checkbox"/> Horizontal <input type="checkbox"/> Vertical b) Open Loop <input type="checkbox"/> Surface Discharge <input type="checkbox"/> Inj. of Water
3. <input type="checkbox"/> Feedlot		13. <input type="checkbox"/> Other (specify):
4. <input type="checkbox"/> Industrial		

Was a chemical/bacteriological sample submitted to KDHE? Yes No If yes, date sample was submitted:

Water well disinfected? Yes No

8 TYPE OF CASING USED: Steel PVC Other CASING JOINTS: Glued Clamped Welded Threaded

Casing diameter **2** in. to **50** ft., Diameter in. to ft., Diameter in. to ft.
Casing height above land surface in. Weight lbs./ft. Wall thickness or gauge No. **Sch 40**

TYPE OF SCREEN OR PERFORATION MATERIAL:
 Steel Stainless Steel Fiberglass PVC Other (Specify)
 Brass Galvanized Steel Concrete tile None used (open hole)

SCREEN OR PERFORATION OPENINGS ARE:
 Continuous Slot Mill Slot Gauze Wrapped Torch Cut Drilled Holes Other (Specify)
 Louvered Shutter Key Punched Wire Wrapped Saw Cut None (Open Hole)

SCREEN-PERFORATED INTERVALS: From **35** ft. to **50** ft., From ft. to ft., From ft. to ft.
GRAVEL PACK INTERVALS: From **33** ft. to **35** ft., From ft. to ft., From ft. to ft.

9 GROUT MATERIAL: Neat cement Cement grout Bentonite Other **Concrete Surface Completion 0 - 1**

Grout Intervals: From **1** ft. to **33** ft., From ft. to ft., From ft. to ft.


Nearest source of possible contamination:
 Septic Tank Lateral Lines Pit Privy Livestock Pens Insecticide Storage
 Sewer Lines Cess Pool Sewage Lagoon Fuel Storage Abandoned Water Well
 Watertight Sewer Lines Seepage Pit Feedyard Fertilizer Storage Oil Well/Gas Well
 Other (Specify)

Direction from well? **North** Distance from well? **250** ft.


10 FROM	TO	LITHOLOGIC LOG	FROM	TO	LITHO. LOG (cont.) or PLUGGING INTERVALS
0	0.5	Concrete (8")			
1	32	Silty Clay (CL), brown			
32	34	Sandy Clay (SC), brown			
34	50	Silty Clay (CL), brown			

Notes: KDHE Storage Tanks (LUST) LSA Addendum Project
Love's Travel Stop #455, U6-026-15219, Ellis

11 CONTRACTOR'S OR LANDOWNER'S CERTIFICATION: This water well was constructed, reconstructed, or plugged under my jurisdiction and was completed on (mo-day-year) **3/16/21** and this record is true to the best of my knowledge and belief. Kansas Water Well Contractor's License No. **585** This Water Well Record was completed on (mo-day-year) **4/17/21** under the business name of **Associated Environmental, Inc.** Signature

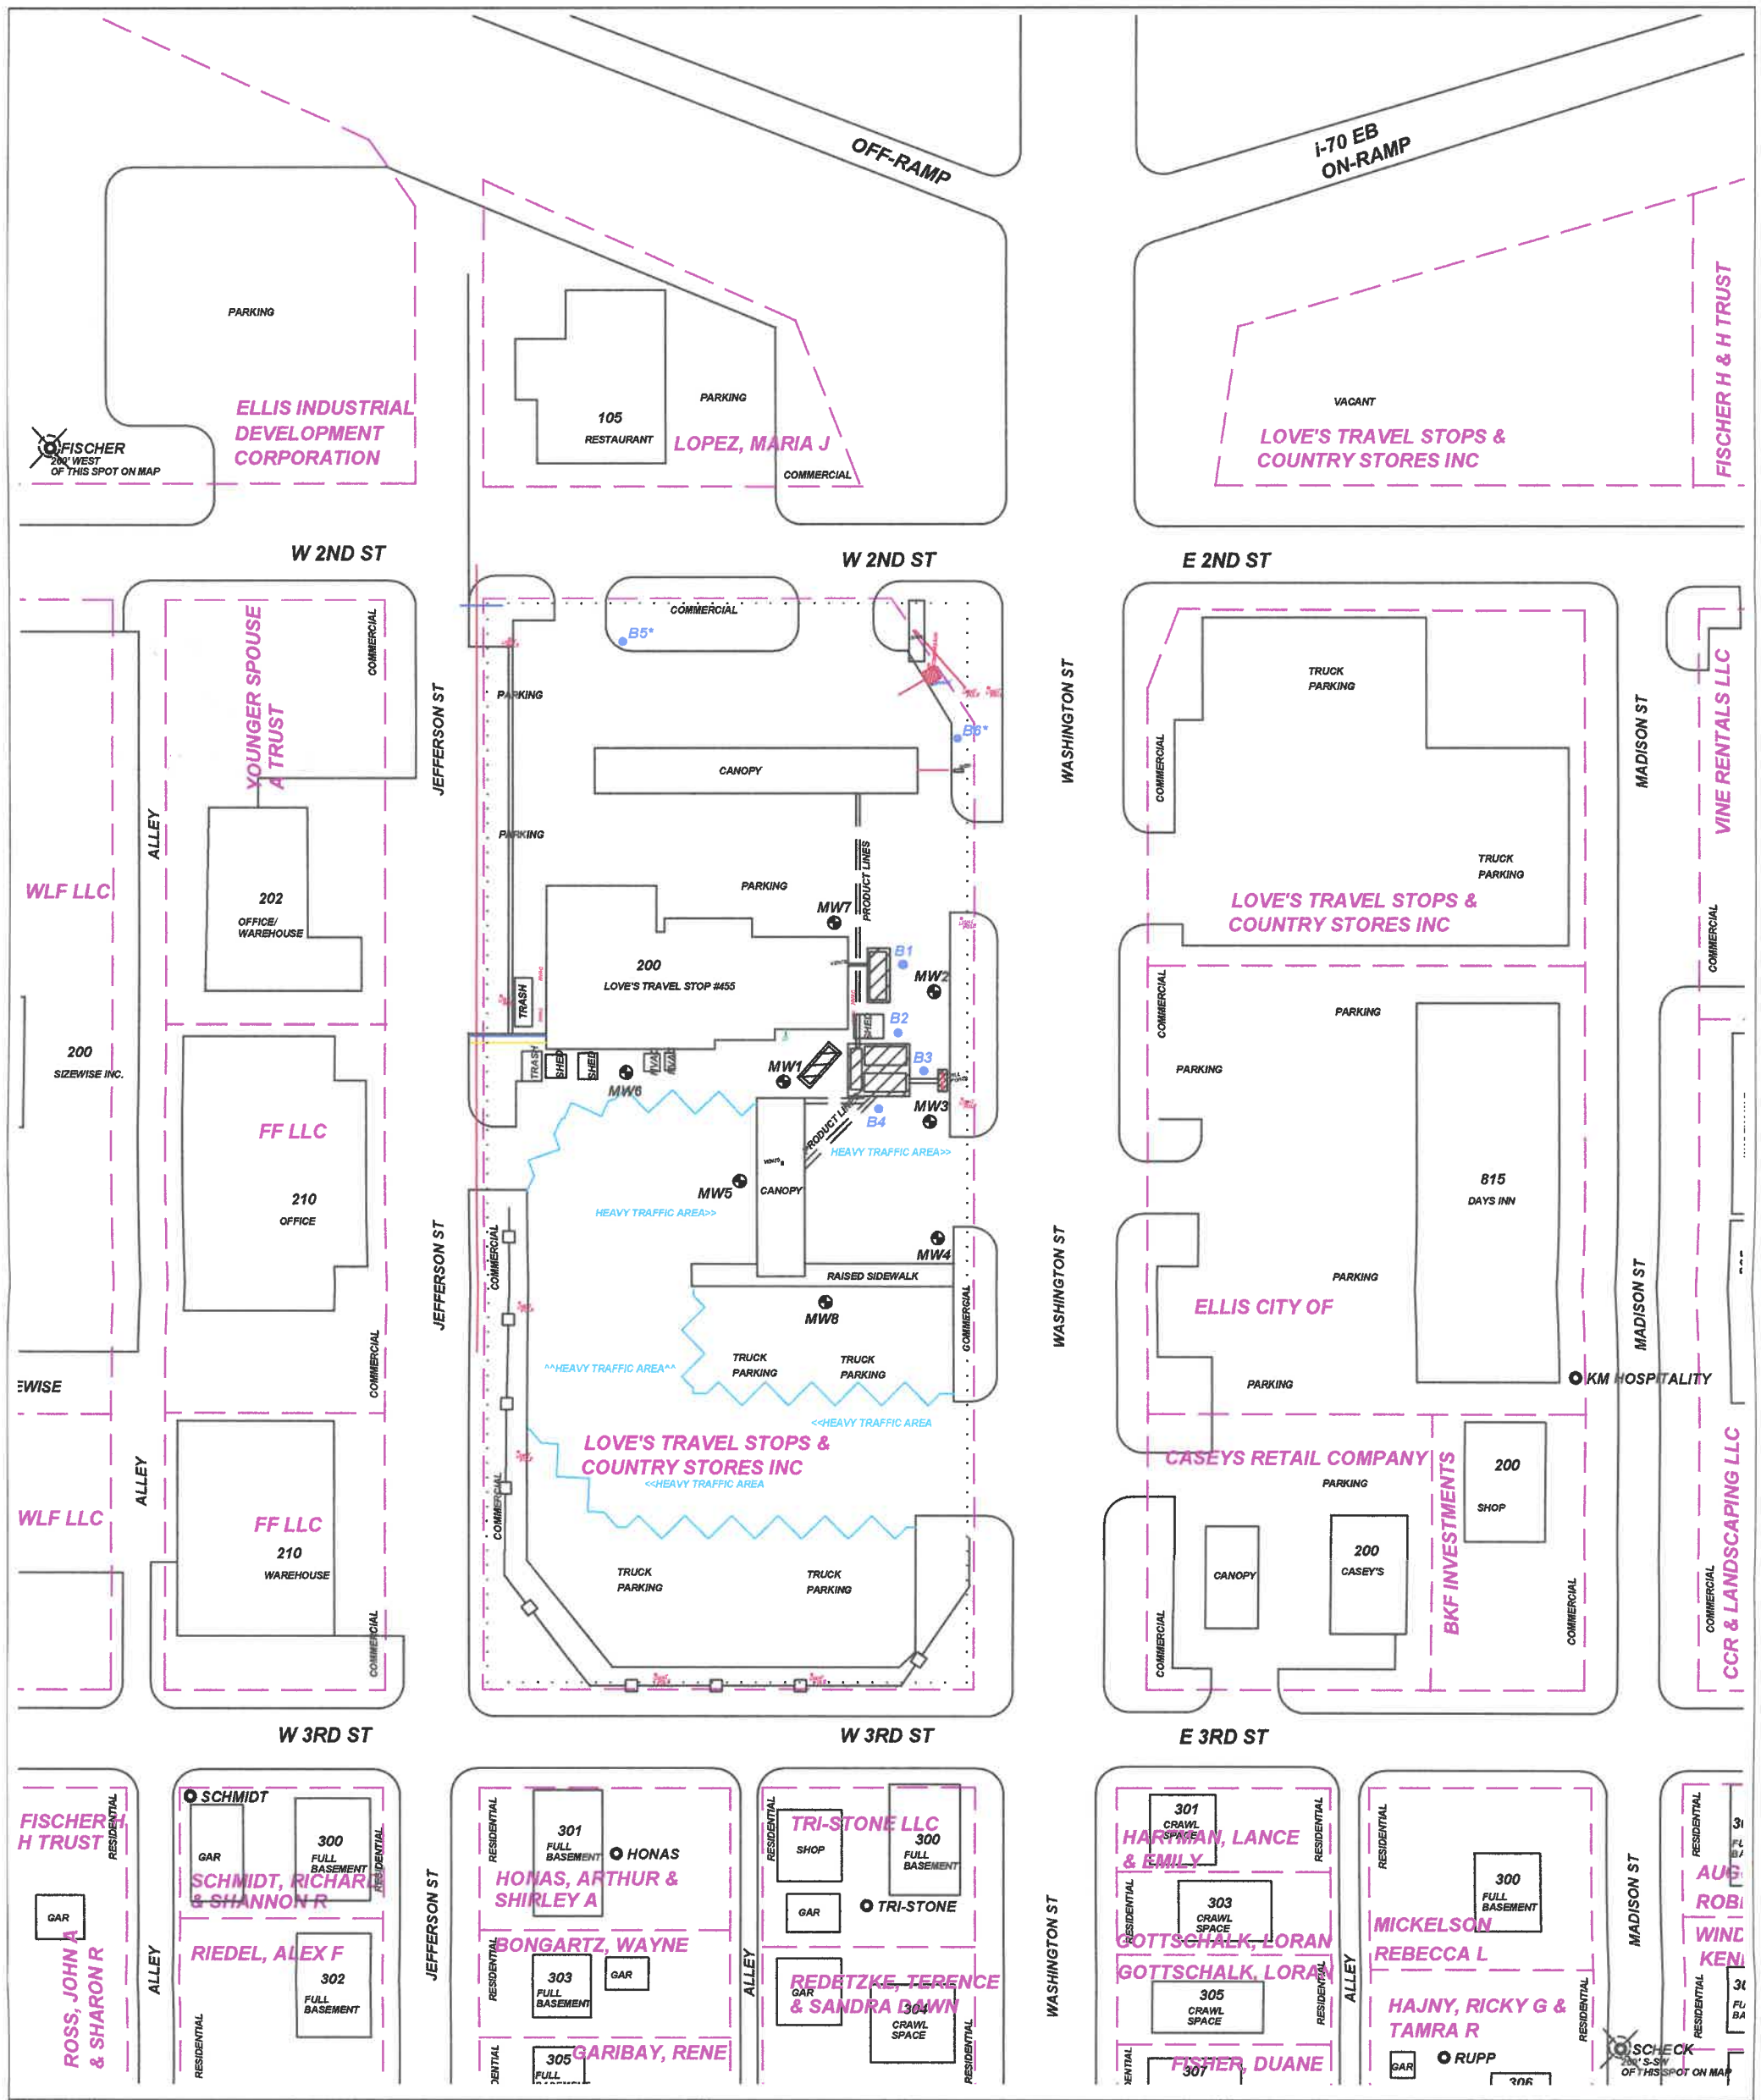

PROJECT: LOVE'S TRAVEL STOP #455
ADDRESS: 200 WASHINGTON STREET
LOCATION: ELLIS, KS
DRAWN BY: C. ROE **DATE:** 1/12/21
REVISED BY: C. ROE **DATE:** 4/2/21
AEI JOB #: TF531 **KDHE JOB #:** U6-026-15219
SCALE: 1" = 100'
 0 50 100

TITLE: FIGURE 2.2
 AREA BASE MAP
 500' RADIUS

ASSOCIATED ENVIRONMENTAL INC.

NOTES: Owner name/well id for domestic wells is the last name listed on the WWC5 form, but may not represent current property owners last name at each location.
 * = Indicates boring for unsaturated and saturated zone hydrologic data.

- LEGEND:**
- = 1-20,000 G UNLEADED, 1-8,000 G DEF, 2-20,000 G DIESEL, PRODUCT LINES, VENT LINES, & FILL PORT
 - = MONITORING WELL
 - = DOMESTIC WELL (OWNER NAME)
 - = SOIL BORING
 - = SUBJECT PROPERTY
 - = PARCEL BOUNDARY
 - = OVERHEAD ELECTRIC (10-25')
 - = BURIED ELECTRIC (2-5')
 - = BURIED WATER (3-6')
 - = BURIED GAS (2-4')
 - = BURIED SEWER (2-12')
 - = BURIED CABLE (2-5')