

WATER WELL RECORD Form WWC-5

Original Record Correction Change in Well Use

Division of Water Resources App. No.

Blank box for App. No.


Well ID

MW6

1 LOCATION OF WATER WELL: County: ELLIS Fraction NE 1/4 SW 1/4 NE 1/4 SE 1/4 Section Number 5 Township Number T 13 S Range Number R 20 E W

2 WELL OWNER: Last Name: Haney First: Gerald Street or Rural Address where well is located: 200 Washington St. Ellis, KS 67637

3 LOCATE WELL WITH 'X' IN SECTION BOX: N

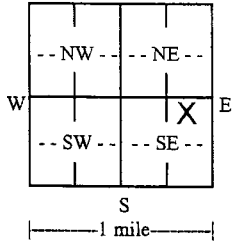

4 DEPTH OF COMPLETED WELL: 50 ft. Depth(s) Groundwater Encountered: 1) 42 ft. 2) ... ft. 3) ... ft. or 4) Dry Well WELL'S STATIC WATER LEVEL: 40.79 ft.

5 Latitude: 38.94737 (decimal degrees) Longitude: 99.56089 (decimal degrees) Horizontal Datum: WGS 84 NAD 83 NAD 27

6 Elevation: 2135.85 ft. Ground Level TOC Source: Land Survey GPS Topographic Map Other

7 WELL WATER TO BE USED AS: 1. Domestic: Household, Lawn & Garden, Livestock, Irrigation, Feedlot, Industrial. 2. Public Water Supply, Dewatering, Aquifer Recharge, Monitoring, Environmental Remediation, Air Sparge, Soil Vapor Extraction, Recovery, Injection, Oil Field Water Supply, Test Hole, Geothermal, Closed Loop, Open Loop, Surface Discharge, Inj. of Water, Other.

Was a chemical/bacteriological sample submitted to KDHE? No If yes, date sample was submitted: Water well disinfected? No


8 TYPE OF CASING USED: Steel PVC Other CASING JOINTS: Glued Clamped Welded Threaded Casing diameter 2 in. to 50 ft., Diameter in. to ft., Diameter in. to ft. Casing height above land surface in. Weight lbs./ft. Wall thickness or gauge No. Sch. 40 TYPE OF SCREEN OR PERFORATION MATERIAL: Steel Stainless Steel Fiberglass PVC Other (Specify) SCREEN OR PERFORATION OPENINGS ARE: Continuous Slot Mill Slot Gauze Wrapped Torch Cut Drilled Holes Other (Specify) Louvered Shutter Key Punched Wire Wrapped Saw Cut None (Open Hole) SCREEN-PERFORATED INTERVALS: From 35 ft. to 50 ft., From ft. to ft., From ft. to ft. GRAVEL PACK INTERVALS: From 33 ft. to 35 ft., From ft. to ft., From ft. to ft.

9 GROUT MATERIAL: Neat cement Cement grout Bentonite Other Concrete Surface Completion 0 - 1 Grout Intervals: From 1 ft. to 33 ft., From ft. to ft., From ft. to ft. Nearest source of possible contamination: Septic Tank Lateral Lines Pit Privy Livestock Pens Insecticide Storage Sewer Lines Cess Pool Sewage Lagoon Fuel Storage Abandoned Water Well Watertight Sewer Lines Seepage Pit Feedyard Fertilizer Storage Oil Well/Gas Well Other (Specify) Direction from well? West Distance from well? 210 ft.

Table with columns: FROM, TO, LITHOLOGIC LOG, FROM, TO, LITHO. LOG (cont.) or PLUGGING INTERVALS. Rows: 0-0.5 Concrete (8"), 1-32 Silty Clay (CL), brown, 32-34 Sandy Clay (SC), brown, 34-50 Silty Clay (CL), brown. Notes: KDHE Storage Tanks (LUST) LSA Addendum Project Love's Travel Stop #455, U6-026-15219, Ellis

11 CONTRACTOR'S OR LANDOWNER'S CERTIFICATION: This water well was constructed, reconstructed, or plugged under my jurisdiction and was completed on (mo-day-year) 3/16/21 and this record is true to the best of my knowledge and belief. Kansas Water Well Contractor's License No. 585 This Water Well Record was completed on (mo-day-year) 4/17/21 under the business name of Associated Environmental, Inc. Signature

Mail 1 white copy along with a fee of \$5.00 for each constructed well to: Kansas Department of Health and Environment, Bureau of Water, GWTS Section, 1000 SW Jackson St., Suite 420, Topeka, Kansas 66612-1367. Mail one to Water Well Owner and retain one for your records. Telephone 785-296-5524.

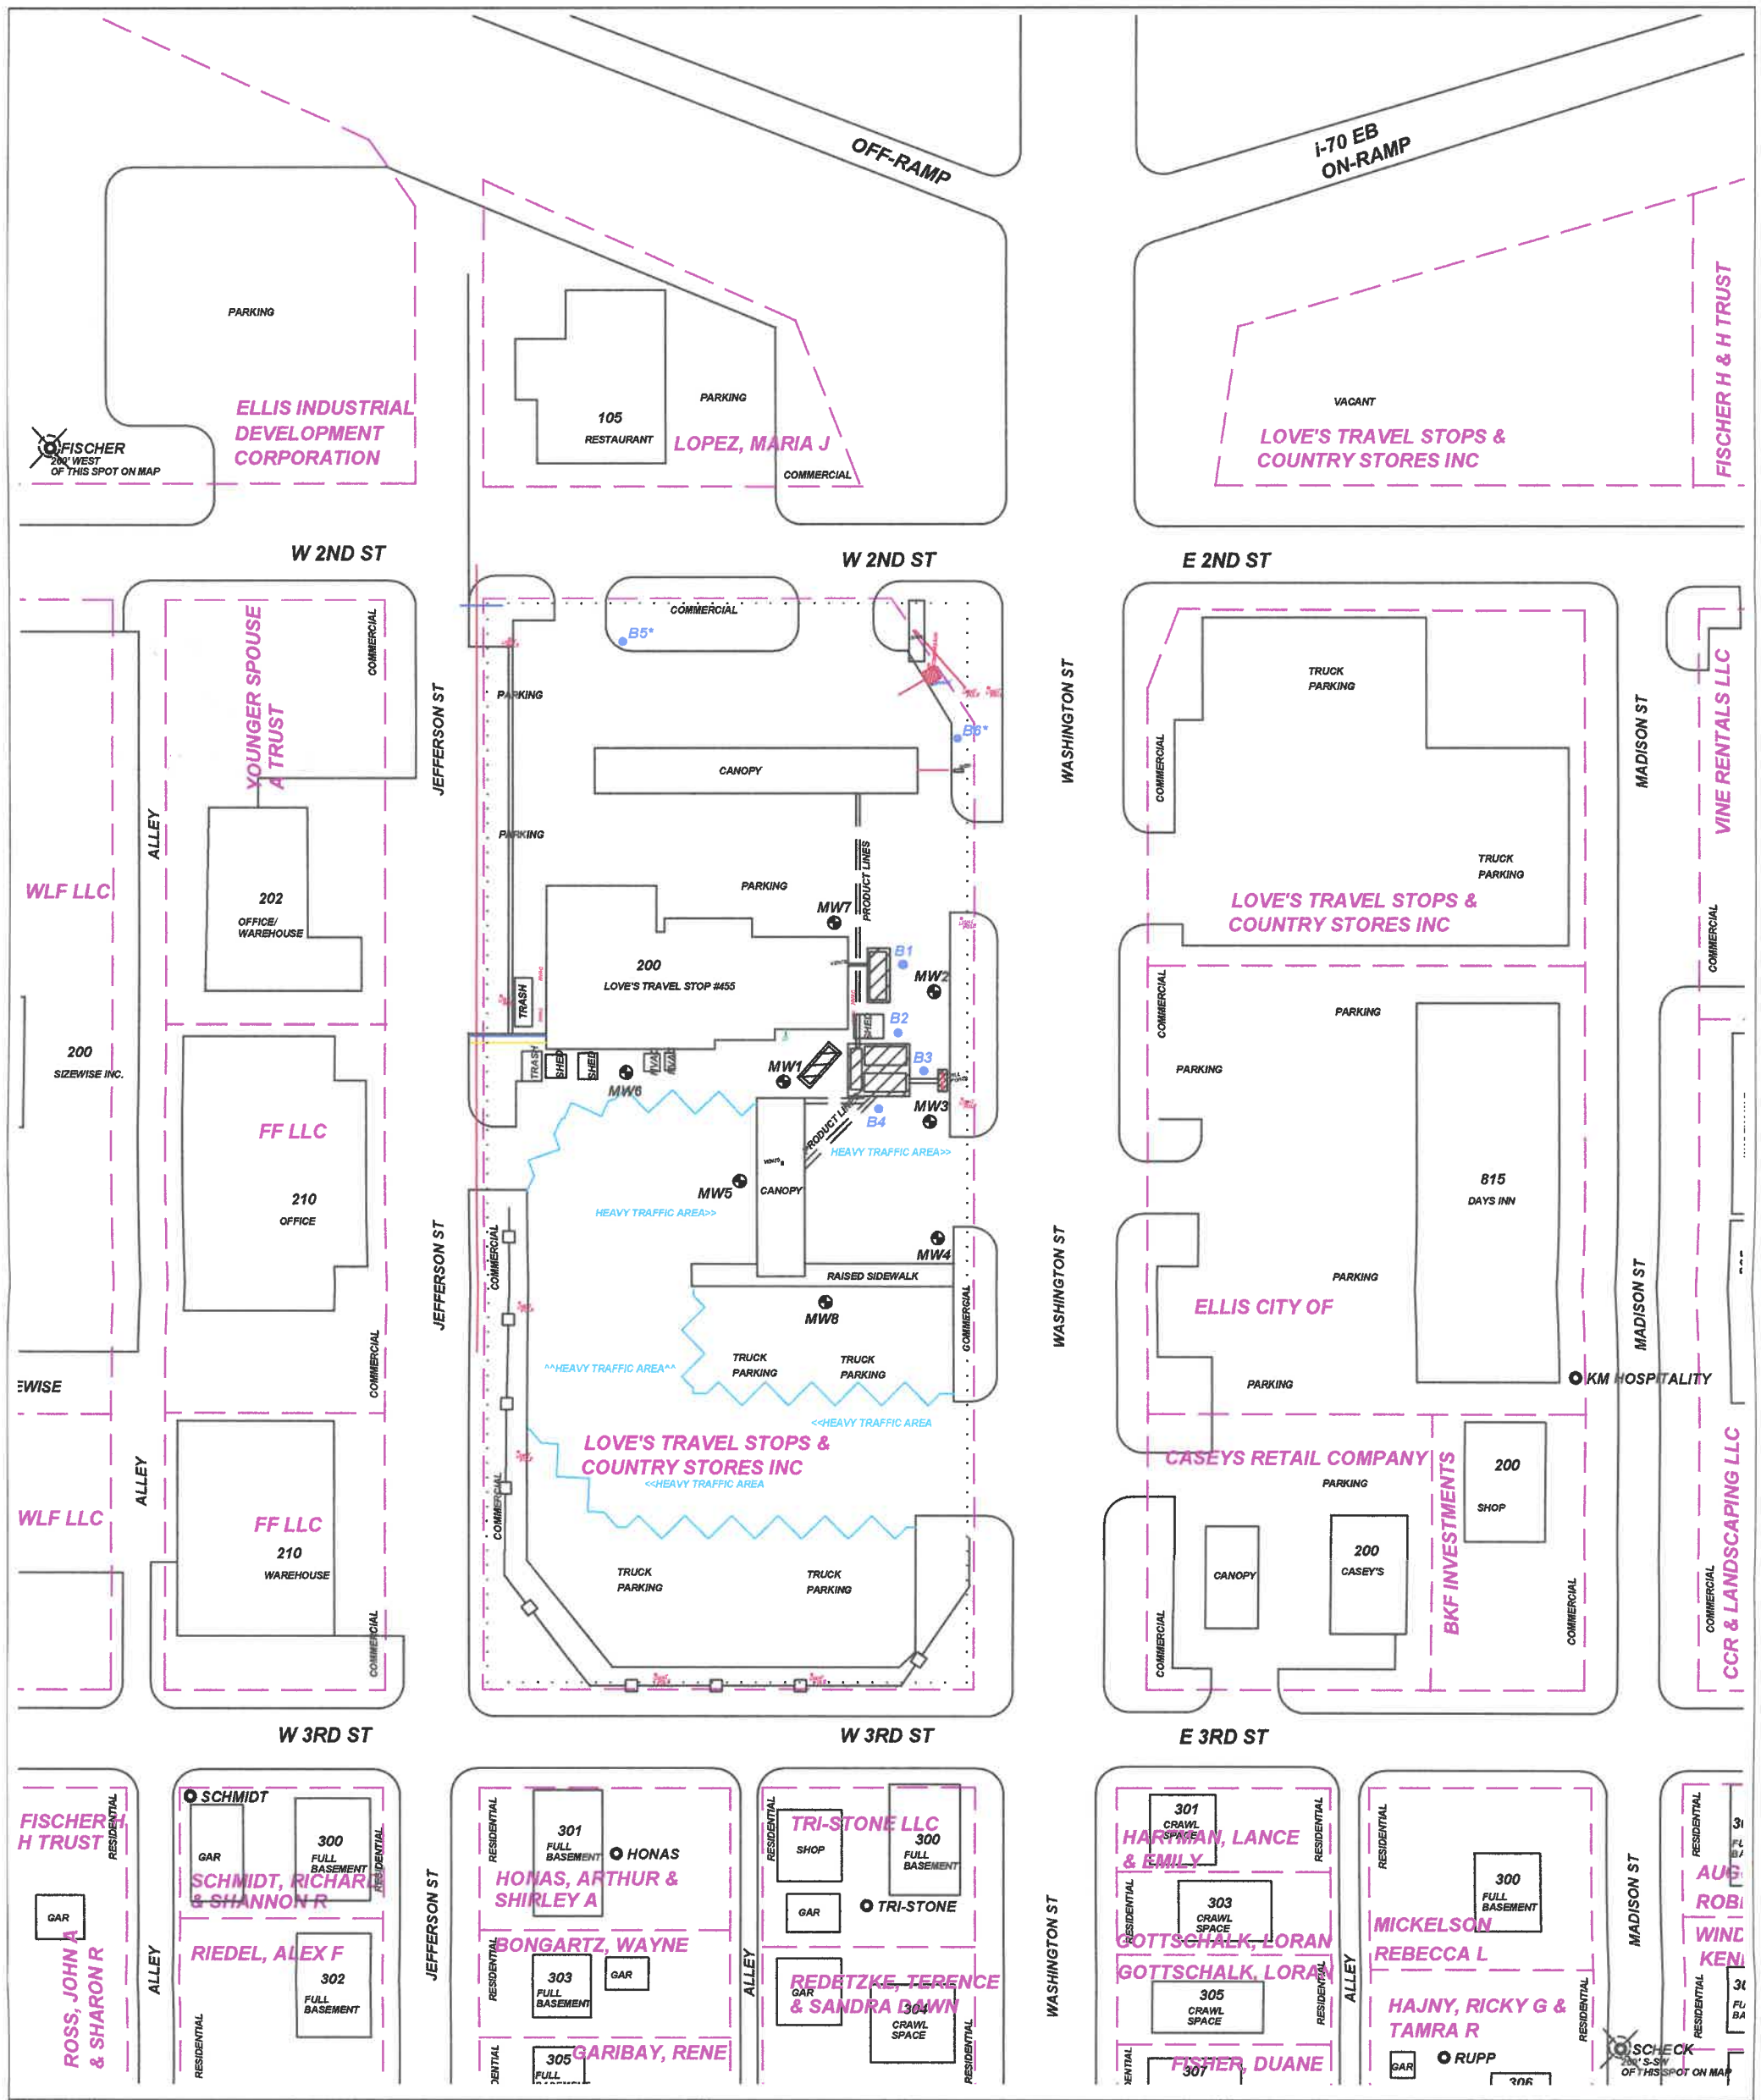

PROJECT: **LOVE'S TRAVEL STOP #455**

ADDRESS: **200 WASHINGTON STREET**

LOCATION: **ELLIS, KS**

DRAWN BY: **C. ROE** DATE: **1/12/21**

REVISED BY: **C. ROE** DATE: **4/2/21**

AEI JOB #: **TF531** KDHE JOB #: **U6-026-15219**

SCALE: **1" = 100'**

0 50 100

TITLE: **FIGURE 2.2
AREA BASE MAP
500' RADIUS**

**ASSOCIATED
ENVIRONMENTAL
INC.**

NOTES: Owner name/well id for domestic wells is the last name listed on the WWC5 form, but may not represent current property owners last name at each location.
* = Indicates boring for unsaturated and saturated zone hydrologic data.

- LEGEND:
- = 1-20,000 G UNLEADED, 1-8,000 G DEF, 2-20,000 G DIESEL, PRODUCT LINES, VENT LINES, & FILL PORT
 - = MONITORING WELL
 - = DOMESTIC WELL (OWNER NAME)
 - = SOIL BORING
 - = SUBJECT PROPERTY
 - = PARCEL BOUNDARY
 - = OVERHEAD ELECTRIC (10-25')
 - = BURIED ELECTRIC (2-5')
 - = BURIED WATER (3-6')
 - = BURIED GAS (2-4')
 - = BURIED SEWER (2-12')
 - = BURIED CABLE (2-5')