WATER WELL RECORD Form WWC-5		Division of Water						
X Original Record Correction Change in Well	Ust	Resources App. No.			Well ID	MW2		
1 LOCATION OF WATER WELL: Frac	tion		Section Number	Township Num				
County Saline NE	E ¼ NW ¼ SW ¼	SW 1/4	36	T 13	S R 3	E X W		
2 WELL OWNER: Last Name: First	Street	or Rural Ad	dress where we	ll is located (if unkn				
Business: Pilot Travel Centers LLC			or intersection)	: If at owner's add	lress, check her	re:		
Address: 5508 Lonas Dr.	1944 Nor	th 9th Street,	Salina. KS					
Address: City Knoxville State: TN ZIP:	37909							
City Knoxville State: TN ZIP:  3 LOCATE WELL 4 DEPTH OF COMPLI		ft 5	Latitude:	38.8742	28 (dec	imal degrees)		
WITH "X" IN Depth(s) Groundwater Encou	***************************************		Longitude	97.6100	)9 (dec	eimal degrees)		
SECTION BOX: 2) ft 3)	ft. or 4) Dry Well		Horizontal	Datum: X WGS 8	4 NAD 8	3 NAD 27		
N WELL'S STATIC WATER L	EVEL: 27.75 ft.		Source for	Latitude/Longitude				
X below land surface, me	easured on (mo-day-yr) 6/	/25/2018		mit make/model:		)		
NV NE				AAS enabled?				
Pump test data: Well water	***************************************							
W E after Mours pu	imping gpm rell was ft		Online	Mapper				
, , , , , , , , , , , , , , , , , , , ,	imping gpm	6	Elevation	1220.46 ft	Ground Le	vel X TOC		
x SE Estimated Yield:				Land Survey		Topographic Map		
Bore Hole Diameter: 7	fi, and		50470674	Oil -	9,5			
S Sole Fishe Statutes.	in to ft	1	L					
1								
7 WELL WATER TO BE USED AS:		1						
1 Domestic: 5 Public Water Supply: v			_	Vater Supply: lease				
Household 6 Dewatering: how man	•	11	Test Hole: well		Geotechnica	1		
Lawn & Garden 7 Aquifer Recharge: well Livestock 8 X Monitoring: well ID M		12	Cased [ Geothermal: Ho	Uncased	Georechnica	1		
2 Irrigation 9 Environmental Remediation			a) Closed Loo		Vertica			
	Soil Vapor Extraction		b) Open Loop	, <del></del>	scharge	1		
	Injection	[	Other (spe	oifu):	,e.ige	·		
	·	<u>`</u>				-		
Was a chemical/bacteriological sample submitted to KDHE? Water well disinfected? Yes X No	Yes X No	If yes, date	sample was sub	omitted:	••••••			
				, Day , , , [	<del></del>			
8 TYPE OF CASING USED: Steel X PVC Compared to the state of the state	OtherC	ASING JOIN	TS: Glu	ed Clampled L	] Welded [2	1 Threaded		
Casing diameter 2 in. to 20 ft, Diameter in. to ft, Diameter in. to ft,								
Casing height above land surface -0.37 in Weight	lbs /fi		ickness or gang	- <b>h</b> 1-				
Casing height above land surface -0.37 in. Weight	lbs./ft.	Well th	ickness or gaug	e No				
Casing height above land surface -0.37 in. Weight TYPE OF SCREEN OR PERFORATION MATERIAL:	lbs./ft.	Well th	ickness or gaug	- <b>h</b> 1-				
Casing height above land surface -0.37 in. Weight TYPE OF SCREEN OR PERFORATION MATERIAL:  Steel Stainless Steel Fiberglass	lbs./fi.	Well th	ickness or gaug	- <b>h</b> 1-				
Casing height above land surface -0.37 in. Weight TYPE OF SCREEN OR PERFORATION MATERIAL:  Steel Stainless Steel Fiberglass	lbs./ft.	Well th	ickness or gaug	- <b>h</b> 1-				
Casing height above land surface -0.37 in. Weight TYPE OF SCREEN OR PERFORATION MATERIAL:  Steel Stainless Steel Fiberglass Brass Galvanized Steel Concrete tile	PVC None used (open hole)	Well th	ickness or gaug	e No				
Casing height above land surface -0.37 in. Weight TYPE OF SCREEN OR PERFORATION MATERIAL:  Steel Stainless Steel Fiberglass Brass Galvanized Steel Concrete tile SCREEN OR PERFORATION OPENINGS ARE:	Ibs./fi.  PVC None used (open hole)  pped Torch Cut	Well th Oth	ickness or gaug	- <b>h</b> 1-				
Casing height above land surface -0.37 in. Weight TYPE OF SCREEN OR PERFORATION MATERIAL:  Steel Stainless Steel Fiberglass Steel Concrete tile SCREEN OR PERFORATION OPENINGS ARE:  Continuous Slot X Mill Slot Gauze Wrap Louvered Shutter Key Punched Wire Wrapp SCREEN-PERFORATED INTERVALS: From 20 ft. to	lbs./fi.    PVC	Well th Oth Drilled None (	ickness or gaug ner (Specify)  Holes  [ Open Hole)	Other (Specify)		ft,		
Casing height above land surface -0.37 in. Weight TYPE OF SCREEN OR PERFORATION MATERIAL:  Steel Stainless Steel Fiberglass Steel Concrete tile  Brass Galvanized Steel Concrete tile  SCREEN OR PERFORATION OPENINGS ARE:  Continuous Slot X Mill Slot Gauze Wrap Louvered Shutter Key Punched Wire Wrapp SCREEN-PERFORATED INTERVALS: From 20 ft. to	lbs./ft.   lbs./ft.	Well th  Ott  Drilled  None (	ickness or gaug ner (Specify)  Holes  Open Hole) to	Other (Specify)	fi. to			
Casing height above land surface -0.37 in. Weight TYPE OF SCREEN OR PERFORATION MATERIAL:  Steel Stainless Steel Fiberglass Steel Concrete tile SCREEN OR PERFORATION OPENINGS ARE:  Continuous Slot X Mill Slot Gauze Wrap Louvered Shutter Key Punched Wire Wrapp SCREEN-PERFORATED INTERVALS: From 20 ft. to GRAVEL PACK INTERVALS: From 18 ft. to	None used (open hole)  pped Torch Cut bed Saw Cut co 35 ft. From co 35 ft. From	Oth  Drilled  None (  ft.	Holes [ Open Hole) toto	Other (Specify)	fi. to			
Casing height above land surface -0.37 in. Weight TYPE OF SCREEN OR PERFORATION MATERIAL:  Steel Stainless Steel Fiberglass Steel Concrete tile SCREEN OR PERFORATION OPENINGS ARE:  Continuous Slot X Mill Slot Gauze Wrap Louvered Shutter Key Punched Wire Wrapp SCREEN-PERFORATED INTERVALS: From 20 ft. to GRAVEL PACK INTERVALS: From 18 ft. to	None used (open hole)  pped Torch Cut bed Saw Cut co 35 ft. From co 35 ft. From grout X Bentonite	Well th  Oth  Drilled  None (  ft.  X Other	Holes [ Open Hole) to	Other (Specify)	fi. to			
Casing height above land surface -0.37 in. Weight TYPE OF SCREEN OR PERFORATION MATERIAL:  Steel Stainless Steel Fiberglass Steel Galvanized Steel Concrete tile  SCREEN OR PERFORATION OPENINGS ARE:  Continuous Slot X Mill Slot Gauze Wrap Louvered Shutter Key Punched Wire Wrapp SCREEN-PERFORATED INTERVALS: From 20 ft. to GRAVEL PACK INTERVALS: From 18 ft. to  9 GROUT MATERIAL: Neat cement Cement Grout intervals: From 0.4 ft. to 18 ft. From	None used (open hole)  pped Torch Cut bed Saw Cut co 35 ft. From co 35 ft. From grout X Bentonite	Oth  Drilled  None (  ft.	Holes [ Open Hole) to	Other (Specify)	fi. to			
Casing height above land surface -0.37 in. Weight TYPE OF SCREEN OR PERFORATION MATERIAL:  Steel Stainless Steel Fiberglass Steel Concrete tile SCREEN OR PERFORATION OPENINGS ARE:  Continuous Slot Mill Slot Gauze Wrap Louvered Shutter Key Punched Wire Wrapp SCREEN-PERFORATED INTERVALS: From 20 ft. to GRAVEL PACK INTERVALS: From 18 ft. to	lbs./ft.     PVC	Well th  Oth  Drilled  None (  fi.  fi.  X Other  ft, From	Holes [ Open Hole) to	Other (Specify) fit, From fit, From fit, fit,	fi. to			
Casing height above land surface -0.37 in. Weight TYPE OF SCREEN OR PERFORATION MATERIAL:  Steel Stainless Steel Fiberglass Steel Galvanized Steel Concrete tile SCREEN OR PERFORATION OPENINGS ARE:  Continuous Slot X Mill Slot Gauze Wrap Louvered Shutter Key Punched Wire Wrapp SCREEN-PERFORATED INTERVALS: From 20 ft. to GRAVEL PACK INTERVALS: From 18 ft. to 9 GROUT MATERIAL: Neat cement Cement Grout intervals: From 0.4 ft. to 18 ft, From Nearest source of possible contamination:	None used (open hole)  pped Torch Cut bed Saw Cut co 35 ft. From co 35 ft. From grout X Bentonite	Well th  Oth  Drilled  None (  fi.  fi.  X Other  ft, From	Holes [Open Hole) to Concrete 0-0.4 ft.	Other (Specify)  fit, From fit, From fit,  Insecticide	fi. to			
Casing height above land surface -0.37 in. Weight TYPE OF SCREEN OR PERFORATION MATERIAL:  Steel Stainless Steel Fiberglass Steel Concrete tile SCREEN OR PERFORATION OPENINGS ARE:  Continuous Slot Mill Slot Gauze Wrap Louvered Shutter Key Punched Wire Wrapp SCREEN-PERFORATED INTERVALS: From 20 ft. to GRAVEL PACK INTERVALS: From 18 ft. to  GROUT MATERIAL: Neat cement Cement Grout intervals: From 0.4 ft. to 18 ft. From Nearest source of possible contamination:  Septic Tank Lateral Lines	lbs./ft.     PVC	Well th  Oth  Drilled  None (  fi.  ft.  X Other  ft. From  Livesto  X Fuel St	Holes [Open Hole) to Concrete 0-0.4 ft.	Other (Specify)  fit, From fit, From fit,  Insecticide	fi. tofi. to			
Casing height above land surface -0.37 in. Weight TYPE OF SCREEN OR PERFORATION MATERIAL:  Steel Stainless Steel Fiberglass Material Screen or Perforation Openings of Screen or Scr	lbs./ft.     PVC	Well th  Oth  Oth  Drilled  None (  fi.  ft.  X Other  ft. From  Livesto  X Fuel St	Holes [ Open Hole) to Concrete: 0-0.4 ft. sick Pens orage	Other (Specify)  fit, From fit, From Insecticide Abandoned	fi. tofi. to			
Casing height above land surface	lbs./ft.     PVC	Drilled None ( fi. ft.  X Other ft, From Livesto X Fuel St Fertiliz	Holes [Open Hole) to Concrete: 0-0.4 ft. sick Pens orage er Storage	Other (Specify)  fit, From  fit, From  Insecticide  Abandoned  Oil Well / O	fi. tofi. to			
Casing height above land surface -0.37 in. Weight TYPE OF SCREEN OR PERFORATION MATERIAL:  Steel Stainless Steel Fiberglass Material Screen or Perforation Openings of Screen or Scr	lbs./ft.     PVC	Drilled None ( fi. ft.  X Other ft, From Livesto X Fuel St Fertiliz	Holes [ Open Hole) to Concrete: 0-0.4 ft. sick Pens orage	Other (Specify)  fit, From  fit, From  Insecticide  Abandoned  Oil Well / O	fi. to fi. to Storage Water Well Gas Well	ft,		
Casing height above land surface -0.37 in. Weight TYPE OF SCREEN OR PERFORATION MATERIAL:  Steel Stainless Steel Fiberglass Steel Galvanized Steel Concrete tile SCREEN OR PERFORATION OPENINGS ARE:  Continuous Slot Mill Slot Gauze Wrap Louvered Shutter Key Punched Wire Wrapp SCREEN-PERFORATED INTERVALS: From 20 ft. to GRAVEL PACK INTERVALS: From 18 ft. to 9 GROUT MATERIAL: Neat cement Cement Grout intervals: From 0.4 ft. to 18 ft. From Nearest source of possible contamination:  Septic Tank Lateral Lines Cess Pool Waterlight Sewer Lines Seepage Pit Other (Specity)  Direction from well? SE  10 FROM TO LITHOLOGIC I	lbs./ft.     PVC	Well th  Oth  Oth  Oth  None (  fi.  X Other  ft, From  Livesto  X Fuel St  Fertiliz	Holes [Open Hole) to	Other (Specify)  fit, From fit, From  Insecticide Abandoned Oil Well / C	fi. to fi. to Storage Water Well Gas Well	ft,		
Casing height above land surface -0.37 in. Weight TYPE OF SCREEN OR PERFORATION MATERIAL:  Steel Stainless Steel Fiberglass Steel Galvanized Steel Concrete tile Concrete tile SCREEN OR PERFORATION OPENINGS ARE:  Continuous Slot Mill Slot Gauze Wrap Louvered Shutter Key Punched Wire Wrapp SCREEN-PERFORATED INTERVALS: From 20 ft. to GRAVEL PACK INTERVALS: From 18 ft. to 9 GROUT MATERIAL: Neat cement Cement Grout intervals: From 0.4 ft. to 18 ft. From Nearest source of possible contamination:  Septic Tank Lateral Lines Cess Pool Watertight Sewer Lines Seepage Pit Other (Specity)  Direction from well? SE  10 FROM TO LITHOLOGIC I 0 0.4 Concrete 0.4 0.6 Fine fill sand	lbs./ft.     PVC	Well th  Oth  Oth  Oth  None (  fi.  X Other  ft, From  Livesto  X Fuel St  Fertiliz	Holes [Open Hole) to	Other (Specify)  fit, From fit, From  Insecticide Abandoned Oil Well / C	fi. to fi. to Storage Water Well Gas Well	ft,		
Casing height above land surface -0.37 in. Weight TYPE OF SCREEN OR PERFORATION MATERIAL:  Steel Stainless Steel Fiberglass Steel Galvanized Steel Concrete tile Concrete tile SCREEN OR PERFORATION OPENINGS ARE:  Continuous Slot Mill Slot Gauze Wrap Louvered Shutter Key Punched Wire Wrapp SCREEN-PERFORATED INTERVALS: From 20 ft. to GRAVEL PACK INTERVALS: From 18 ft. to 9 GROUT MATERIAL: Neat cement Cement Grout intervals: From 0.4 ft. to 18 ft. From Nearest source of possible contamination:  Septic Tank Lateral Lines Cess Pool Watertight Sewer Lines Seepage Pit Other (Specity)  Direction from well? SE  10 FROM TO LITHOLOGIC I 0 0.4 Concrete 0.4 0.6 Fine fill sand 0.6 3 Clavey wil w/clavey sand fingers	lbs./ft.     PVC	Well th  Oth  Oth  Oth  None (  fi.  X Other  ft, From  Livesto  X Fuel St  Fertiliz	Holes [Open Hole) to	Other (Specify)  fit, From fit, From  Insecticide Abandoned Oil Well / C	fi. to fi. to Storage Water Well Gas Well	ft,		
Casing height above land surface -0.37 in. Weight TYPE OF SCREEN OR PERFORATION MATERIAL:  Steel Stainless Steel Fiberglass Mars Galvanized Steel Concrete tile SCREEN OR PERFORATION OPENINGS ARE:  Continuous Slot Maill Slot Gauze Wrap Louvered Shutter Key Punched Wire Wrapp SCREEN-PERFORATED INTERVALS: From 20 ft. to GRAVEL PACK INTERVALS: From 18 ft. to 9 GROUT MATERIAL: Neat cement Cement Grout intervals: From 0.4 ft. to 18 ft, From Nearest source of possible contamination:  Septic Tank Lateral Lines Sewer Lines Cess Pool Watertight Sewer Lines Seepage Pit Other (Specity)  Direction from well? SE  10 FROM TO LITHOLOGIC I 0 0.4 Concrete  0.4 0.6 Fine fill sand  0.6 3 Clayey wil w/ clayey sand fingers  3 7 Clayey silt w/ clay lenses	lbs./ft.     PVC	Well th  Oth  Oth  Oth  None (  fi.  X Other  ft, From  Livesto  X Fuel St  Fertiliz	Holes [Open Hole) to	Other (Specify)  fit, From fit, From  Insecticide Abandoned Oil Well / C	fi. to fi. to Storage Water Well Gas Well	ft,		
Casing height above land surface -0.37 in. Weight TYPE OF SCREEN OR PERFORATION MATERIAL:  Steel Stainless Steel Fiberglass Mars Galvanized Steel Concrete tile SCREEN OR PERFORATION OPENINGS ARE:  Continuous Slot Maill Slot Gauze Wrap Louvered Shutter Key Punched Wire Wrapp SCREEN-PERFORATED INTERVALS: From 20 ft. to GRAVEL PACK INTERVALS: From 18 ft. to 9 GROUT MATERIAL: Neat cement Cement Grout intervals: From 0.4 ft. to 18 ft. From Nearest source of possible contamination:  Septic Tank Lateral Lines Sewer Lines Cess Pool Watertight Sewer Lines Seepage Pit Other (Specity)  Direction from well? SE  10 FROM TO LITHOLOGIC I  0 0.4 Concrete 0.4 0.6 Fine fill sand 0.6 3 Clayey will w/ clayey sand fingers 3 7 Clayey silt w/ clay lenses 7 8 Lean clay	lbs./ft.     PVC	Well th  Oth  Oth  Oth  None (  fi.  X Other  ft, From  Livesto  X Fuel St  Fertiliz	Holes [Open Hole) to	Other (Specify)  fit, From fit, From  Insecticide Abandoned Oil Well / C	fi. to fi. to Storage Water Well Gas Well	ft,		
Casing height above land surface -0.37 in. Weight TYPE OF SCREEN OR PERFORATION MATERIAL:  Steel Stainless Steel Fiberglass Mars Galvanized Steel Concrete tile SCREEN OR PERFORATION OPENINGS ARE:  Continuous Slot Maill Slot Gauze Wrap Louvered Shutter Key Punched Wire Wrapp SCREEN-PERFORATED INTERVALS: From 20 ft. to GRAVEL PACK INTERVALS: From 18 ft. to 9 GROUT MATERIAL: Neat cement Cement Grout intervals: From 0.4 ft. to 18 ft. From Nearest source of possible contamination:  Septic Tank Lateral Lines Sewer Lines Cess Pool Watertight Sewer Lines Seepage Pit Other (Specity)  Direction from well? SE  10 FROM TO LITHOLOGIC I  0 0.4 Concrete 0.4 0.6 Fine fill sand 0.6 3 Clayey will w/ clayey sand fingers 3 7 Clayey silt w/ clay lenses 7 8 Lean clay 8 15 Clayey silt w/ silt & clay bands	lbs./ft.   lbs./ft.	Well th  Oth  Oth  Oth  Oth  None (  fi.  ft.  X Other  ft. From  Livesto  X Fuel St  Fertiliz  FROM	Holes [Open Hole) to	Other (Specify)  fit, From  fit, From  Insecticide Abandoned Oil Well / O  ft  LITHO LOG (con	fi. to fi. to Storage Water Well Gas Well	ft,		
Casing height above land surface -0.37 in. Weight TYPE OF SCREEN OR PERFORATION MATERIAL:  Steel Stainless Steel Fiberglass Mars Galvanized Steel Concrete tile SCREEN OR PERFORATION OPENINGS ARE:  Continuous Slot Maill Slot Gauze Wrap Louvered Shutter Key Punched Wire Wrapp SCREEN-PERFORATED INTERVALS: From 20 ft to GRAVEL PACK INTERVALS: From 18 ft to GRAVEL PACK INTERVALS: From 18 ft to 9 GROUT MATERIAL: Neat cement Cement Grout intervals: From 0.4 ft. to 18 ft, From Nearest source of possible contamination:  Septic Tank Lateral Lines Cess Pool Watertight Sewer Lines Cess Pool Watertight Sewer Lines Seepage Pit Other (Specity)  Direction from well? SE  10 FROM TO LITHOLOGIC I 0 0.4 Concrete 0.4 0.6 Fine fill sand 0.6 3 Clayey will w/ clayey sand fingers 3 7 Clayey silt w/ clay lenses 7 8 Lean clay	lbs./ft.   lbs./ft.	Well th  Oth  Drilled  None (  fi.  ft.  X Other  ft. From  Livesto  X Fuel St  Fertiliz  O  FROM  Other  O	Holes [Open Hole) to Concrete: 0-0.4 ft.  sck Pens orage er Storage  TO ID: Pilot Trav	Other (Specify)  fit, From fit, From  Insecticide Abandoned Oil Well / C	ft. toft. toStorage Water Well Gas Well L.) or PLUGGING	G INTERVALS		
Casing height above land surface -0.37 in. Weight TYPE OF SCREEN OR PERFORATION MATERIAL:  Steel Stainless Steel Fiberglass Mars Galvanized Steel Concrete tile SCREEN OR PERFORATION OPENINGS ARE:  Continuous Slot Maill Slot Gauze Wrap Louvered Shutter Key Punched Wire Wrapp SCREEN-PERFORATED INTERVALS: From 20 ft. to GRAVEL PACK INTERVALS: From 18 ft. to 9 GROUT MATERIAL: Neat cement Cement Grout intervals: From 0.4 ft. to 18 ft. From Nearest source of possible contamination:  Septic Tank Lateral Lines Cess Pool Watertight Sewer Lines Cess Pool Watertight Sewer Lines Seepage Pit Other (Specity)  Direction from well? SE  10 FROM TO LITHOLOGIC I  0 0.4 Concrete 0.4 0.6 Fine fill sand 0.6 3 Clayey will w/ clayey sand fingers 3 7 Clayey silt w/ clay lenses 7 8 Lean clay 8 15 Clayey silt w/ sand and silt bands	lbs./ft.   lbs./ft.	Well th  Oth  Drilled  None (  fi.  ft.  X Other  ft. From  Livesto  X Fuel St  Fertiliz  O  FROM  Other  O	Holes [Open Hole) to	Other (Specify)  fit, From fit, From Insecticide Abandoned Oil Well / O  LITHO. LOG (con	ft. toft. toft. toft. toft. toft. or PLUGGINGft.) or PLUGGINGft.) or PLUGGINGft.) or PLUGGINGft.) or pluggingft.) or pluggingft.) or pluggingft.	G INTERVALS		
Casing height above land surface -0.37 in. Weight TYPE OF SCREEN OR PERFORATION MATERIAL:  Steel Stainless Steel Fiberglass Mars Galvanized Steel Concrete tile SCREEN OR PERFORATION OPENINGS ARE:  Continuous Slot Maill Slot Gauze Wrap Louvered Shutter Key Punched Wire Wrapp SCREEN-PERFORATED INTERVALS: From 20 ft. to GRAVEL PACK INTERVALS: From 18 ft. to 9 GROUT MATERIAL: Neat cement Cement Grout intervals: From 0.4 ft. to 18 ft. From Nearest source of possible contamination:  Septic Tank Lateral Lines Cess Pool Watertight Sewer Lines Sewer Lines Seepage Pit Other (Specity)  Direction from well? SE  10 FROM TO LITHOLOGIC I  0 0.4 Concrete 0.4 0.6 Fine fill sand 0.6 3 Clavey wil w/ clavey sand fingers 3 7 Clavey silt w/ clay lenses 7 8 Lean clay 8 15 Clavey silt w/ sand and silt bands 25 335 Clavey silt  11 CONTRACTOR'S OR LANDOWNER'S CERTIFICATION  11 CONTRACTOR'S OR LANDOWNER'S CERTIFICATION  SCREEN-PERFORATION MATERIAL: Mail Slot Galvey silt	lbs./ft.   lbs./ft.	Well th  Oth  Oth  Oth  Oth  None (  fi.  ft.  X Other  ft. From  Livesto  X Fuel St  Fertiliz  O  FROM  Oth  FROM  I Compared to the state of monite direction of the state o	Holes [Open Hole) to	Other (Specify)  fit, From fit, From Insecticide Abandoned Oil Well / O  ft  LITHO. LOG (con	fi. tofi. to	G INTERVALS  was installed at ander my		
Casing height above land surface -0.37 in. Weight TYPE OF SCREEN OR PERFORATION MATERIAL:  Steel Stainless Steel Fiberglass Mars Galvanized Steel Concrete tile SCREEN OR PERFORATION OPENINGS ARE:  Continuous Slot Maill Slot Gauze Wrap Louvered Shutter Key Punched Wire Wrapp SCREEN-PERFORATED INTERVALS: From 20 ft. to GRAVEL PACK INTERVALS: From 18 ft. to 9 GROUT MATERIAL: Neat cement Cement Grout intervals: From 0.4 ft. to 18 ft. From Nearest source of possible contamination:  Septic Tank Lateral Lines Cess Pool Watertight Sewer Lines Cess Pool Watertight Sewer Lines Seepage Pit Other (Specity)  Direction from well? SE  10 FROM TO LITHOLOGIC I  0 0.4 Concrete 0.4 0.6 Fine fill sand 0.6 3 Clavey wil w/ clavey sand fingers 3 7 Clavey silt w/ clay lenses 7 8 Lean clay 8 15 Clavey silt w/ sand and silt bands 25 335 Clavey silt  11 CONTRACTOR'S OR LANDOWNER'S CERTIFICATIO jurisdiction and was completed on (mo-day-year) 6/20/18	lbs./ft.	Well th  Oth  Oth  Oth  None (  fi.  ft.  X Other  ft. From  Livesto  X Fuel St  Fertiliz  O  FROM  Oth  FROM  Oth  Contact of monite direction of the best of my	Holes [Open Hole) to	Other (Specify)  fit, From fit, From Insecticide Abandoned Oil Well / O  ft  LITHO. LOG (con	fi. tofi. to	G INTERVALS  was installed at ander my		
Casing height above land surface -0.37 in. Weight TYPE OF SCREEN OR PERFORATION MATERIAL:  Steel Stainless Steel Fiberglass Mars Galvanized Steel Concrete tile SCREEN OR PERFORATION OPENINGS ARE:  Continuous Slot Maill Slot Gauze Wrap Louvered Shutter Key Punched Wire Wrapp SCREEN-PERFORATED INTERVALS: From 20 ft. to GRAVEL PACK INTERVALS: From 18 ft. to 9 GROUT MATERIAL: Neat cement Cement Grout intervals: From 0.4 ft. to 18 ft. From Nearest source of possible contamination:  Septic Tank Lateral Lines Cess Pool Watertight Sewer Lines Cess Pool Watertight Sewer Lines Seepage Pit Other (Specity)  Direction from well? SE  10 FROM TO LITHOLOGIC I 0 0.4 Concrete 0.4 0.6 Fine fill sand 0.6 3 Clavey will w/ clavey sand fingers 3 7 Clavey silt w/ clay lenses 7 8 Lean clav 8 Lean clav 8 15 Clavey silt w/ sand and silt bands 25 Sandy silt w/ sand and silt bands 25 Sandy silt w/ sand and silt bands 25 Sandy silt w/ sand and silt bands 15 Clavey silt w/ sand and silt bands 15 Clavey silt w/ sand and silt bands 25 Sandy silt w/ sand silt bands 25 San	lbs./ft.	Well th  Oth  Oth  Oth  Oth  None (  ft.  IX Other  ft. From  Livesto  X Fuel St  Fertiliz  O  FROM  Oth  Oth  A conthe best of my ar) 7/31/18	Holes [Open Hole) to	Other (Specify)  fit, From fit, From Insecticide Abandoned Oil Well / O  ft  LITHO. LOG (con	fi. tofi. to	G INTERVALS  was installed at ander my		
Casing height above land surface -0.37 in. Weight TYPE OF SCREEN OR PERFORATION MATERIAL:  Steel Stainless Steel Fiberglass Mars Galvanized Steel Concrete tile SCREEN OR PERFORATION OPENINGS ARE:  Continuous Slot Maill Slot Gauze Wrap Louvered Shutter Key Punched Wire Wrapp SCREEN-PERFORATED INTERVALS: From 20 ft. to GRAVEL PACK INTERVALS: From 18 ft. to 9 GROUT MATERIAL: Neat cement Cement Grout intervals: From 0.4 ft. to 18 ft. From Nearest source of possible contamination:  Septic Tank Lateral Lines Cess Pool Watertight Sewer Lines Cess Pool Watertight Sewer Lines Seepage Pit Other (Specity)  Direction from well? SE  10 FROM TO LITHOLOGIC I  0 0.4 Concrete 0.4 0.6 Fine fill sand 0.6 3 Clayev wil w/ clayev sand fingers 3 7 Clayev silt w/ clay lenses 7 8 Lean clay 8 15 Clayev silt w/ sand and silt bands 15 25 Sandy silt w/ sand and silt bands 25 35 Clayev silt  11 CONTRACTOR'S OR LANDOWNER'S CERTIFICATION in the properties of the purisher of t	Saw Cut   Saw	Well th  Oth  Oth  Oth  Oth  None (  fi.  fi.  X Other  fi. From  Livesto  X Fuel St  Fertiliz  O  FROM  FROM  The best of monite direction of the best of monite arrows arrows 7/31/18	Holes [Open Hole) to	Other (Specify)  fit, From fit, From Insecticide Abandoned Oil Well / O  ft  LITHO LOG (con	ft. to ft. to Storage Water Well Gas Well  5-085-15025 <20' of grout water Well Control	G INTERVALS  was installed at ander my		
Casing height above land surface -0.37 in. Weight TYPE OF SCREEN OR PERFORATION MATERIAL:  Steel Stainless Steel Fiberglass Mars Galvanized Steel Concrete tile SCREEN OR PERFORATION OPENINGS ARE:  Continuous Slot Maill Slot Gauze Wrap Louvered Shutter Key Punched Wire Wrapp SCREEN-PERFORATED INTERVALS: From 20 ft. to GRAVEL PACK INTERVALS: From 18 ft. to 9 GROUT MATERIAL: Neat cement Cement Grout intervals: From 0.4 ft. to 18 ft, From Nearest source of possible contamination:  Septic Tank Lateral Lines Cess Pool Watertight Sewer Lines Cess Pool Watertight Sewer Lines Seepage Pit Other (Specity)  Direction from well? SE  10 FROM TO LITHOLOGIC I  0 0.4 Concrete 0.4 0.6 Fine fill sand 0.6 3 Clayey will w/ clayey sand fingers 3 7 Clayey silt w/ clay lenses 7 8 Lean clay 8 15 Clayey silt w/ sand and silt bands 15 25 Sandy silt w/ sand and silt bands 25 35 Clayey silt  11 CONTRACTOR'S OR LANDOWNER'S CERTIFICATIO jurisdiction and was completed on (mo-day-year) 6/20/18 License No 757 This Water Well Record was under the business name of Larsen & Associates Inc.	Sewage Lagoon   Peedyard   Pools Trois water well was and this record is true to the second pools of the	Well th  Oth  Oth  Oth  None (  fi.  ft.  X Other  ft. From  Livesto  X Fuel St  Fertiliz  O  FROM  TROM  Truet of monite direction of  X conthe best of my ar) 7/31/18	Holes [Open Hole) to	Other (Specify)  fit, From fit, From Insecticide Abandoned Oil Well / O  ft  LITHO LOG (con  reconstructed of delief. Kansas W	ft. toft. toft. to	G INTERVALS  vas installed at ander my		

Salline

NE NW SWSW

36-135-3W

## **DENNIS L HANDKE**

1820 NW 59th Terrace TOPEKA, KANSAS 66618 785-286-4047 Home 785-286-1990 Fax

Jessica Chapman Larsen & Associates 1311 E. 25<sup>th</sup> Street, Suite B Lawrence, Kansas, 66046

RE: Monitor Well Elevation Survey 1994 N. 9th Street, Salina, Kansas

July 16, 2018

Proj. 18-00U Pilot Travel Center \$903 U5-085-15025

Bench Mark: Sq. cut on West edge of East abandoned concrete sign base near the West center of property. Elev: 1223.44 North 1229.95 West 5185.63 (from SE Cor. Sec. 36-13-3W)

E16v. 122	.3.44	1401th 1229	.93	West 5165.05	(Holli SE Col. Sec. 50-15-5
MW-1	rim	1220.87	North	1245.50	NE1/4,NW1/4,SW1/4,SW1/4
	top pipe	1220.50	West	4633.67	Lat= 38.87414 Long = 97.61007
MW-2	rim	1220.83	North	1298.02	NE1/4,NW1/4,SW1/4,SW1/4
	top pipe	1220.46	West	4639.57	Lat= 38.87428 Long = 97.61009
MW-3	rim	1218.23	North	1100.17	NW1/4,NE1/4,SW1/4,SW1/4
Pedistal	top pipe	1220.91	West	4529.14	Lat= 38.87374 Long = 97.60970
MW-4	rim	1223.84	North	1317.10	NE1/4,NW1/4,SW1/4,SW1/4
	top pipe	1223.44	West	4906.57	Lat= 38.87434 Long = 97.61102
MW-5	rim	1218.39	North	1424.93	SW1/4,SE1/4,NW1/4,SW1/4
	top pipe	1218.05	West	4578.06	Lat= 38.87463 Long = 97.60987
MW-6	rim	1220.93	North	1064.58	NE1/4,NW1/4,SW1/4,SW1/4
	top pipe	1220.44	West	4868.22	Lat= 38.87364 Long = 97.61089
MW-7	rim	1217.40	North	1079.54	NE1/4,NW1/4,SW1/4,SW1/4
Pedistal	top pipe	1220.87	West	4625.56	Lat= 38.87368 Long = 97.61004
MW-8	rim	1216.47	North	1347.62	SW1/4,SE1/4,NW1/4,SW1/4
	top pipe	1216.14	West	4375.88	Lat= 38.87441 Long = 97.60916
MW-9	rim	1216.86	North	1276.17	NW1/4,NE1/4,SW1/4,SW1/4
	top pipe	1216.44	West	4376.07	Lat= 38.87422 Long = 97.60916


Lat & Long derived from Salina 7.5' quad map. WGS84

Elevation established from USGS BM M 167 NAVD 88.

If you have any questions, please feel free to call me. Thank you for the opportunity to be

of service to you.

Dennis L Handke RLS

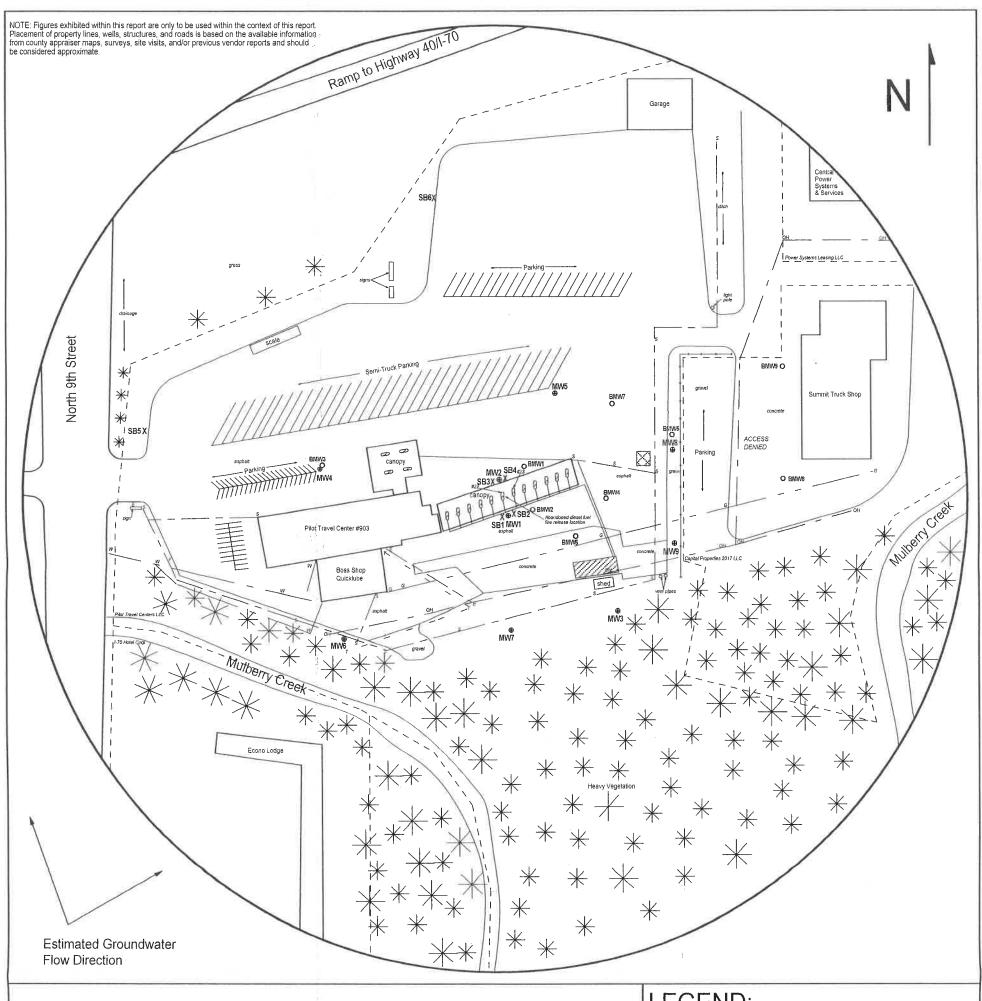

## FIGURE 2.2 - 700 FT RADIUS AREA BASE MAP



1311 E 25th St., Suite B Lawrence, KS 66046

(785) 841-8707 office. (785) 865-4282 fax

## **PROJECT**:

Pilot Travel Center #903 1944 North 9th Street Salina, KS KDHE ID: U5-085-15025 Date: 6/25/18

140 feet

## LEGEND:

Approximate Location of Active UST Basin, Product Line and Pump Islands

Approximate Location of Oil Water Separator

– – - Approximate Location of Property Lines

O Plugged Well

⊕ Monitoring Well (Installed 6/18-21/18)

X Soil Boring (Drilled 6/21/18 and 6/25/18)

- - - - - Electric Lines (2 - 6 ft BGS) - - - - Gas Lines (2 - 6 ft BGS) - Overhead Lines (25-40 ft high)

Sanitary Sewer (2 - 6 ft BGS)

To Sanitary Sewer (2 - 6 ft BGS)

To Sanitary Sewer (2 - 6 ft BGS)

Work Sewer (2 - 6 ft BGS)

Water Lines (2 - 6 ft BGS)

NOTE: Utility depths, heights and locations are approximate.

NOTE: SB5 & SB6 were drilled to collect hydrologic samples.

RECEIVED

SEP.1 4 2018

BUREAU OF WATER

定