

County: Wallace Fraction: SW NW NW NE Sec. 27 T. 13 S R. 40 W

CORRECTION(S) to WATER WELL COMPLETION RECORD Form WWC-5 (to rectify lacking or incorrect information)

Owner: City of Sharon Springs **Monitoring**

If location corrected, was listed as:

Location changed to:

Section-Township-Range: _____

Fraction (¼ calls): _____

Other changes: Initial statements: Well Contractor Code was 735

Changed to: Well Contractor Code 881

Comments: Well contractor code of 735 did not match to the business name of name of Woofter Pump and Well.

Verification method: Confirmed by Milco Env. Srvs. via Pam Chaffee

Initials: SH Date: 11/30/2023

Submitted by: Kansas Geological Survey, Data Resources Library, 1930 Constant Ave., Lawrence, KS 66047-3724

Kansas Dept. of Health & Environment, Bureau of Water, 1000 SW Jackson, Suite 420, Topeka, KS 66612-1367

WATER WELL RECORD Form WWC-5

Division of Water Resources App. No.

[]

Well ID

MW-16

Original Record Correction Change in Well Use

1 LOCATION OF WATER WELL: County: Wallace Fraction NE 1/4 NE 1/4 NE 1/4 NW 1/4 Section Number 27 Township Number T 13 S Range Number R 40 E W

2 WELL OWNER: Last Name: City: Sharon Springs State: KS ZIP: 67758 Street or Rural Address where well is located in ROW west of 608 N. Gardner Street in Sharon Springs

3 LOCATE WELL WITH 'X' IN SECTION BOX: [Diagram] 4 DEPTH OF COMPLETED WELL: 40 ft. 5 Latitude: 38.901296 Longitude: -101.750271

7 WELL WATER TO BE USED AS: 1. Domestic: 2. Irrigation: 3. Feedlot: 4. Industrial: 5. Public Water Supply: 6. Dewatering: 7. Aquifer Recharge: 8. Monitoring: 9. Environmental Remediation: 10. Oil Field Water Supply: 11. Test Hole: 12. Geothermal: 13. Other

Was a chemical/bacteriological sample submitted to KDHE? Water well disinfected?

8 TYPE OF CASING USED: Steel PVC Other CASING JOINTS: Glued Clamped Welded Threaded Casing diameter 2 in. to 25 ft. Diameter in. to ft. Casing height above land surface -4 in. Weight 0.68 lbs./ft. Wall thickness or gauge No. 0.154

9 GROUT MATERIAL: Neat cement Cement grout Bentonite Other Grout Intervals: From 1 ft. to 23 ft.

Nearest source of possible contamination: Septic Tank Lateral Lines Pit Privy Livestock Pens Insecticide Storage Sewer Lines Cess Pool Sewage Lagoon Fuel Storage Abandoned Water Well Watertight Sewer Lines Seepage Pit Feedyard Fertilizer Storage Oil Well/Gas Well

Table with 6 columns: 10 FROM, TO, LITHOLOGIC LOG, FROM, TO, LITHO. LOG (cont.) or PLUGGING INTERVALS. Rows include Concrete over Sandy Clay, Silt, Clay, and Shale, clayey, highly weathered with hard, brittle layers after 36'.

11 CONTRACTOR'S OR LANDOWNER'S CERTIFICATION: This water well was constructed, reconstructed, or plugged under my jurisdiction and was completed on (mo-day-year) 1/26/2023 and this record is true to the best of my knowledge and belief.

PLOTTED: 3/7/2023 1:57 PM G:\Projects\437\437-P1-02\Semi-annual 3-2023\Figure A.dwg


SAVED: 12/5/2022 2:52 PM



LEGEND

- MONITORING WELL
- PLUGGED WELL
- FORMER UST BASIN
- FORMER PUMP ISLAND/PRODUCT LINES

T. 13 Rge. 40W Sec. 27
 Wallace County
 KDHE: Shamrock Service
 U6-100-00704

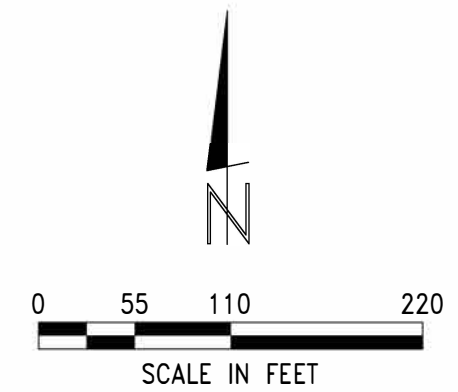

REVISIONS	BY

MILCO
 Environmental Services, Inc.
 Kearney, NE (308) 237-5923
 McCook, NE (308) 345-4741

SHAMROCK SERVICE
SITE MAP
 612 N. MAIN STREET - SHARON SPRINGS, KANSAS U6-100-00704
This document, and the ideas and designs incorporated herein, are an instrument of professional service, is the property of MILCO and is not to be used in whole or in part, for any other project without the written authorization of © 2009 MILCO.

SCALE:	AS SHOWN
PROJECT NO.	M437-P1-02
DATE:	MARCH, 2023
FIELD BOOK:	M&A DWG NO.
DRAWN BY:	TWB
APRVD BY:	
SHEET:	

FIGURE A