

1 LOCATION OF WATER WELL: County: Ellis	Fraction SW ¼ SE ¼ SE ¼	Section Number 3	Township Number T 14 S	Range Number R 18 E/W
---	-----------------------------------	----------------------------	----------------------------------	---------------------------------

Distance and direction from nearest town or city street address of well if located within city?
2000 Front Street, Hays, Kansas

2 WATER WELL OWNER: **Pepsi Cola Bottling**
 RR#, St. Address, Box # : **PO Box 460** Board of Agriculture, Division of Water Resources
 City, State, ZIP Code : **Hays, Kansas 67601** Application Number:

3 LOCATE WELL'S LOCATION WITH AN "X" IN SECTION BOX:


4 DEPTH OF COMPLETED WELL: **50** ft. ELEVATION: **0**
 Depth(s) Groundwater Encountered 1. **38** ft. 2. _____ ft. 3. _____ ft.
 WELL'S STATIC WATER LEVEL _____ ft. below land surface measured on mo/day/yr
 Pump test data: Well water was **NA** ft. after _____ hours pumping _____ gpm
 Est. Yield **NA** gpm: Well water was _____ ft. after _____ hours pumping _____ gpm
 Bore Hole Diameter **72** in. to **40** ft. and **8** in. to **50** ft.
 WELL WATER TO BE USED AS: 5 Public water supply 8 Air conditioning 11 Injection well
 1 Domestic 3 Feedlot 6 Oil field water supply 9 Dewatering 12 Other (Specify below)
 2 Irrigation 4 Industrial 7 Lawn and garden only **10 Monitoring well**
 Was a chemical/bacteriological sample submitted to Department? Yes.....No...... If yes, mo/day/yr sample was submitted
 Water Well Disinfected? Yes _____ No

5 TYPE OF BLANK CASING USED:
 1 Steel 3 RMP (SR) 5 Wrought iron 8 Concrete tile CASING JOINTS: Glued _____ Clamped _____
2 PVC 4 ABS 6 Asbestos-Cement 9 Other (specify below) Welded _____
 7 Fiberglass Threaded
 Blank casing diameter **10** in. to **40** ft. Dia **2** in. to **48** ft. Dia _____ in. to _____ ft.
 Casing height above land surface **30** in., weight _____ lbs./ft. Wall thickness or gauge No. **Sch. 40**
 TYPE OF SCREEN OR PERFORATION MATERIAL **7 PVC** 10 Asbestos-cement
 1 Steel 3 Stainless steel 5 Fiberglass 8 RMP (SR) 11 Other (specify) _____
 2 Brass 4 Galvanized steel 6 Concrete tile 9 ABS 12 None used (open hole)
 SCREEN OR PERFORATION OPENINGS ARE:
 1 Continuous slot **3 Mill slot** 5 Gauzed wrapped 8 Saw cut 11 None (open hole)
 2 Louvered shutter 4 Key punched 6 Wire wrapped 9 Drilled holes
 7 Torch cut 10 Other (specify) _____
 SCREEN-PERFORATED INTERVALS: From **48** ft. to **50** ft., From _____ ft. to _____ ft.
 From _____ ft. to _____ ft., From _____ ft. to _____ ft.
 GRAVEL PACK INTERVALS: From **38** ft. to **50** ft., From _____ ft. to _____ ft.
 From _____ ft. to _____ ft., From _____ ft. to _____ ft.

6 GROUT MATERIAL: 1 Neat cement **2 Cement grout** **3 Bentonite** 4 Other _____
 Grout Intervals: From **0** ft. to **36** ft., From **36** ft. to **38** ft., From _____ ft. to _____ ft.
 What is the nearest source of possible contamination:
 1 Septic tank 4 Lateral lines 7 Pit privy 10 Livestock pens 14 Abandoned water well
 2 Sewer lines 5 Cess pool 8 Sewage lagoon 11 Fuel storage 15 Oil well/Gas well
 3 Watertight sewer lines 6 Seepage pit 9 Feedyard 12 Fertilizer storage **16 Other (specify below)**
 _____ **Former Tank Basin** _____
 Direction from well? **NW** How many feet? **90**

FROM	TO	LITHOLOGIC LOG	FROM	TO	PLUGGING INTERVALS
0	2.5	Clay, Brown			This well is a dual completed well with 2" air sparge and 4" SVE wells inside a 72" diameter borehole. WWC-5 forms for 4" SVE wells are separate. See attached drawing.
2.5	4.5	Clay, Brown			
4.5	32	Clay, Brown			
32	50	Clay,			
					AS7, Tag # 00343271, Abovegrade
					Project Name: Pepsi-Cola Bottling Company - Remedial
					GeoCore # 708, KDHE # U6 026 00066B

7 CONTRACTOR'S OR LANDOWNER'S CERTIFICATION: This water well was **1** constructed, (2) reconstructed, or (3) plugged under my jurisdiction and was completed on (mo/day/year) **4/19/2002** and this record is true to the best of my knowledge and belief.
 Kansas Water Well Contractor's License No. **527** This Water Well Record was completed on (mo/day/yr) **5/2/2002**
 under the business name of **GeoCore Services, Inc.** by (signature) *Dale Kell*

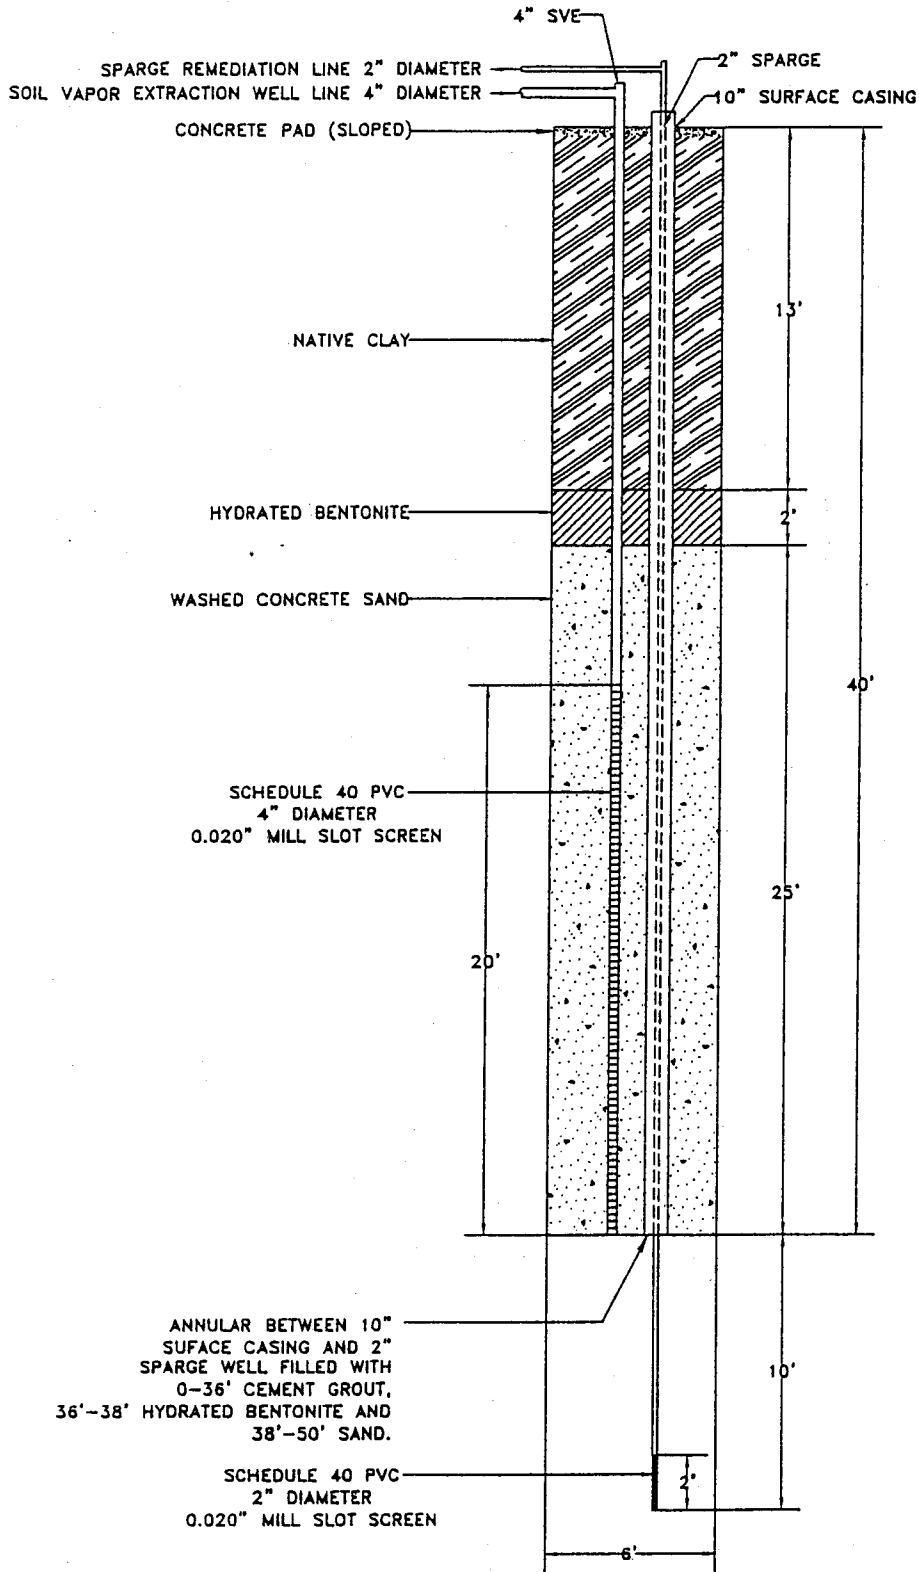

RECEIVED

MAY 08 2002

BUREAU OF WATER

NOTE: DRAWING IS NOT TO SCALE

ALL WELL MATERIALS TO BE SCHEDULE 40 PVC.

GEOCORE SERVICES, INC.

P.O. BOX 386

(785) 826-1616

SALINA, KANSAS

WELL ASBUILT DRAWING

GEOCORE PROJECT NO.

SITE: PEPSI-COLA BOTTLING COMPANY

DATE: 7-23-01

LOCATION: HAYS, KANSAS

REVISED: 5-3-02

SPOT:

DRAFTER: TDF

FILE: PEPSI.dwg

