


1 LOCATION OF WATER WELL: Fraction NW ¼ SE ¼ SE ¼ Section Number 3 Township Number T 14 S Range Number R 18 EW

Distance and direction from nearest town or city street address of well if located within city?  
**2000 Front Street, Hays, Kansas**

2 WATER WELL OWNER: **Pepsi Cola Bottling**  
 RR#, St. Address, Box # : **PO Box 460** Board of Agriculture, Division of Water Resources  
 City, State, ZIP Code : **Hays, Kansas 67601** Application Number:

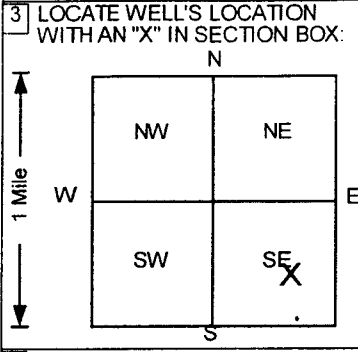


4 DEPTH OF COMPLETED WELL . . . . . 40 . . . . . ft. ELEVATION: . . . . . 0 . . . . . ft.  
 Depth(s) Groundwater Encountered 1. . . . . 38 . . . . . ft. 2. . . . . ft. 3. . . . . ft.  
 WELL'S STATIC WATER LEVEL . . . . . ft. below land surface measured on mo/day/yr . . . . .  
 Pump test data: Well water was . . . . . NA . . . . . ft. after . . . . . hours pumping . . . . . gpm  
 Est. Yield . . . . . NA . . . . . gpm: Well water was . . . . . ft. after . . . . . hours pumping . . . . . gpm  
 Bore Hole Diameter . . . . . 72 . . . . . in. to . . . . . 40 . . . . . ft., and . . . . . in. to . . . . . ft.  
 WELL WATER TO BE USED AS: 5 Public water supply 8 Air conditioning 11 Injection well  
 1 Domestic 3 Feedlot 6 Oil field water supply 9 Dewatering 12 Other (Specify below)  
 2 Irrigation 4 Industrial 7 Lawn and garden only 10 Monitoring well  
 Was a chemical/bacteriological sample submitted to Department? Yes.....No...✓; If yes, mo/day/yr sample was submitted  
 Water Well Disinfected? Yes No ✓

5 TYPE OF BLANK CASING USED: 5 Wrought iron 8 Concrete tile CASING JOINTS: Glued . . . . . Clamped . . . . .  
 1 Steel 3 RMP (SR) 6 Asbestos-Cement 9 Other (specify below) Welded . . . . .  
 2 PVC 4 ABS 7 Fiberglass . . . . . Threaded. ✓  
 Blank casing diameter . . . . . 4 . . . . . in. to . . . . . 20 . . . . . ft., Dia . . . . . in. to . . . . . ft., Dia . . . . . in. to . . . . . ft.  
 Casing height above land surface . . . . . 24 . . . . . in., weight . . . . . lbs./ft. Wall thickness or gauge No. . . . . Sch. 40 . . . . .  
 TYPE OF SCREEN OR PERFORATION MATERIAL 7 PVC 10 Asbestos-cement  
 1 Steel 3 Stainless steel 5 Fiberglass 8 RMP (SR) 11 Other (specify) . . . . .  
 2 Brass 4 Galvanized steel 6 Concrete tile 9 ABS 12 None used (open hole)  
 SCREEN OR PERFORATION OPENINGS ARE: 5 Gauzed wrapped 8 Saw cut 11 None (open hole)  
 1 Continuous slot 3 Mill slot 6 Wire wrapped 9 Drilled holes  
 2 Louvered shutter 4 Key punched 7 Torch cut 10 Other (specify) . . . . .  
 SCREEN-PERFORATED INTERVALS: From . . . . . 20 . . . . . ft. to . . . . . 40 . . . . . ft., From . . . . . ft. to . . . . . ft.  
 GRAVEL PACK INTERVALS: From . . . . . 15 . . . . . ft. to . . . . . 40 . . . . . ft., From . . . . . ft. to . . . . . ft.  
 From . . . . . ft. to . . . . . ft., From . . . . . ft. to . . . . . ft.

6 GROUT MATERIAL: 1 Neat cement 2 Cement grout 3 Bentonite 4 Other Native Clay  
 Grout Intervals: From . . . . . 13 . . . . . ft. to . . . . . 15 . . . . . ft., From . . . . . 0 . . . . . ft. to . . . . . 15 . . . . . ft., From . . . . . ft. to . . . . . ft.  
 What is the nearest source of possible contamination:  
 1 Septic tank 4 Lateral lines 7 Pit privy 10 Livestock pens 14 Abandoned water well  
 2 Sewer lines 5 Cess pool 8 Sewage lagoon 11 Fuel storage 15 Oil well/Gas well  
 3 Watertight sewer lines 6 Seepage pit 9 Feedyard 12 Fertilizer storage 16 Other (specify below)  
 Direction from well? **W** How many feet? **65** **Former Tank Basin**

| FROM | TO | LITHOLOGIC LOG | FROM | TO | PLUGGING INTERVALS   |
|------|----|----------------|------|----|--|
| 0    | 3  | Clay, Brown    |      |    | This well is a dual completed well with 2" air sparge and 4" SVE wells inside a 72" borehole. WWCC-5 forms for 2" air sparge wells are separate. See attached drawing. |
| 3    | 13 | Clay, Brown    |      |    |  |
| 13   | 30 | Clay,          |      |    |  |
| 30   | 40 | Clay,          |      |    |  |
|      |    |                |      |    | SVE4, Tag # 00343318, Abovegrade   |
|      |    |                |      |    | Project Name: Pepsi-Cola Bottling Company - Remedial   |
|      |    |                |      |    | GeoCore # 708, KDHE # U6 026 00066B  |

7 CONTRACTOR'S OR LANDOWNER'S CERTIFICATION: This water well was (1) constructed, (2) reconstructed, or (3) plugged under my jurisdiction and was completed on (mo/day/year) . . . . . 4/19/2002 . . . . . and this record is true to the best of my knowledge and belief.  
 Kansas Water Well Contractor's License No. . . . . 527 . . . . . This Water Well Record was completed on (mo/day/yr) . . . . . 5/2/2002 . . . . .  
 under the business name of **GeoCore Services, Inc.** by (signature) *[Signature]*

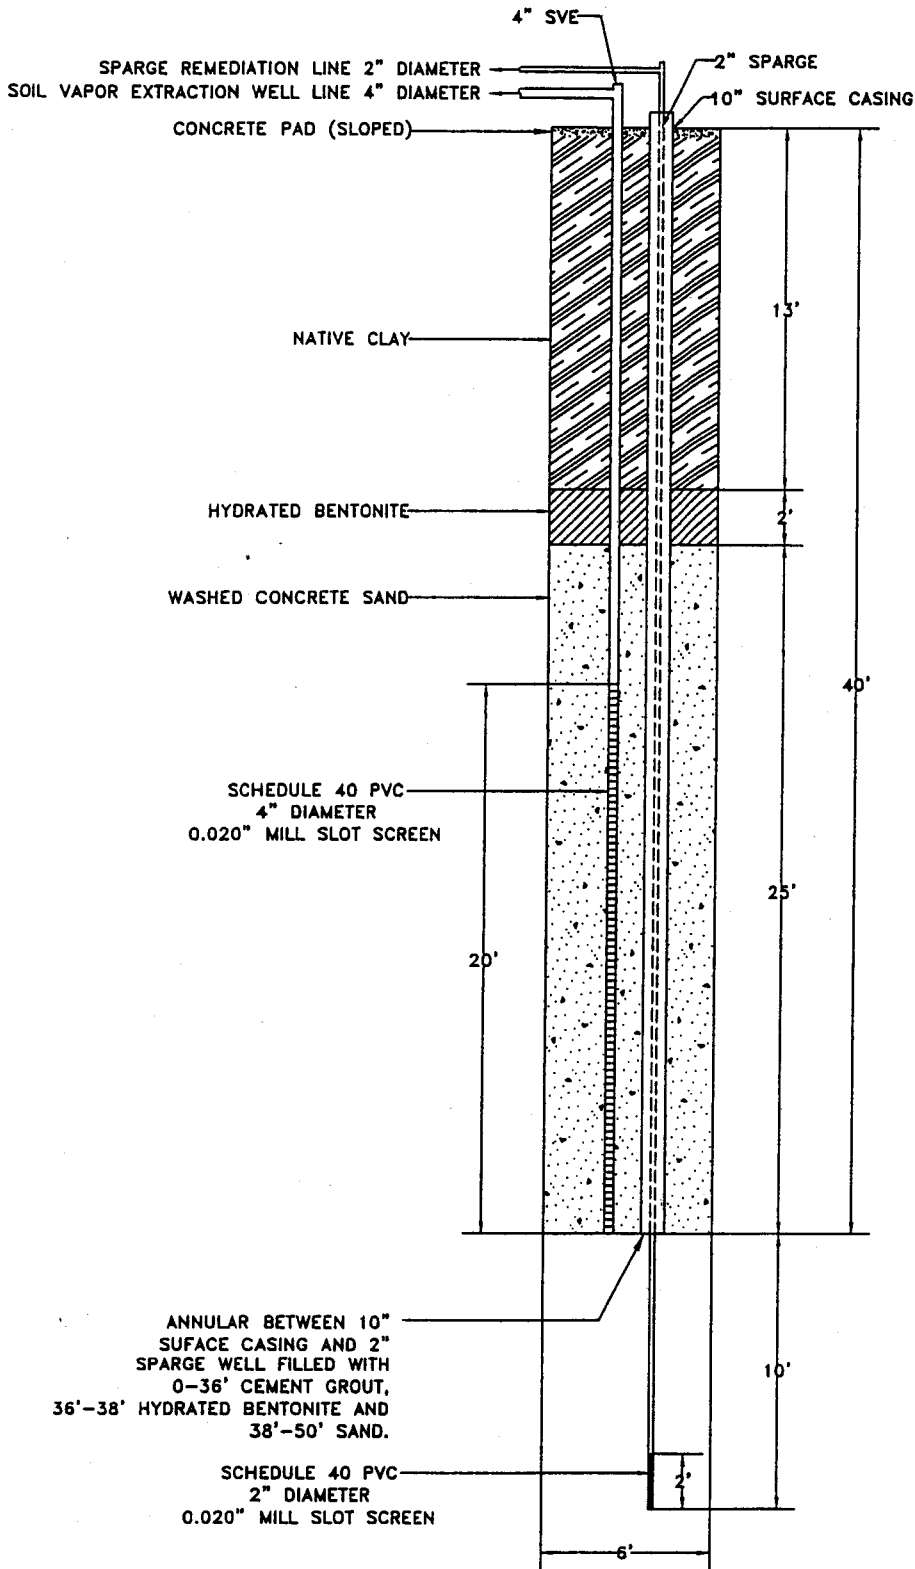

RECEIVED

MAY 08 2002

BUREAU OF WATER

NOTE: DRAWING IS NOT TO SCALE

ALL WELL MATERIALS TO BE SCHEDULE 40 PVC.

**GEOCORE SERVICES, INC.**

P.O. BOX 386

(785) 826-1616

SALINA, KANSAS

WELL ASBUILT DRAWING

GEOCORE PROJECT NO.

SITE: PEPSI-COLA BOTTLING COMPANY

DATE: 7-23-01

LOCATION: HAYS, KANSAS

REVISED: 5-3-02

SPOT:

DRAFTER: TDF

FILE: PEPSI.dwg

