
				WWC-5		vision of Wate		MW-5				
Original Record Correction Change in Well Use						Resources App. No.   Well ID     Section Number   Township Number   Range Number						
1 LOCATION OF WATER WELL: County: SALINEFraction ½Section Number 1Township Number Range NumberRange Number R												
2 WELLOWNER: Last Name: CHOPP First: MARION Street or Rural Address where well is located (if unknown, distance and												
Business: MARION L CHOPP TRUST direction from nearest town or intersection): If at owner's address, check here:												
Address: P.O. BOX 167 Address: 616 E. NORTH STREET SALINA KS 67401												
City:	SALINA		State: KS	ZIP: 67402-0167								
3 LOCAT					45 0		38.8481	20				
WITH "				IPLETED WELL:								
<b>SECTION BOX:</b> N Depth(s) Groundwater Encountered: 1) 2) $ft. 3$ $ft.$ , or 4)						Dry Well Horizontal Datum: WGS 84 NAD 83 NAD 27						
1	1	WELL'S ST	TATIC WA	$\begin{array}{cccccccccccccccccccccccccccccccccccc$	2 ft.		Source for Latitude/Longitude:					
		below l	and surface	, measured on (mo-day-	yr). 01/9/19	·	☐ GPS (unit make/model:) (WAAS enabled? ☐ Yes ☐ No)					
NW	NE	above la	and surface.	, measured on (mo-day-	(r)							
		· ·		vater was ft		Land Survey 🔲 Topographic Map						
W	E	after		s pumping			nline Mapper:					
sw	SE	after		s pumping								
		Estimated Y	'ield'	onm		6 Elevation:ft. 🗌 Ground Level 🔲 TOO						
	S	Bore Hole I	Bore Hole Diameter:4 in. to20			ft. and Source: $\Box$ Land Survey $\Box$ GPS $\Box$ Top						
1 n				3.25 in. to 45	<u>ft.</u>		□ Other					
1		D BE USED A										
1. Domestic:				ter Supply: well ID				ease				
	Household 6. Dewatering: how many wells?   Lawn & Garden 7. Aquifer Recharge: well ID											
	L					12. Geoth	ermal: how many bore	1				
	2. □ Irrigation 9. Environmental Remediation: well ID					a) Cl	osed Loop 🔲 Horizon	tal 🔲 Vertical				
3. 🗌 Feedlo			] Air Sparge		xtraction			ischarge 🔲 Inj. of Water				
4. 🗌 Industr			Recovery									
				itted to KDHE?	Yes 📕 No	If yes, date	sample was submitte	ed:				
		? 🗆 Yes 📕										
8 TYPE C	F CASING	SUSED: 🗆 S	teel PV	C 🔲 Other	CASI	NG JOINTS	: 🗌 Glued 🔲 Clampe	d 🗌 Welded 🔳 Threaded				
Casing diam	eter	in. to		Diameter	in. to	Wall thick	eter in. to	tt. 40				
TYPE OF	CREEN O	R PERFORA	ΓΙΟΝ ΜΔ'		108./11.	wall unce	ness of gauge No					
		inless Steel				□ Oth	er (Specify)					
Brass		vanized Steel			sed (open hol		(					
SCREEN C	OR PERFOR	RATION OPE										
	uous Slot	Mill Slot					Other (Specify)					
	red Shutter	Key Punch	hed 🗌 W	ire Wrapped Sav	w Cut	None (Open H	ole)	ft. to ft.				
SCREEN-F	EKFUKAI	CV NITERVA	ALS: From	$1.33$ $\alpha$ to $33$ $\alpha$ to $46$	II., From	n. u	$\beta \dots \dots$	ft. to ft.				
	MATEDI		ALS: From	$\frac{1}{1} \dots \frac{1}{1} \dots \dots \frac{1}{1} \dots \frac{1}{1} \dots \frac{1}{1} \dots \frac{1}{1} \dots \frac{1}{1} \dots \dots \frac{1}{1} \dots \dots \dots \frac{1}{1} \dots \dots$	II., From		TED FROM 0 TO 3FT					
Grout Interv	als From	$\frac{3}{10}$ ft to	33	Cement grout Ber ft., From	ft to	ft From	ft to	ft				
Nearest sou	rce of possib	le contaminati	on:			10., 1 10111						
Septic 2	Tank		Lateral Line	s 🗌 Pit Privy		Livestock Pe		cide Storage				
	Lines		Cess Pool	Sewage Lag	goon 🗌	Fuel Storage	Aband	oned Water Well				
Watert	ight Sewer Li	nes 🗋 S	Seepage Pit	Sewage Lag		Fertilizer Sto	rage 🗌 Oil We	ell/Gas Well				
Direction fro	m well?			Distance from we	···· 11?		Ĥ					
10 FROM	TO		ITHOLO		FROM			r PLUGGING INTERVALS				
0	.5	FILL MATERIAL			33		SAND WITH LITTLE SILT,					
.5	2.5	SILT WITH CLAY	, BROWN, M	IOIST	34	45	SAND WITH LITTLE FINE	GRAVEL				
2.5		SILT WITH LITTL	E CLAY, BR	ROWN								
	21	SILT WITH VERY	FINE SAND	), TAN								
		SAND WITH SOM		١								
		SILT AND CLAY,										
24.5		SILT WITH LITTL			Notes:							
28												
29 33 SILT AND SAND WTH LITTLE CLAY												
11 CONTRACTOR'S OR LANDOWNER'S CERTIFICATION: This water well was constructed, reconstructed, or plugged under my jurisdiction and was completed on (mo-day-year) 01/7/2019 and this record is true to the best of my knowledge and belief.												
Kansas Water Well Contractor's License No. <sup>709</sup> . This Water Well Record was completed on (mo-day-year) 01/10/2019												
Kansas Water Well Contractor's License No. 709 This Water Well Record was completed on (mo-day-year) 01/10/2019 under the business name of PLAINS ENVIRONMENTAL SERVICES, INC. Signature												
Mail 1 white copy along with a fee of \$5.00 for each constructed well to: Kansas Department of Health and Environment, Bureau of Water, GWTS Section, 1000 SW Jackson St., Suite 420, Topeka, Kansas 66612-1367. Mail one to Water Well Owner and retain one for your records. Telephone 785-296-5524.												
Visit us at http	o://www.kdhek	s.gov/waterwell/i	ndex.html		KSA 82a-12	212		ACVISCU //10/2013				

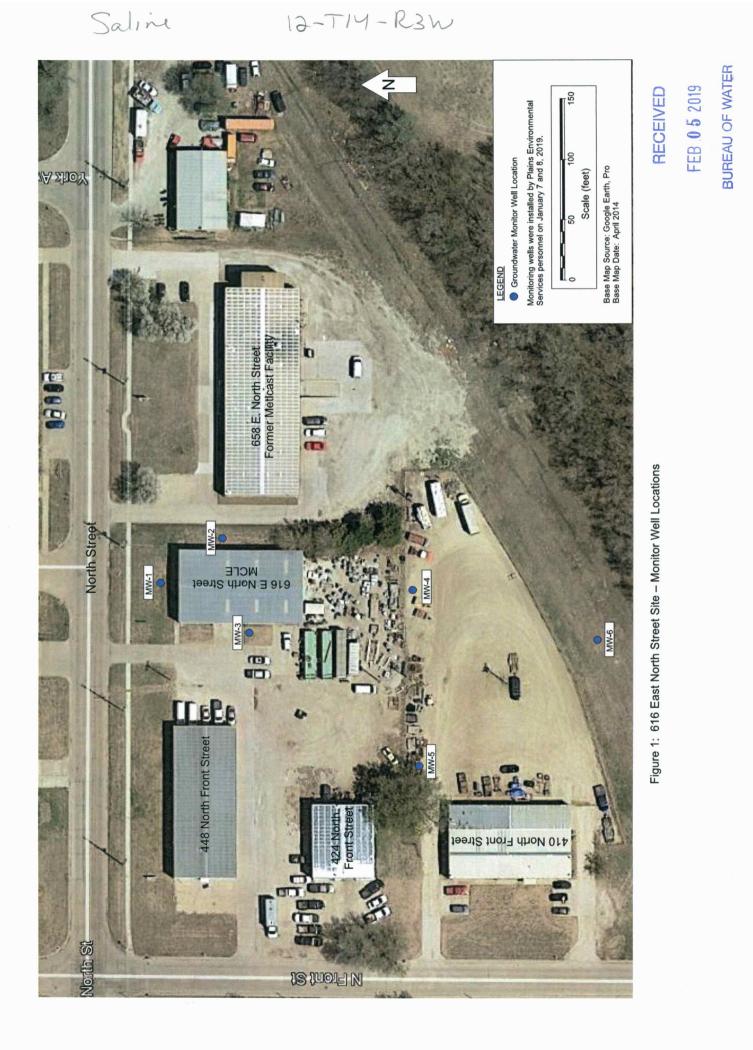

Saline

12-T14-R3W

742 DUVALL AVE SALINA, KANSAS 67401 www.kveng.com TEL: 785-823-3400

## MOINTOR WELL REPORT

616 EAST NORTH STREET- SALINA, KANSAS

KVE PROJECT NUMBER E19S2213

MONITOR WELL	COORE	INATES	ELEVATIO	NS	DISTANCE FROM SE COR. S12-T14S-R3W	
NUMBER	NORTHING	EASTING	TOP OF CASING	GROUND	NORTH	WEST
MW-1	187951.05	1425657.70	1222.47	1222.9	2582'	2315'
MW-2	187901.80	1425699.40	1222.50	1222.7	2532'	2273'
MW-3	187881.85	1425623.70	1222.21	1222.8	2513'	2349'
MW-4	187728.32	1425657.08	1221.75	1222.0	2359'	2316′
MW-5	187740.55	1425517.67	1221.55	1221.8	2371'	2455'
MW-6	187595.99	1425627.53	1222.62	1223.0	2227'	2345'

- (1) COORDINATES ARE TO THE NORTH SIDE OF CASING PIPE. COORDINATES ARE BASED ON KANSAS STATE PLANE NORTH, ZONE 1501, NAD 1983 U.S. SURVEY FEET.
- (2) ELEVATIONS ARE BASED ON NAVD 1988 U.S. SURVEY FEET.

CERTIFICATION: THIS SURVEY WAS PERFORMED BY ME OR UNDER MY DIRECT SUPERVISION AND IS TRUE AND ACCURATE TO THE BEST OF MY BELIEF.



RECEIVED

FEB 05 2019

BUREAU OF WATER