
WATER WELL I	RECORD Form	WWC-5		ision of Water			MW-7	
Original Record		ige in Well Use		urces App. No.	Ta 1: 37 1	Well ID	N	
1 LOCATION OF V	VATER WELL:	Fraction	1	tion Number	Township Numb		Number	
County: Saline					4 13 T 14 S R 3 ☐ E ■ W t or Rural Address where well is located (if unknown, distance and			
2 WELL OWNER: Last Name: Patel Business: Palak, LLC First: Kiritkumar Street or Rural Address where well is located (if unknown, distance and direction from nearest town or intersection): If at owner's address, check here:							eck here:	
Address: 418 E iron Ave.								
Address:								
City: Salina	State: KS	ZIP: 67401						
3 LOCATE WELL	4 DEPTH OF CONFLETED WELL:							
WITH "X" IN SECTION BOX:	Depth(s) Groundwater	Depth(s) Groundwater Encountered: 1)						
N SECTION BOX.	2) ft.	2)						
	WELL'S STATIC WA	WELL'S STATIC WATER LEVEL: 25.96 ft. Source for Latitude/Longitude: Source for Latitude/Longitude: GPS (unit make/model:						
NW NE	□ above land surface, measured on (mo-day-yr)							
NW NE	Pump test data: Well		Survey Topogr					
W X E	after hours pumping gpm							
SW SE	Well water was							
	after						evel 🔳 TOC	
S	Bore Hole Diameter: . 8.75 in. to							
1 mile	1 mile in. to ft.							
7 WELL WATER TO BE USED AS: 1. Domestic: 5. □ Public Water Supply: well ID								
1. Domestic:		/ater Supply: well ID						
☐ Household ☐ Lawn & Garden	6. Dewater		11. Test Hole: well ID					
Livestock	8. Monitori	Recharge: well IDng: well ID	/-7	12. Geothermal: how many bores?				
2. Irrigation		ital Remediation: well ID		a) Closed Loop				
3. Feedlot	☐ Air Sparge ☐ Soil Vapor Extraction ☐ D) Open Loop ☐ St							
4. Industrial	☐ Recover	·			(specify):			
Was a chemical/bacteriological sample submitted to KDHE? ☐ Yes ■ No If yes, date sample was submitted:								
Water well disinfected? Yes No								
8 TYPE OF CASING USED: ☐ Steel ■ PVC ☐ Other								
Casing diameter 2 in to 18 ft., Diameter in to ft., Diameter in to ft., Diameter in to ft., Diameter in to ft., Casing height above land surface 0 in Weight lbs./ft. Wall thickness or gauge No. SCh. 49.								
TYPE OF SCREEN OR PERFORATION MATERIAL:								
☐ Steel ☐ Stainless Steel ☐ Fiberglass ■ PVC ☐ Other (Specify)								
☐ Brass ☐ Galvanized Steel ☐ Concrete tile ☐ None used (open hole)								
SCREEN OR PERFORATION OPENINGS ARE:								
☐ Continuous Slot								
Louvered Shutter								
GRAVEL PACK INTERVALS: From								
9 GROUT MATERIAL: Neat cement Cement grout Bentonite Other.								
Grout Intervals: From 0 ft. to 16 ft., From ft. to ft., From ft. to ft., From ft. to ft.								
Nearest source of possible contamination:								
☐ Septic Tank ☐ Lateral Lines ☐ Pit Privy ☐ Livestock Pens ☐ Insecticide Storage								
☐ Sewer Lines ☐ Cess Pool ☐ Sewage Lagoon ☐ Fuel Storage ☐ Abandoned Water Well ☐ Watertight Sewer Lines ☐ Seepage Pit ☐ Feedyard ☐ Fertilizer Storage ☐ Oil Well/Gas Well								
□ Watertight Sewer Lines □ Seepage Pit □ Feetilizer Storage □ Oil Well/Gas Well □ Other (Specify) □ Other (Specify)								
Direction from well? Distance from well? ft.								
10 FROM TO	LITHOLO	GIC LOG	FROM	TO LI	THO. LOG (cont.) o	r PLUGGING I	INTERVALS	
	Clay, dark brown, silt	y, moist to wet,		KC	HE US-085-	15072		
	plastic, no odor				·			
	Sand, brown, fine gra	ıın, wet to saturated,						
	no odor Clay, brown, silty, sa	turated plactic ac	 					
	Clay, brown, silty, sa	urated, plastic, no	 					
	odor Silt brown candy m	oist no odor	Notes	1				
16 19 19 33	Clay brown eith so	ilt, brown, sandy, moist, no odor Notes:						
	day, brown, silty, saturated, plastic o odor							
11 CONTRACTOR'S OR LANDOWNER'S CERTIFICATION: This water well was constructed. Treconstructed, or plugged								
under my jurisdiction and was completed on (mo-day-year) 19-23-2019 and this record is true to the best of my knowledge and belief.								
Kansas Water Well Contractor's License No. 604 This Water Well Record was completed on (mo-day-year)								
under the business nam	ne of ⊑IIVIIQUMBUIALI	THULLY DELYCE, ITC	as Denartment	of Health and Fro	ronment Bureau of W	Vater, GWTS Sec	tion.	
Mail 1 white copy along with a fee of \$5.00 for each constructed well to: Kansas Department of Health and Environment, Bureau of Water, GWTS Section, 1000 SW Jackson St., Suite 420, Topeka, Kansas 66612-1367. Mail one to Water Well Owner and retain one for your records. Telephone 785-296-5524.								
Visit us at http://www.kdheks.gov/waterwell/index.html KSA 82a-1212 Revised 7/10/2015								



CHECKED BY CC FEBRUARY 2020



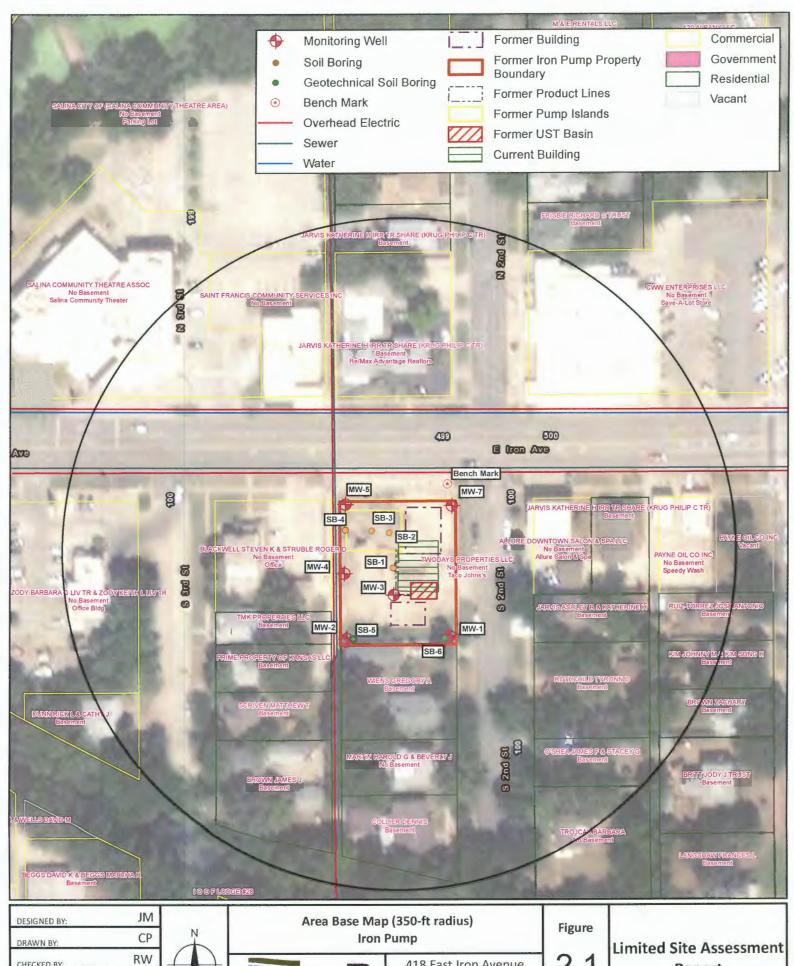

418 East Iron Avenue Salina, Kansas U5-085-15072

2.1

Report