
WATER WELL I		rm WWC-5		vision of Water		MW-2		
Original Record		Change in Well Use		ources App. No.	<u> </u>	Well ID		
1 LOCATION OF V	VATER WELL:	Fraction		ction Number	Township Numb			
County: Saline		SW¼ NE¼ NE½		13	T 14 S	R 3 □E ■ W		
2 WELL OWNER: Last Name: Patel First: Kiritkumar Street or Rural Address where well is located (if unknown, distance and								
Business: Palak, LLC direction from nearest town or intersection): If at owner's address, check here:								
Address: 418 E iro	n Ave.							
City: Salina	State:	KS ZIP: 67401						
3 LOCATE WELL	<del></del>		25 0		38 8300	8		
WITH "X" IN		COMPLETED WELL:		5 Latitude: 38.83998(decimal degrees) Longitude: -97.60498(decimal degrees)				
SECTION BOX:	1 * '/	water Encountered: 1) ft. 3) ft., or 4)[	_	Longitu	Horizontal Datum: WGS 84 NAD 83 NAD 27			
N	WELL'S STATIO	WATER LEVEL: 27	45 n		or Latitude/Longitude			
	below land s	urface, measured on (mo-day	<sub>-yr)</sub> 10-25-201	9 GPS	GPS (unit make/model:)			
NW NE		urface, measured on (mo-day		· (WAAS enabled? ☐ Yes ☐ No)				
		Well water was		☐ Land Survey ☐ Topographic Map				
W E		hours pumping		Onli	Online Mapper:			
SW SE	Well water was ft.							
		after hours pumping gpm Estimated Yield:gpm			6 Elevation: 1222.04 ft. ☐ Ground Level ■ TOC			
S	Bore Hole Diame	ft and	Source: ■ Land Survey ☐ GPS ☐ Topographic Map					
1 mile	Bore Front Brazille	in. to	ft.		Other			
7 WELL WATER TO BE USED AS:								
1. Domestic:		lic Water Supply: well ID		10. 🔲 Oil F	ield Water Supply: le	ease		
☐ Household	6. 🔲 Dew	ratering: how many wells?		<ol><li>Test Hol</li></ol>	e: well ID			
☐ Lawn & Garden	<u> </u>			☐ Cased ☐ Uncased ☐ Geotechnical				
Livestock	8. Monitoring: well ID M. ユ Z			12. Geothermal: how many bores?				
2. ☐ Irrigation 3. ☐ Feedlot	9. Environmental Remediation: well ID  ☐ Air Sparge ☐ Soil Vapor Extra			a) Closed Loop ☐ Horizontal ☐ Vertical b) Open Loop ☐ Surface Discharge ☐ Inj. of Water				
4. ☐ Industrial	☐ Reco		Extraction			scharge in hij. of water		
L								
Was a chemical/bacteriological sample submitted to KDHE? ☐ Yes ■ No If yes, date sample was submitted:								
Water well disinfected? ☐ Yes ■ No								
8 TYPE OF CASING USED: ☐ Steel ☐ PVC ☐ Other								
Casing diameter 2 in to 20 ft., Diameter in to ft., Diameter in to ft., Diameter in to ft.  Casing height above land surface 0 in Weight lbs./ft. Wall thickness or gauge No. SCh. 40.								
TYPE OF SCREEN OR PERFORATION MATERIAL:								
☐ Steel ☐ Stainless Steel ☐ Fiberglass ■ PVC ☐ Other (Specify)								
☐ Brass ☐ Galvanized Steel ☐ Concrete tile ☐ None used (open hole)								
SCREEN OR PERFORATION OPENINGS ARE:								
☐ Continuous Slot ■ Mill Slot ☐ Gauze Wrapped ☐ Torch Cut ☐ Drilled Holes ☐ Other (Specify)								
☐ Louvered Shutter ☐ Key Punched ☐ Wire Wrapped ☐ Saw Cut ☐ None (Open Hole)								
SCREEN-PERFORATED INTERVALS: From .20 ft. to .35 ft., From								
GRAVEL PACK INTERVALS: From 18 ft. to 35 ft., From ft. to ft., From ft. to ft., From ft. to ft.								
9 GROUT MATERIAL: ☐ Neat cement ☐ Cement grout ■ Bentonite ☐ Other								
Grout Intervals: From 0 ft. to 18 ft., From ft. to ft., From ft. to ft.								
Nearest source of possible contamination:								
☐ Septic Tank ☐ Lateral Lines ☐ Pit Privy ☐ Livestock Pens ☐ Insecticide Storage								
□ Sewer Lines       □ Cess Pool       □ Sewage Lagoon       □ Fuel Storage       □ Abandoned Water Well         □ Watertight Sewer Lines       □ Seepage Pit       □ Feedyard       □ Fertilizer Storage       □ Oil Well/Gas Well								
Other (Specify)								
		Distance from w			ft.			
10 FROM TO		OLOGIC LOG	FROM			PLUGGING INTERVALS		
0 10		, silty, moist, no odor	]					
		, fine grain, moist,						
	no odor							
17 23	Silty sand, light b	rown, fine grain, moist						
	no odor							
23 35	Sand, light brown	, fine to medium, wet						
	to saturated, no o		Notes: K	DHE US-	185-15072			
		· <u>, , , , , , , , , , , , , , , , , , ,</u>	ገ '	(	J =			
11 CONTRACTOR'S OR LANDOWNER'S CERTIFICATION: This water well was constructed, reconstructed, or plugged								
under my jurisdiction and was completed on (mo-day-year) 10-24-2019 and this record is true to the best of my knowledge and belief.								
Kansas Water Well Contractor's License No. 604 This Water Well Record was completed on (mo-day-year)								
under the business nam	ong with a fee of \$5 00	for each constructed well to: Vo.	SI	of Health and Fra	vironment Ruresu of We	ater, GWTS Section		
Mail 1 white copy along with a fee of \$5.00 for each constructed well to: Kansas Department of Health and Environment, Bureau of Water, GWTS Section, 1000 SW Jackson St., Suite 420, Topeka, Kansas 66612-1367. Mail one to Water Well Owner and retain one for your records. Telephone 785-296-5524.								
Visit us at http://www.kdhcks.gov/waterwell/index.html KSA 82a-1212 Revised 7/10/2015								



CHECKED BY CC FEBRUARY 2020



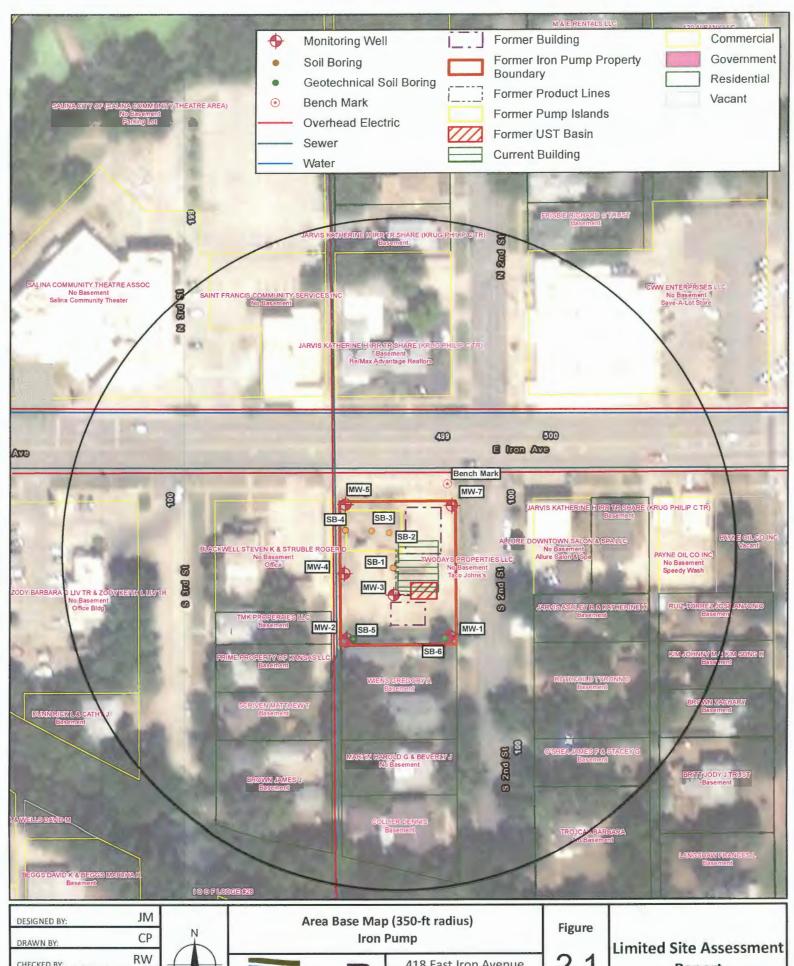

418 East Iron Avenue Salina, Kansas U5-085-15072

2.1

Report