

WATER WELL RECORD

Form WWC-5

Division of Water Resources App. No.


Well ID

MW13

Original Record [] Correction [X] Change in Well Ust []

1 LOCATION OF WATER WELL: County Saline, Fraction SE 1/4 SE 1/4 SW 1/4 SE 1/4, Section Number 23, Township Number T 14 S, Range Number R 3 E X W

2 WELL OWNER: Last Name: Business: KDHE (K & B Pit Stop), Address: 1000 SW Jackson, City: Topeka, State: KS, ZIP: 66612, Street or Rural Address where well is located: ~50 north of 647 W Cloud St, Salina, KS 67401

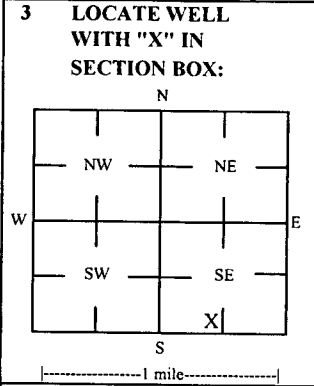

4 DEPTH OF COMPLETED WELL: 40 ft, Depth(s) Groundwater Encountered: 1) 1 ft, 2) ft, 3) ft, or 4) Dry Well, WELLS STATIC WATER LEVEL: ft, below land surface, measured on (mo-day-yr), above land surface, measured on (mo-day-yr), Pump test data: Well water was ft after hours pumping gpm, Water well was ft after hours pumping gpm, Estimated Yield: gpm, Bore Hole Diameter: 7.25 in to ft, and in to ft

5 Latitude: 38.81277 (decimal degrees), Longitude: 97.61805 (decimal degrees), Horizontal Datum: [X] WGS 84 [] NAD 83 [] NAD 27, Source for Latitude/Longitude: [] GPS (unit make/model:), (WAAS enabled? [] Yes [] No), [X] Land Survey [] Topographic Map, [] Online Mapper

6 Elevation: 1235.02 ft, [] Ground Level [X] TOC, Source: [X] Land Survey [] GPS [] Topographic Map, [] Other

7 WELL WATER TO BE USED AS: 1 Domestic: [] Household, [] Lawn & Garden, [] Livestock, 2 Irrigation, 3 Feedlot, 4 Industrial, 5 Public Water Supply: well ID, 6 Dewatering: how many wells?, 7 Aquifer Recharge: well ID, 8 [X] Monitoring: well ID MW13, 9 Environmental Remediation: well ID, [] Air Sparge, [] Soil Vapor Extractor, [] Recovery, [] Injection, 10 Oil Field Water Supply: lease, 11 Test Hole: well ID, [] Cased, [] Uncased, [] Geotechnical, 12 Geothermal: How many bores?, a) Closed Loop [] Horizontal [] Vertical, b) Open Loop [] Surface Discharge [] Inj. of Water, [] Other (specify):

Was a chemical/bacteriological sample submitted to KDHE? [] Yes [X] No, If yes, date sample was submitted:

8 TYPE OF CASING USED: [] Steel [X] PVC [] Other, CASING JOINTS: [] Glued [] Clamped [] Welded [X] Threaded, Casing diameter 2 in. to 25 ft, Diameter in. to ft, Casing height above land surface -0.28 in., Weight lbs./ft., Well thickness or gauge No, TYPE OF SCREEN OR PERFORATION MATERIAL: [] Steel [] Stainless Steel [] Fiberglass [X] PVC [] Other (Specify), [] Brass [] Galvanized Steel [] Concrete tile [] None used (open hole), SCREEN OR PERFORATION OPENINGS ARE: [] Continuous Slot [X] Mill Slot [] Gauze Wrapped [] Torch Cut [] Drilled Holes [] Other (Specify), [] Louvered Shutter [] Key Punched [] Wire Wrapped [] Saw Cut [] None (Open Hole), SCREEN-PERFORATED INTERVALS: From 25 ft. to 40 ft., From ft. to ft., From ft. to ft., GRAVEL PACK INTERVALS: From 22 ft. to 40 ft., From ft. to ft., From ft. to ft.,

9 GROUT MATERIAL: [] Neat cement [] Cement grout [X] Bentonite [X] Other Concrete: 0-0.5', Grout intervals: From 0.5 ft. to 22 ft., From ft. to ft., From ft. to ft.,

Nearest source of possible contamination: [] Septic Tank [] Lateral Lines [] Pit Privy [] Livestock Pens [] Insecticide Storage, [] Sewer Lines [] Cess Pool [] Sewage Lagoon [X] Fuel Storage [] Abandoned Water Well, [] Watertight Sewer Lines [] Seepage Pit [] Feedyard [] Fertilizer Storage [] Oil Well / Gas Well, [] Other (Specify):

Direction from well? S-SW, Distance from well? ~90 ft

Table with 6 columns: 10 FROM, TO, LITHOLOGIC LOG, FROM, TO, LITHO. LOG (cont.) or PLUGGING INTERVALS. Rows: 0-1 Concrete, 1-20 Silt, 20-30 Silty clay, 30-40 Fine sand.

Notes: KDHE ID: K&B Pit Stop ; U5-085-00367, Target of monitoring well is shallow groundwater, <20' of grout was installed at the direction of KDHE.

11 CONTRACTOR'S OR LANDOWNER'S CERTIFICATION: This water well was [X] constructed, [] reconstructed, or [] plugged under my jurisdiction and was completed on (mo-day-year) 9/21/22 and this record is true to the best of my knowledge and belief. Kansas Water Well Contractor's License No 757, This Water Well Record was completed on (mo-day-year) 10/17/22 under the business name of Larsen & Associates, Inc. Signature

Salina

NOTE: Figures exhibited within this report are only to be used within the context of this report. Placement of property lines, wells, structures, and roads is based on the available information from county appraiser maps, surveys, site visits, and/or previous vendor reports and should be considered approximate. Estimated concentration lines represent estimated contaminant concentrations based on data collected during the sampling event. Actual extent or concentration of contamination beyond the sample point is unknown.

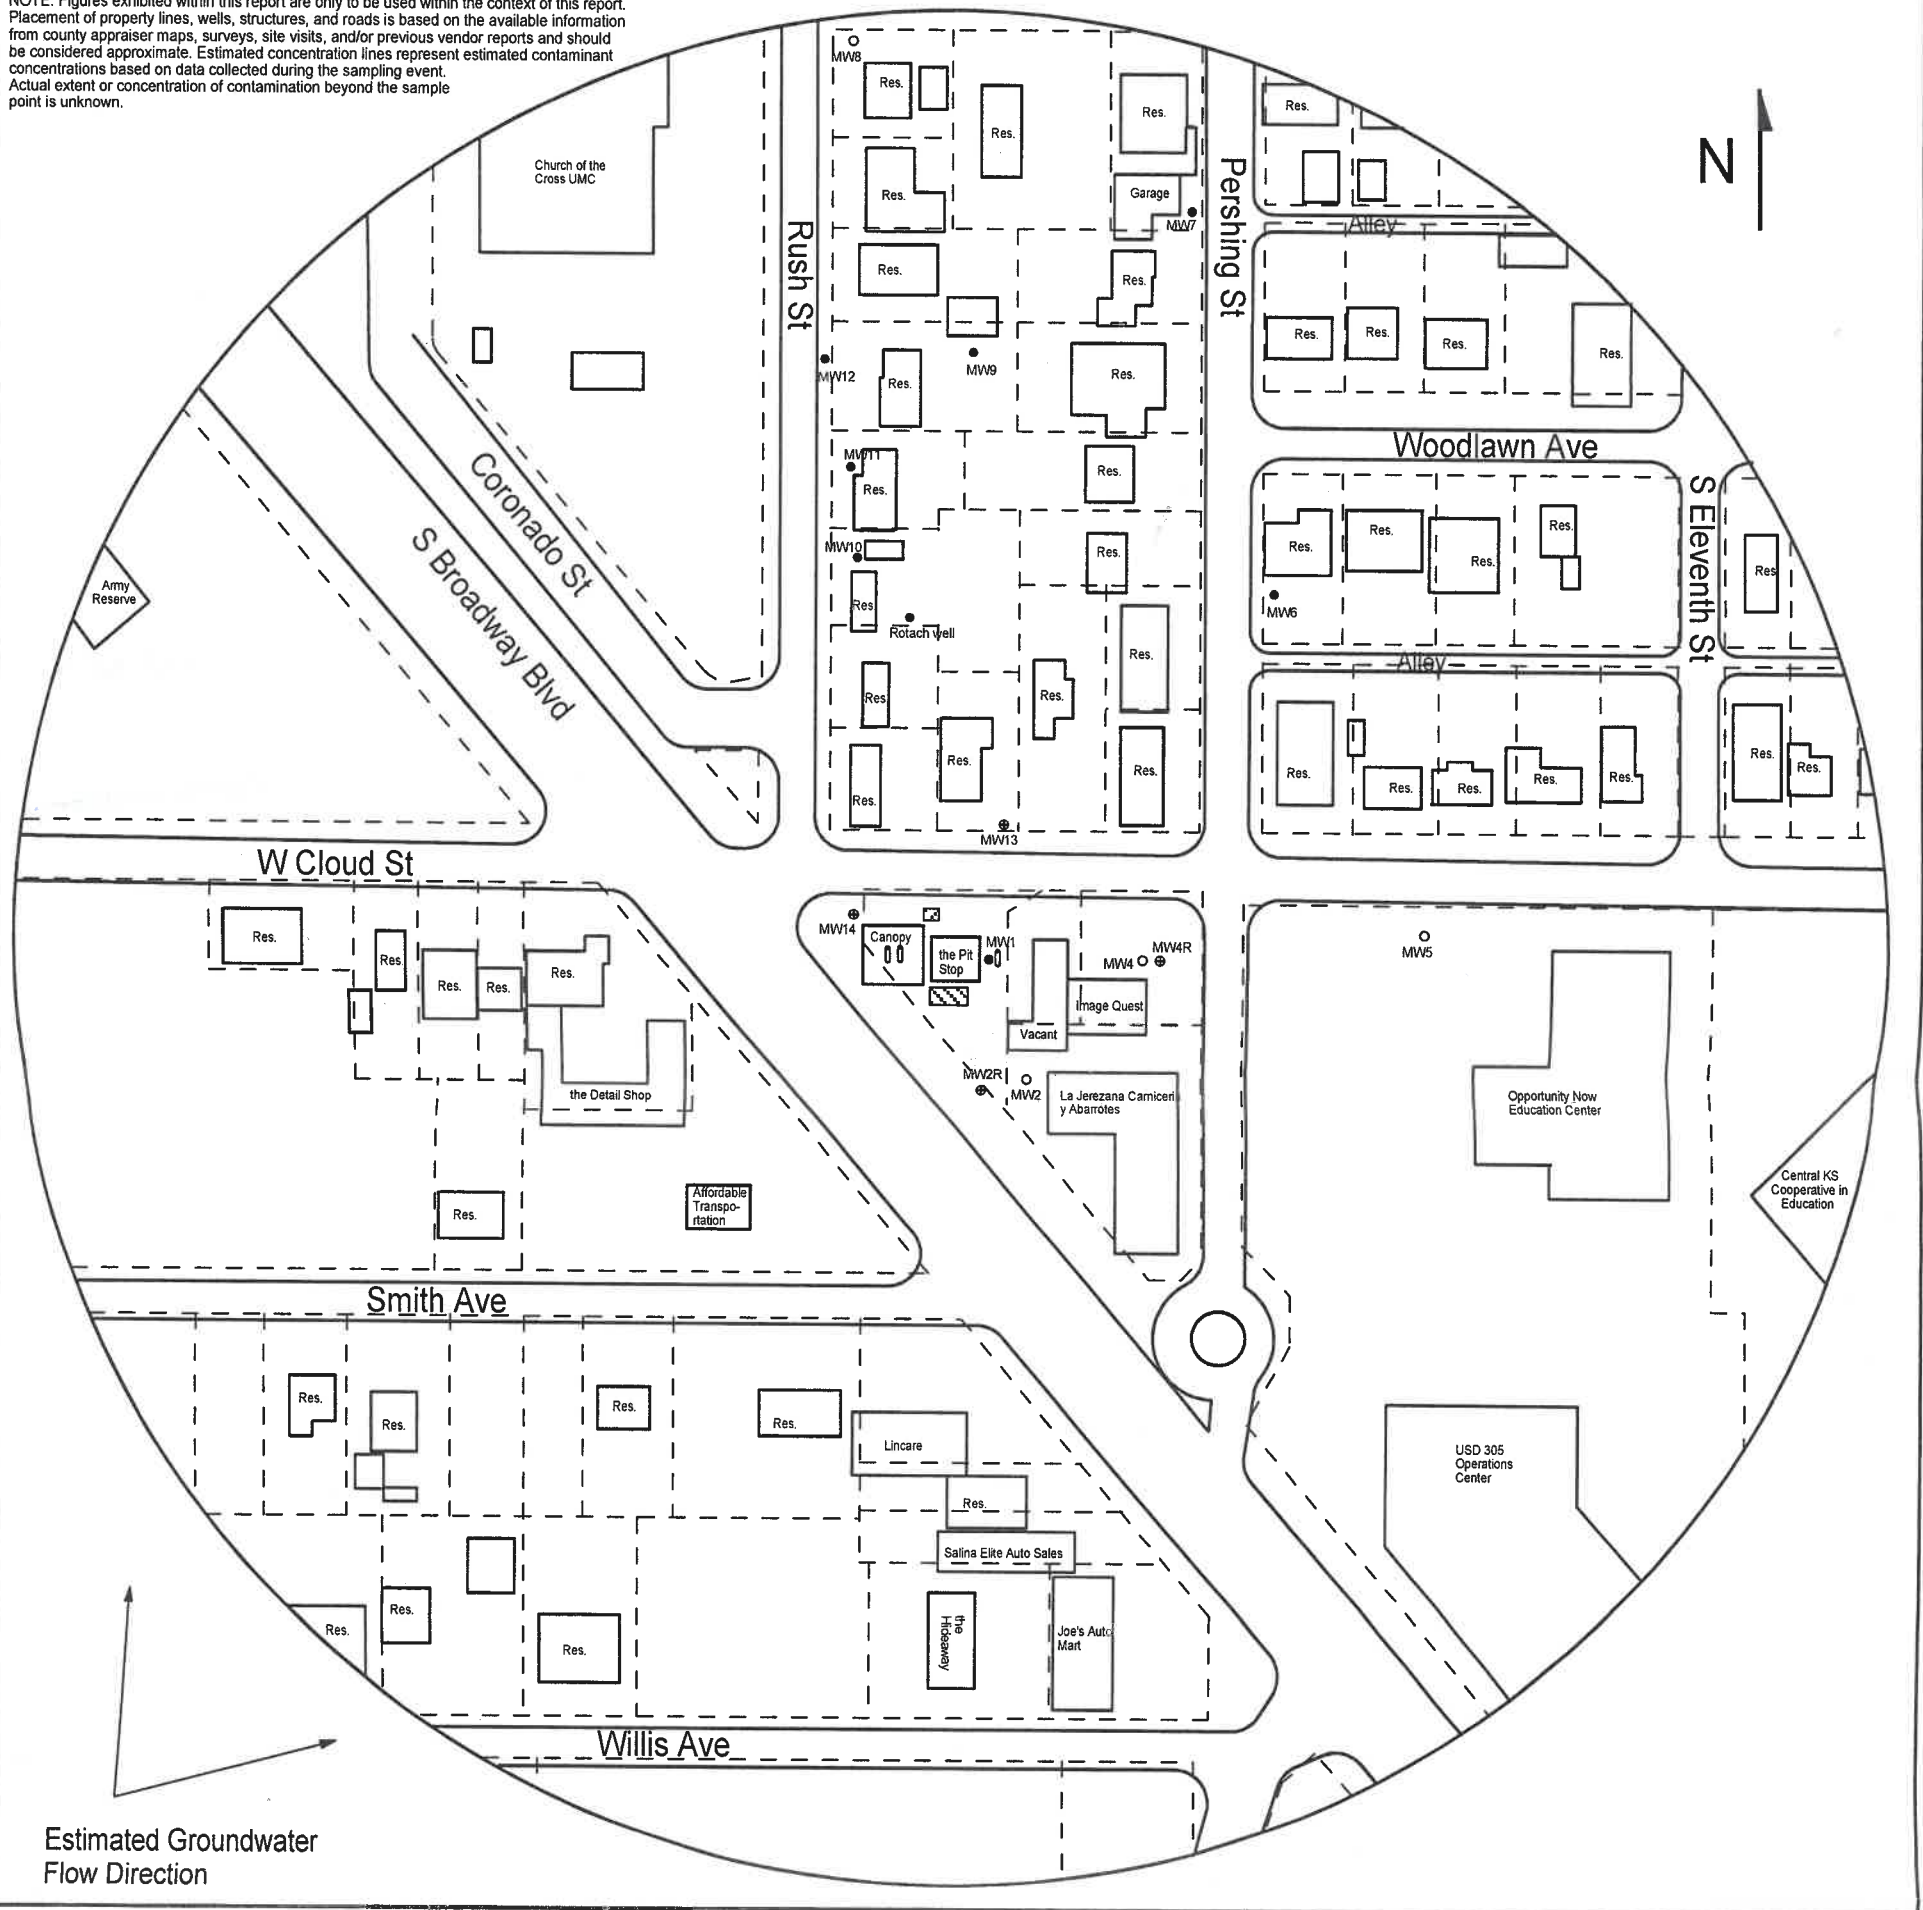


FIGURE 1 - 700 FT RADIUS AREA BASE MAP

- LEGEND**
- Approximate Location of Former UST Basin, & Pump Islands
 - Approximate Location of Active UST Basin, & Pump Islands
 - Building with Basement
 - Approximate Location of Property Line
 - Existing Monitoring Well
 - Plugged Monitoring Well
 - Newly installed Monitoring Well



PROJECT:
 K&B Pit Stop
 647 West Cloud St.
 Salina, KS
 KDHE ID: U5-085-00367
 Date: 9/20-21/22



1311 E 25th St., Suite B 785-841-8707 office
 Lawrence, KS 66046 785-865-4282 fax

NOTE: Location of product lines is unknown

26-14-3W