

WATER WELL RECORD

Form WWC-5

Division of Water Resources App. No.


Well ID

MW14

Original Record [] Correction [X] Change in Well Ust []

1 LOCATION OF WATER WELL: County Saline, Fraction NE 1/4 NE 1/4 NW 1/4 NE 1/4, Section Number 26, Township Number T 14 S, Range Number R 3 E X W

2 WELL OWNER: Last Name: Business: KDHE (K & B Pit Stop), Address: 1000 SW Jackson, City: Topeka, State: KS, ZIP: 66612, Street or Rural Address where well is located: 647 W Cloud St, Salina, KS 67401

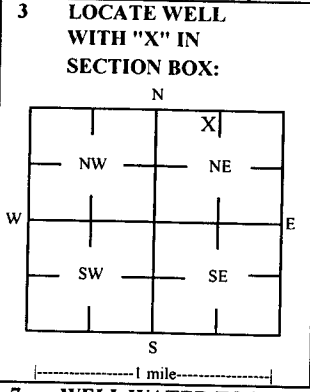

4 DEPTH OF COMPLETED WELL: 40 ft, Depth(s) Groundwater Encountered: 1) _____ ft, 2) _____ ft, 3) _____ ft, or 4) [] Dry Well, WELL'S STATIC WATER LEVEL: _____ ft.

5 Latitude: 38.81252 (decimal degrees), Longitude: 97.61843 (decimal degrees), Horizontal Datum [X] WGS 84 [] NAD 83 [] NAD 27, Source for Latitude/Longitude: [] GPS (unit make/model: _____) (WAAS enabled? [] Yes [] No) [X] Land Survey [] Topographic Map [] Online Mapper

6 Elevation 1235.24 ft [] Ground Level [X] TOC, Source [X] Land Survey [] GPS [] Topographic Map [] Other

7 WELL WATER TO BE USED AS: 1 Domestic: [] Household [] Lawn & Garden [] Livestock [] Irrigation [] Feedlot [] Industrial, 5 [] Public Water Supply: well ID, 6 [] Dewatering: how many wells?, 7 [] Aquifer Recharge: well ID, 8 [X] Monitoring: well ID MW14, 9 Environmental Remediation: well ID [] Air Sparge [] Soil Vapor Extractor [] Recovery [] Injection, 10 [] Oil Field Water Supply: lease, 11 Test Hole: well ID [] Cased [] Uncased [] Geotechnical, 12 Geothermal: How many bores? a) Closed Loop [] Horizontal [] Vertical b) Open Loop [] Surface Discharge [] Inj. of Water [] Other (specify): _____

Was a chemical/bacteriological sample submitted to KDHE? [] Yes [X] No, Water well disinfected? [] Yes [X] No, If yes, date sample was submitted: _____

8 TYPE OF CASING USED: [] Steel [X] PVC [] Other, Casing diameter 2 in. to 25 ft, Diameter _____ in. to _____ ft, Casing height above land surface -0.37 in., Weight _____ lbs./ft., Well thickness or gauge No _____, TYPE OF SCREEN OR PERFORATION MATERIAL: [] Steel [] Stainless Steel [] Fiberglass [X] PVC [] Brass [] Galvanized Steel [] Concrete tile [] None used (open hole) [] Other (Specify) _____, SCREEN OR PERFORATION OPENINGS ARE: [] Continuous Slot [X] Mill Slot [] Gauze Wrapped [] Torch Cut [] Drilled Holes [] Other (Specify) _____ [] Louvered Shutter [] Key Punched [] Wire Wrapped [] Saw Cut [] None (Open Hole), SCREEN-PERFORATED INTERVALS: From 25 ft. to 40 ft., From _____ ft. to _____ ft., From _____ ft. to _____ ft., GRAVEL PACK INTERVALS: From 22 ft. to 40 ft., From _____ ft. to _____ ft., From _____ ft. to _____ ft., From _____ ft. to _____ ft.

9 GROUT MATERIAL: [] Neat cement [] Cement grout [X] Bentonite [X] Other Concrete: 0-0.5', Grout intervals: From 0.5 ft. to 22 ft., From _____ ft. to _____ ft., From _____ ft. to _____ ft.

Nearest source of possible contamination: [] Septic Tank [] Lateral Lines [] Pit Privy [] Livestock Pens [] Insecticide Storage [] Sewer Lines [] Cess Pool [] Sewage Lagoon [X] Fuel Storage [] Abandoned Water Well [] Watertight Sewer Lines [] Seepage Pit [] Feedyard [] Fertilizer Storage [] Oil Well / Gas Well [] Other (Specify) _____, Direction from well? SE, Distance from well? ~35 ft

10 FROM TO LITHOLOGIC LOG FROM TO LITHO. LOG (cont.) or PLUGGING INTERVALS

0	2	Topsoil, clayey silt			
2	10	Clayey silt			
10	28	Silt			
28	40	Fine sand			

Notes: KDHE ID: K&B Pit Stop ; U5-085-00367
Target of monitoring well is shallow groundwater, <20' of grout was installed at the direction of KDHE.

11 CONTRACTOR'S OR LANDOWNER'S CERTIFICATION: This water well was [X] constructed, [] reconstructed, or [] plugged under my jurisdiction and was completed on (mo-day-year) 9/21/22 and this record is true to the best of my knowledge and belief. Kansas Water Well Contractor's License No 757 This Water Well Record was completed on (mo-day-year) 10/17/22 under the business name of Larsen & Associates, Inc. Signature _____

Salina

NOTE: Figures exhibited within this report are only to be used within the context of this report. Placement of property lines, wells, structures, and roads is based on the available information from county appraiser maps, surveys, site visits, and/or previous vendor reports and should be considered approximate. Estimated concentration lines represent estimated contaminant concentrations based on data collected during the sampling event. Actual extent or concentration of contamination beyond the sample point is unknown.

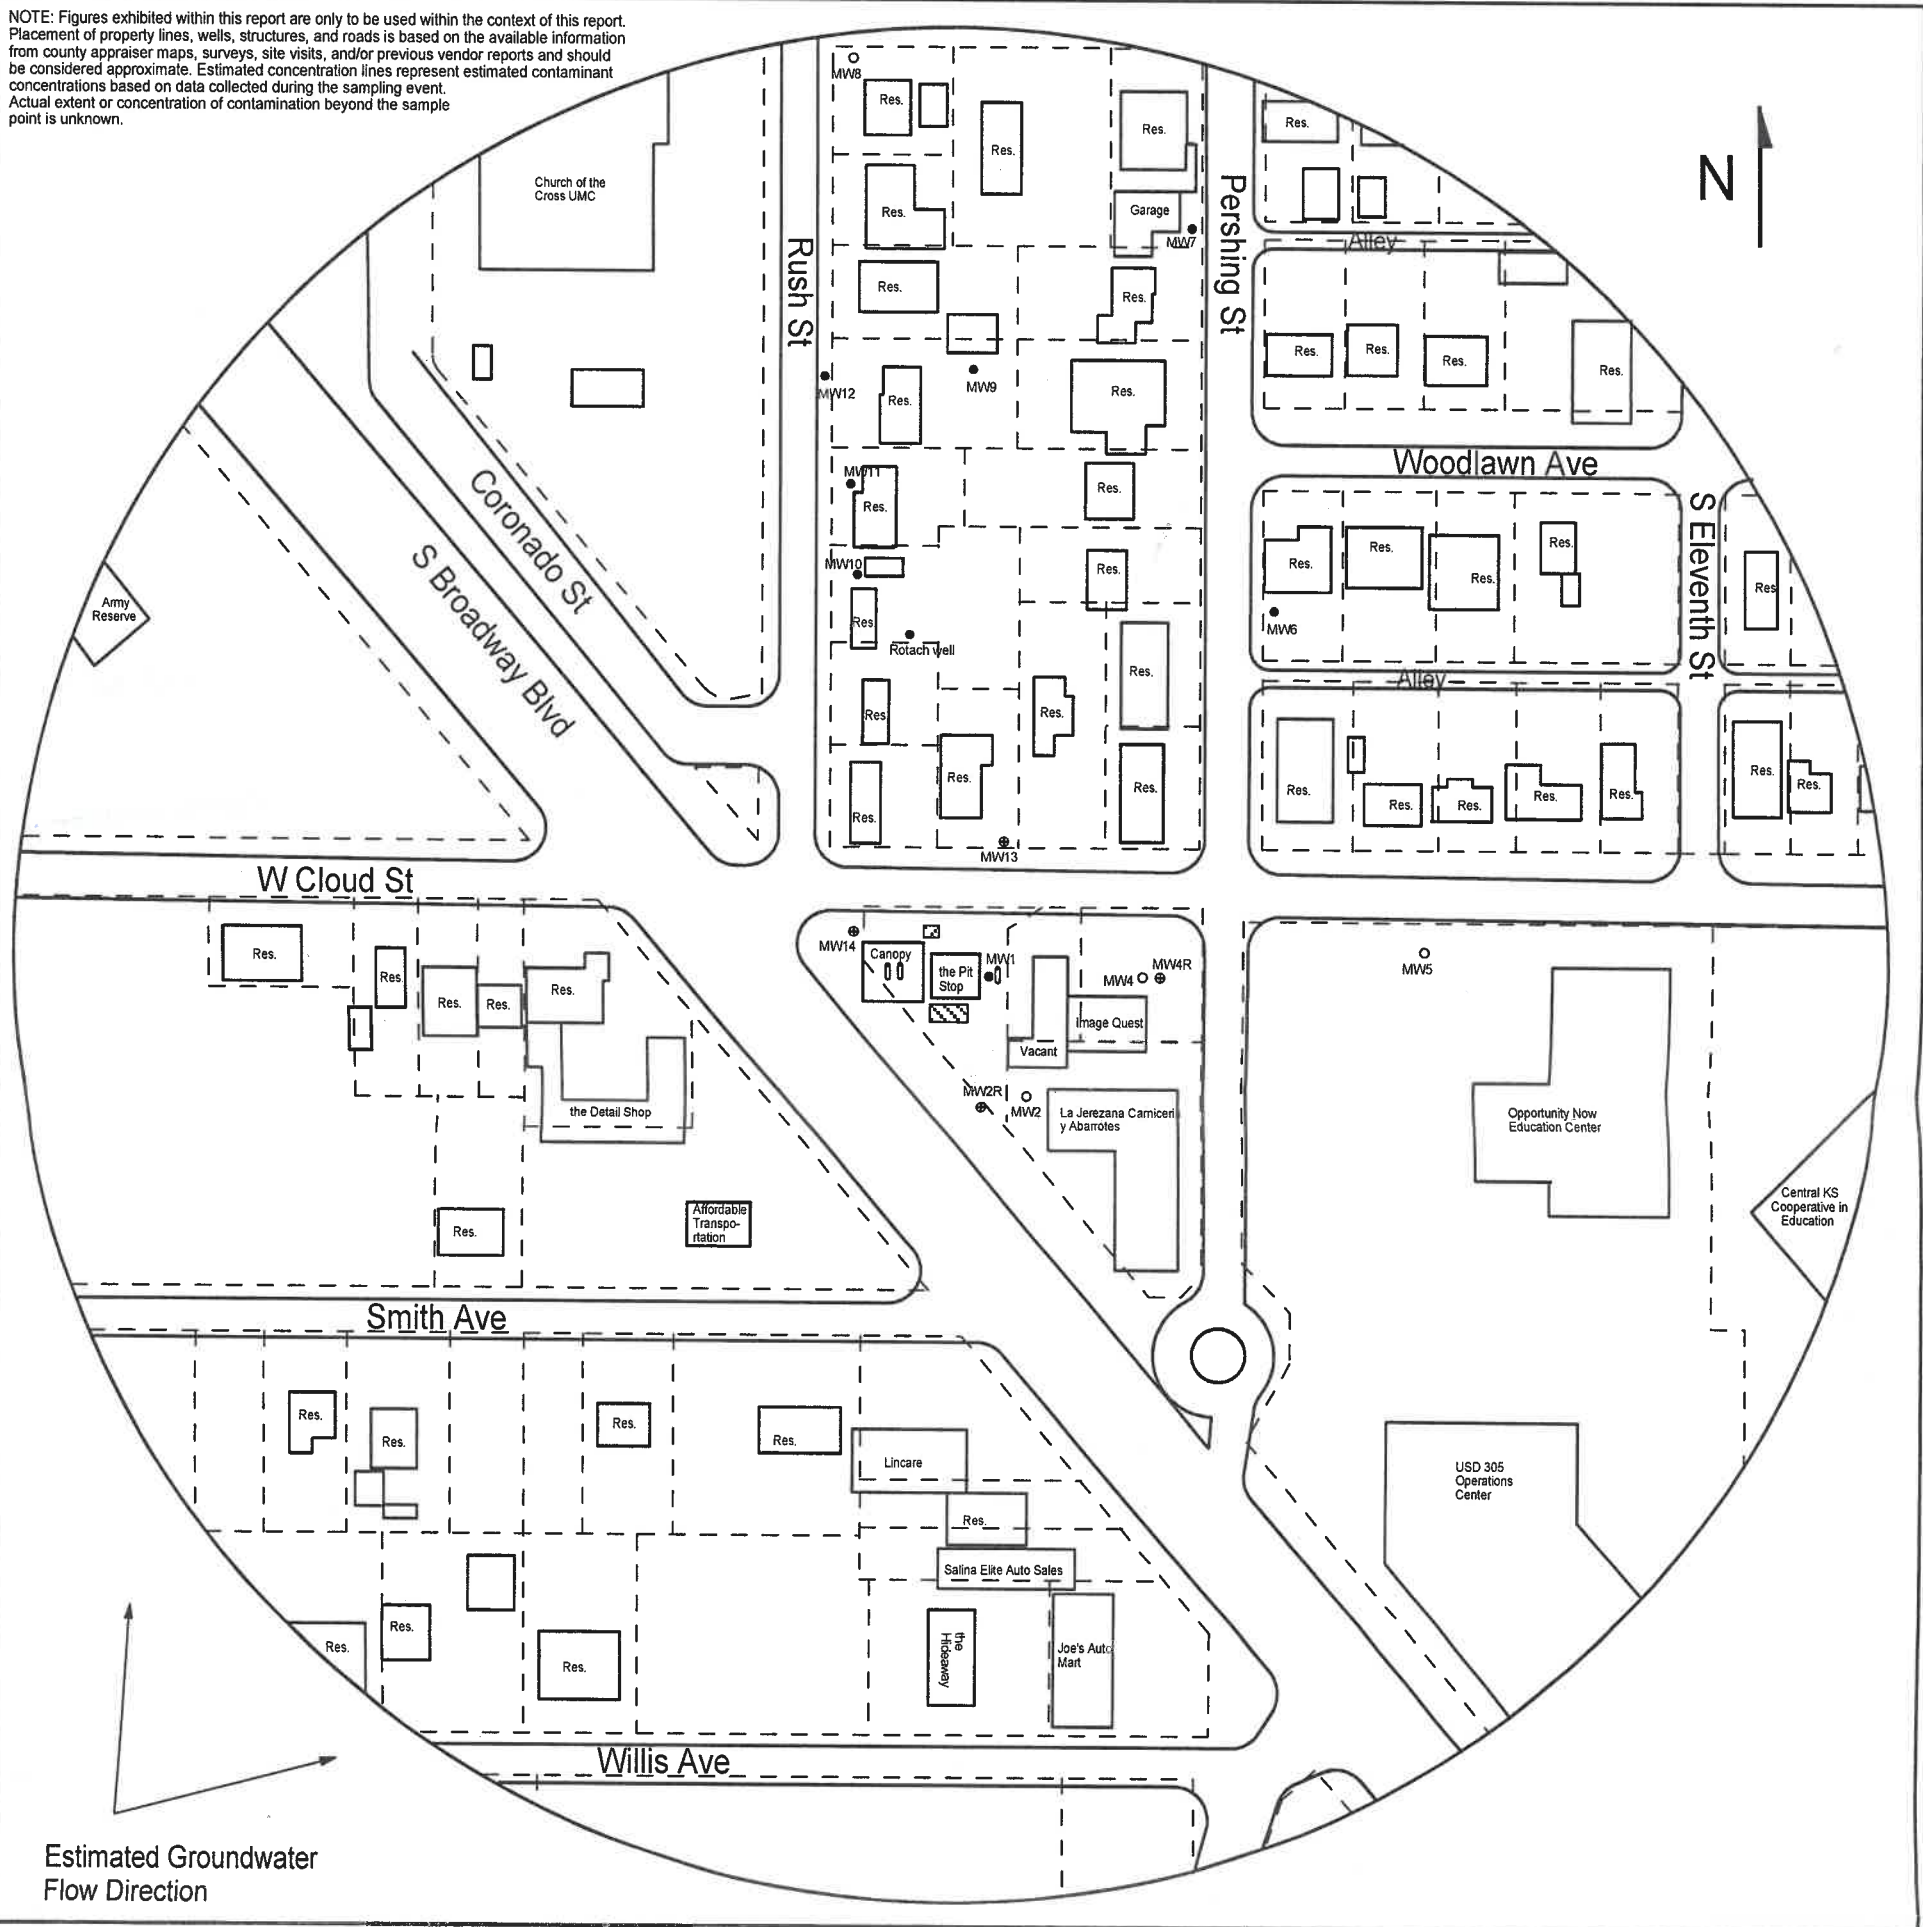


FIGURE 1 - 700 FT RADIUS AREA BASE MAP

- LEGEND**
- Approximate Location of Former UST Basin, & Pump Islands
 - Approximate Location of Active UST Basin, & Pump Islands
 - Building with Basement
 - Approximate Location of Property Line
 - Existing Monitoring Well
 - Plugged Monitoring Well
 - Newly installed Monitoring Well



PROJECT:
 K&B Pit Stop
 647 West Cloud St.
 Salina, KS
 KDHE ID: U5-085-00367
 Date: 9/20-21/22

1311 E 25th St., Suite B 785-841-8707 office
 Lawrence, KS 66046 785-865-4282 fax

0 200 ft

NOTE: Location of product lines is unknown

26-14-3W