

WATER WELL RECORD

Form WWC-5

Division of Water Resources App. No.

<p>1 LOCATION OF WATER WELL: County: <u>Scott</u></p>	<p>Fraction <u>SE 1/4 SE 1/4 SE 1/4 1/4</u></p>	<p>Section Number <u>12</u></p>	<p>Township No. <u>T 16 S</u></p>	<p>Range Number <u>R 33</u> <input type="checkbox"/> E <input checked="" type="checkbox"/> W</p>
<p>Street/Rural Address of Well Location; if unknown, distance & direction from nearest town or intersection: If at owner's address, check here <input checked="" type="checkbox"/> <u>14010 Hwy 95 Scott City, KS 67871</u></p>		<p>Global Positioning System (GPS) information: Latitude: <u>38.6713200</u> (in decimal degrees) Longitude: <u>-100.9097067</u> (in decimal degrees) Elevation: <u>2863</u> Datum: <input type="checkbox"/> WGS 84, <input checked="" type="checkbox"/> NAD 83, <input type="checkbox"/> NAD 27 Collection Method: <input checked="" type="checkbox"/> GPS unit (Make/Model: <u>E333886 N 4282034</u>) <input type="checkbox"/> Digital Map/Photo, <input type="checkbox"/> Topographic Map, <input type="checkbox"/> Land Survey Est. Accuracy: <input checked="" type="checkbox"/> <3 m, <input type="checkbox"/> 3-5 m, <input type="checkbox"/> 5-15 m, <input type="checkbox"/> >15 m</p>		
<p>2 WATER WELL OWNER: <u>Chris Price</u> RR#, Street Address, Box #: <u>14010 Hwy 95</u> City, State, ZIP Code : <u>Scott City, KS 67871</u></p>				

<p>3 LOCATE WELL WITH AN "X" IN SECTION BOX: N W E S -----1 mile----- </p>	<p>4 DEPTH OF COMPLETED WELL <u>5@240</u> ft. Depth(s) Groundwater Encountered (1)..... ft. (2)..... ft. (3)..... ft. WELL'S STATIC WATER LEVEL <u>N/A</u> ft. below land surface measured on mo/day/yr. <u>N/A</u> Pump test data: Well water was <u>N/A</u> ft. after <u>N/A</u> hours pumping <u>N/A</u> gpm EST. YIELD <u>N/A</u> gpm. Well water was <u>N/A</u> ft. after <u>N/A</u> hours pumping <u>N/A</u> gpm Bore Hole Diameter <u>4.75</u> in. to <u>240</u> ft., and in. to ft. WELL WATER TO BE USED AS: <input type="checkbox"/> Public water supply <input checked="" type="checkbox"/> Geothermal <input type="checkbox"/> Injection well <input type="checkbox"/> Domestic <input type="checkbox"/> Feedlot <input type="checkbox"/> Oil field water supply <input type="checkbox"/> Dewatering <input type="checkbox"/> Other (Specify below) <input type="checkbox"/> Irrigation <input type="checkbox"/> Industrial <input type="checkbox"/> Domestic-lawn & garden <input type="checkbox"/> Monitoring well Was a chemical/bacteriological sample submitted to Department? <input type="checkbox"/> Yes <input checked="" type="checkbox"/> No If yes, mo/day/yr sample was submitted..... Water well disinfected? <input type="checkbox"/> Yes <input checked="" type="checkbox"/> No</p>
--	--

5 TYPE OF CASING USED: Steel PVC Other HDPE 3408 Pipe
CASING JOINTS: Glued Clamped Welded Threaded N/A
Casing diameter .75 in. to 240 ft., Diameter in. to ft., Diameter in. to ft.
Casing height above land surface N/A in., Weight N/A lbs./ft., Wall thickness or gauge No. N/A
TYPE OF SCREEN OR PERFORATION MATERIAL:
 Steel Stainless Steel PVC Other (Specify) N/A
 Brass Galvanized Steel None used (open hole)
SCREEN OR PERFORATION OPENINGS ARE:
 Continuous slot Mill slot Gauze wrapped Torch cut Drilled holes None (open hole)
 Louvered shutter Key punched Wire wrapped Saw cut Other (specify) N/A
SCREEN-PERFORATED INTERVALS: From N/A ft. to N/A ft., From N/A ft. to N/A ft., From N/A ft. to N/A ft.
GRAVEL PACK INTERVALS: From N/A ft. to N/A ft., From N/A ft. to N/A ft., From N/A ft. to N/A ft.

6 GROUT MATERIAL: Neat cement Cement grout Bentonite Other 30% Solids
Grout Intervals: From 0 ft. to 240 ft., From ft. to ft., From ft. to ft.
What is the nearest source of possible contamination:
 Septic tank Lateral lines Pit privy Livestock pens Insecticide storage Other (specify below)
 Sewer lines Cesspool Sewage lagoon Fuel storage Abandoned water well
 Watertight sewer lines Seepage pit Feedyard Fertilizer storage Oil well/gas well N/A
Direction from well N/A Distance from well N/A

FROM	TO	LITHOLOGIC LOG	FROM	TO	LITHO. LOG (cont.) or PLUGGING INTERVALS
0	1	Grey overlay			silty blue shale
1	30	Brown medium sand	75	245	Blue/grey shale.
30	38	Brownish/white clay & fine to medium brown sand			
38	42	Fine to medium coarse quartz sand			
42	52	Tan clay w/some medium sand stringers			
52	55	Brown clay till & layers of brown sand			
55	75	Blue soft shale w/ some layers of			

**Original Returned to Sender
for Correction Date: 1/20/11**

7 CONTRACTOR'S OR LANDOWNER'S CERTIFICATION: This water well was constructed, reconstructed, or plugged under my jurisdiction and was completed on (mo/day/year) 12/30/2010 and this record is true to the best of my knowledge and belief. Kansas Water Well Contractor's License No. 748-734 This Water Well Record was completed on (mo/day/year) 1/3/2011 under the business name of Can America Drilling Inc. by (signature) Wayne A. Auld

INSTRUCTIONS: Use typewriter or ball point pen. PLEASE PRESS FIRMLY and PRINT clearly. Please fill in blanks and check the correct answers. Send three copies (white, blue, pink) to Kansas Department of Health and Environment, Bureau of Water, Geology Section, 1000 SW Jackson St., Suite 420, Topeka, Kansas 66612-1367. Telephone 785-296-5522. Send one copy to WATER WELL OWNER and retain one for your records. Include fee of \$5.00 for each constructed well. Visit us at <http://www.kdheks.gov/waterwell/index.html>.

GEOHERMAL SITE LAYOUT & LOG

Name: Chris Price
Mailing Address: 14010 Hwy 95
City, State & Zip: Scott City, KS 67871

Project Location: 14010 Hwy 95 Scott City, KS 67871


DRILLING LOG

0	1	Grey overlay
1	30	Brown medium sand
30	38	Brownish/white clay & fine to medium brown sand
38	42	Fine to medium coarse quartz sand
42	52	Tan clay w/ some medium sand stringers
52	55	Brown clay till & layers of brown sand
55	75	Blue soft shale w/ some layers of silty blue shale
75	245	Blue/grey shale

MAP

Hole to Landmark
Measurements

A.1	36'6"
A.2.	52'
A.3.	67'
A.4.	82'
A.5.	95'
B.1.	54'
B.2.	61'4"
B.3.	71'4"
B.4.	84'4"
B.5.	96'

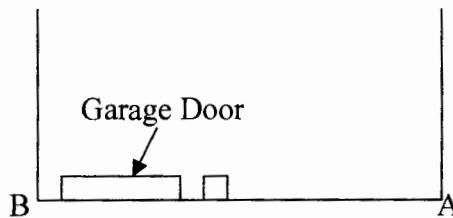

GPS

- 1) 333866
4282034
- 2) 333866
4282031
- 3) 333870
4282028
- 4) 333874
4282025
- 5) 333875
4282020

- 1
- 2
- 3
- 4
- 5