

WATER WELL RECORD Form WWC-5

Original Record Correction Change in Well Use

Division of Water Resources App. No.

Well ID

1 LOCATION OF WATER WELL: County:		Fraction ¼ ¼ ¼ ¼	Section Number	Township Number T S	Range Number R E W
---	--	---------------------	----------------	------------------------	-----------------------

2 WELL OWNER: Last Name:	First:	Street or Rural Address where well is located (if unknown, distance and direction from nearest town or intersection): If at owner's address, check here: <input type="checkbox"/>	
Business:			
Address:			
Address:			
City:	State:	ZIP:	

3 LOCATE WELL WITH "X" IN SECTION BOX:
N

NW	NE
SW	SE

W X E

S

-----1 mile-----

4 DEPTH OF COMPLETED WELL: ft.

Depth(s) Groundwater Encountered: 1) ft.
2) ft. 3) ft., or 4) Dry Well

WELL'S STATIC WATER LEVEL: ft.

below land surface, measured on (mo-day-yr).....
 above land surface, measured on (mo-day-yr).....

Pump test data: Well water was ft.
after..... hours pumping gpm
Well water was ft.
after..... hours pumping gpm

Estimated Yield:gpm
Bore Hole Diameter: in. to ft. and
..... in. to ft.

5 Latitude:(decimal degrees)
Longitude:(decimal degrees)
Datum: WGS 84 NAD 83 NAD 27
Source for Latitude/Longitude:
 GPS (unit make/model:)
(WAAS enabled? Yes No)
 Land Survey Topographic Map
 Online Mapper:

6 Elevation:ft. Ground Level TOC
Source: Land Survey GPS Topographic Map
 Other

7 WELL WATER TO BE USED AS:

1. Domestic: <input type="checkbox"/> Household <input type="checkbox"/> Lawn & Garden <input type="checkbox"/> Livestock	2. <input type="checkbox"/> Irrigation 3. <input type="checkbox"/> Feedlot 4. <input type="checkbox"/> Industrial	5. <input type="checkbox"/> Public Water Supply: well ID	6. <input type="checkbox"/> Dewatering: how many wells?	7. <input type="checkbox"/> Aquifer Recharge: well ID	8. <input type="checkbox"/> Monitoring: well ID	9. Environmental Remediation: well ID	10. <input type="checkbox"/> Oil Field Water Supply: lease	11. Test Hole: well ID	12. Geothermal: how many bores?	13. <input type="checkbox"/> Other (specify):
--	---	--	---	---	---	---	--	------------------------------	---------------------------------------	---

Was a chemical/bacteriological sample submitted to KDHE? Yes No If yes, date sample was submitted:

Water well disinfected? Yes No

8 TYPE OF CASING USED: Steel PVC Other CASING JOINTS: Glued Clamped Welded Threaded
Casing diameter in. to ft., Diameter in. to ft., Diameter in. to ft.
Casing height above land surface in. Weight lbs./ft. Wall thickness or gauge No.

TYPE OF SCREEN OR PERFORATION MATERIAL:
 Steel Stainless Steel PVC Other (Specify)
 Brass Galvanized Steel None used (open hole)

SCREEN OR PERFORATION OPENINGS ARE:
 Continuous Slot Mill Slot Gauze Wrapped Torch Cut Drilled Holes Other (Specify)
 Louvered Shutter Key Punched Wire Wrapped Saw Cut None (Open Hole)

SCREEN-PERFORATED INTERVALS: From ft. to ft., From ft. to ft., From ft. to ft.
GRAVEL PACK INTERVALS: From ft. to ft., From ft. to ft., From ft. to ft.

9 GROUT MATERIAL: Neat cement Cement grout Bentonite Other

Grout Intervals: From ft. to ft., From ft. to ft., From ft. to ft.



Nearest source of possible contamination: No potential source of contamination within 200 ft.
 Septic Tank Lateral Lines Pit Privy Livestock Pens Insecticide Storage
 Sewer Lines Cess Pool Sewage Lagoon Fuel Storage Abandoned Water Well
 Watertight Sewer Lines Seepage Pit Feedyard Fertilizer Storage Oil Well/Gas Well
 Other (Specify)

Direction from well? Distance from well? ft.

10 FROM	TO	LITHOLOGIC LOG	FROM	TO	LITHO. LOG (cont.) or PLUGGING INTERVALS
Notes:					

11 CONTRACTOR'S OR LANDOWNER'S CERTIFICATION: This water well was constructed, reconstructed, or plugged under my jurisdiction and was completed on (mo-day-year) and this record is true to the best of my knowledge and belief. Kansas Water Well Contractor's License No. This Water Well Record was completed on (mo-day-year) under the business name of

W. 7th Avenue (Highway 54)

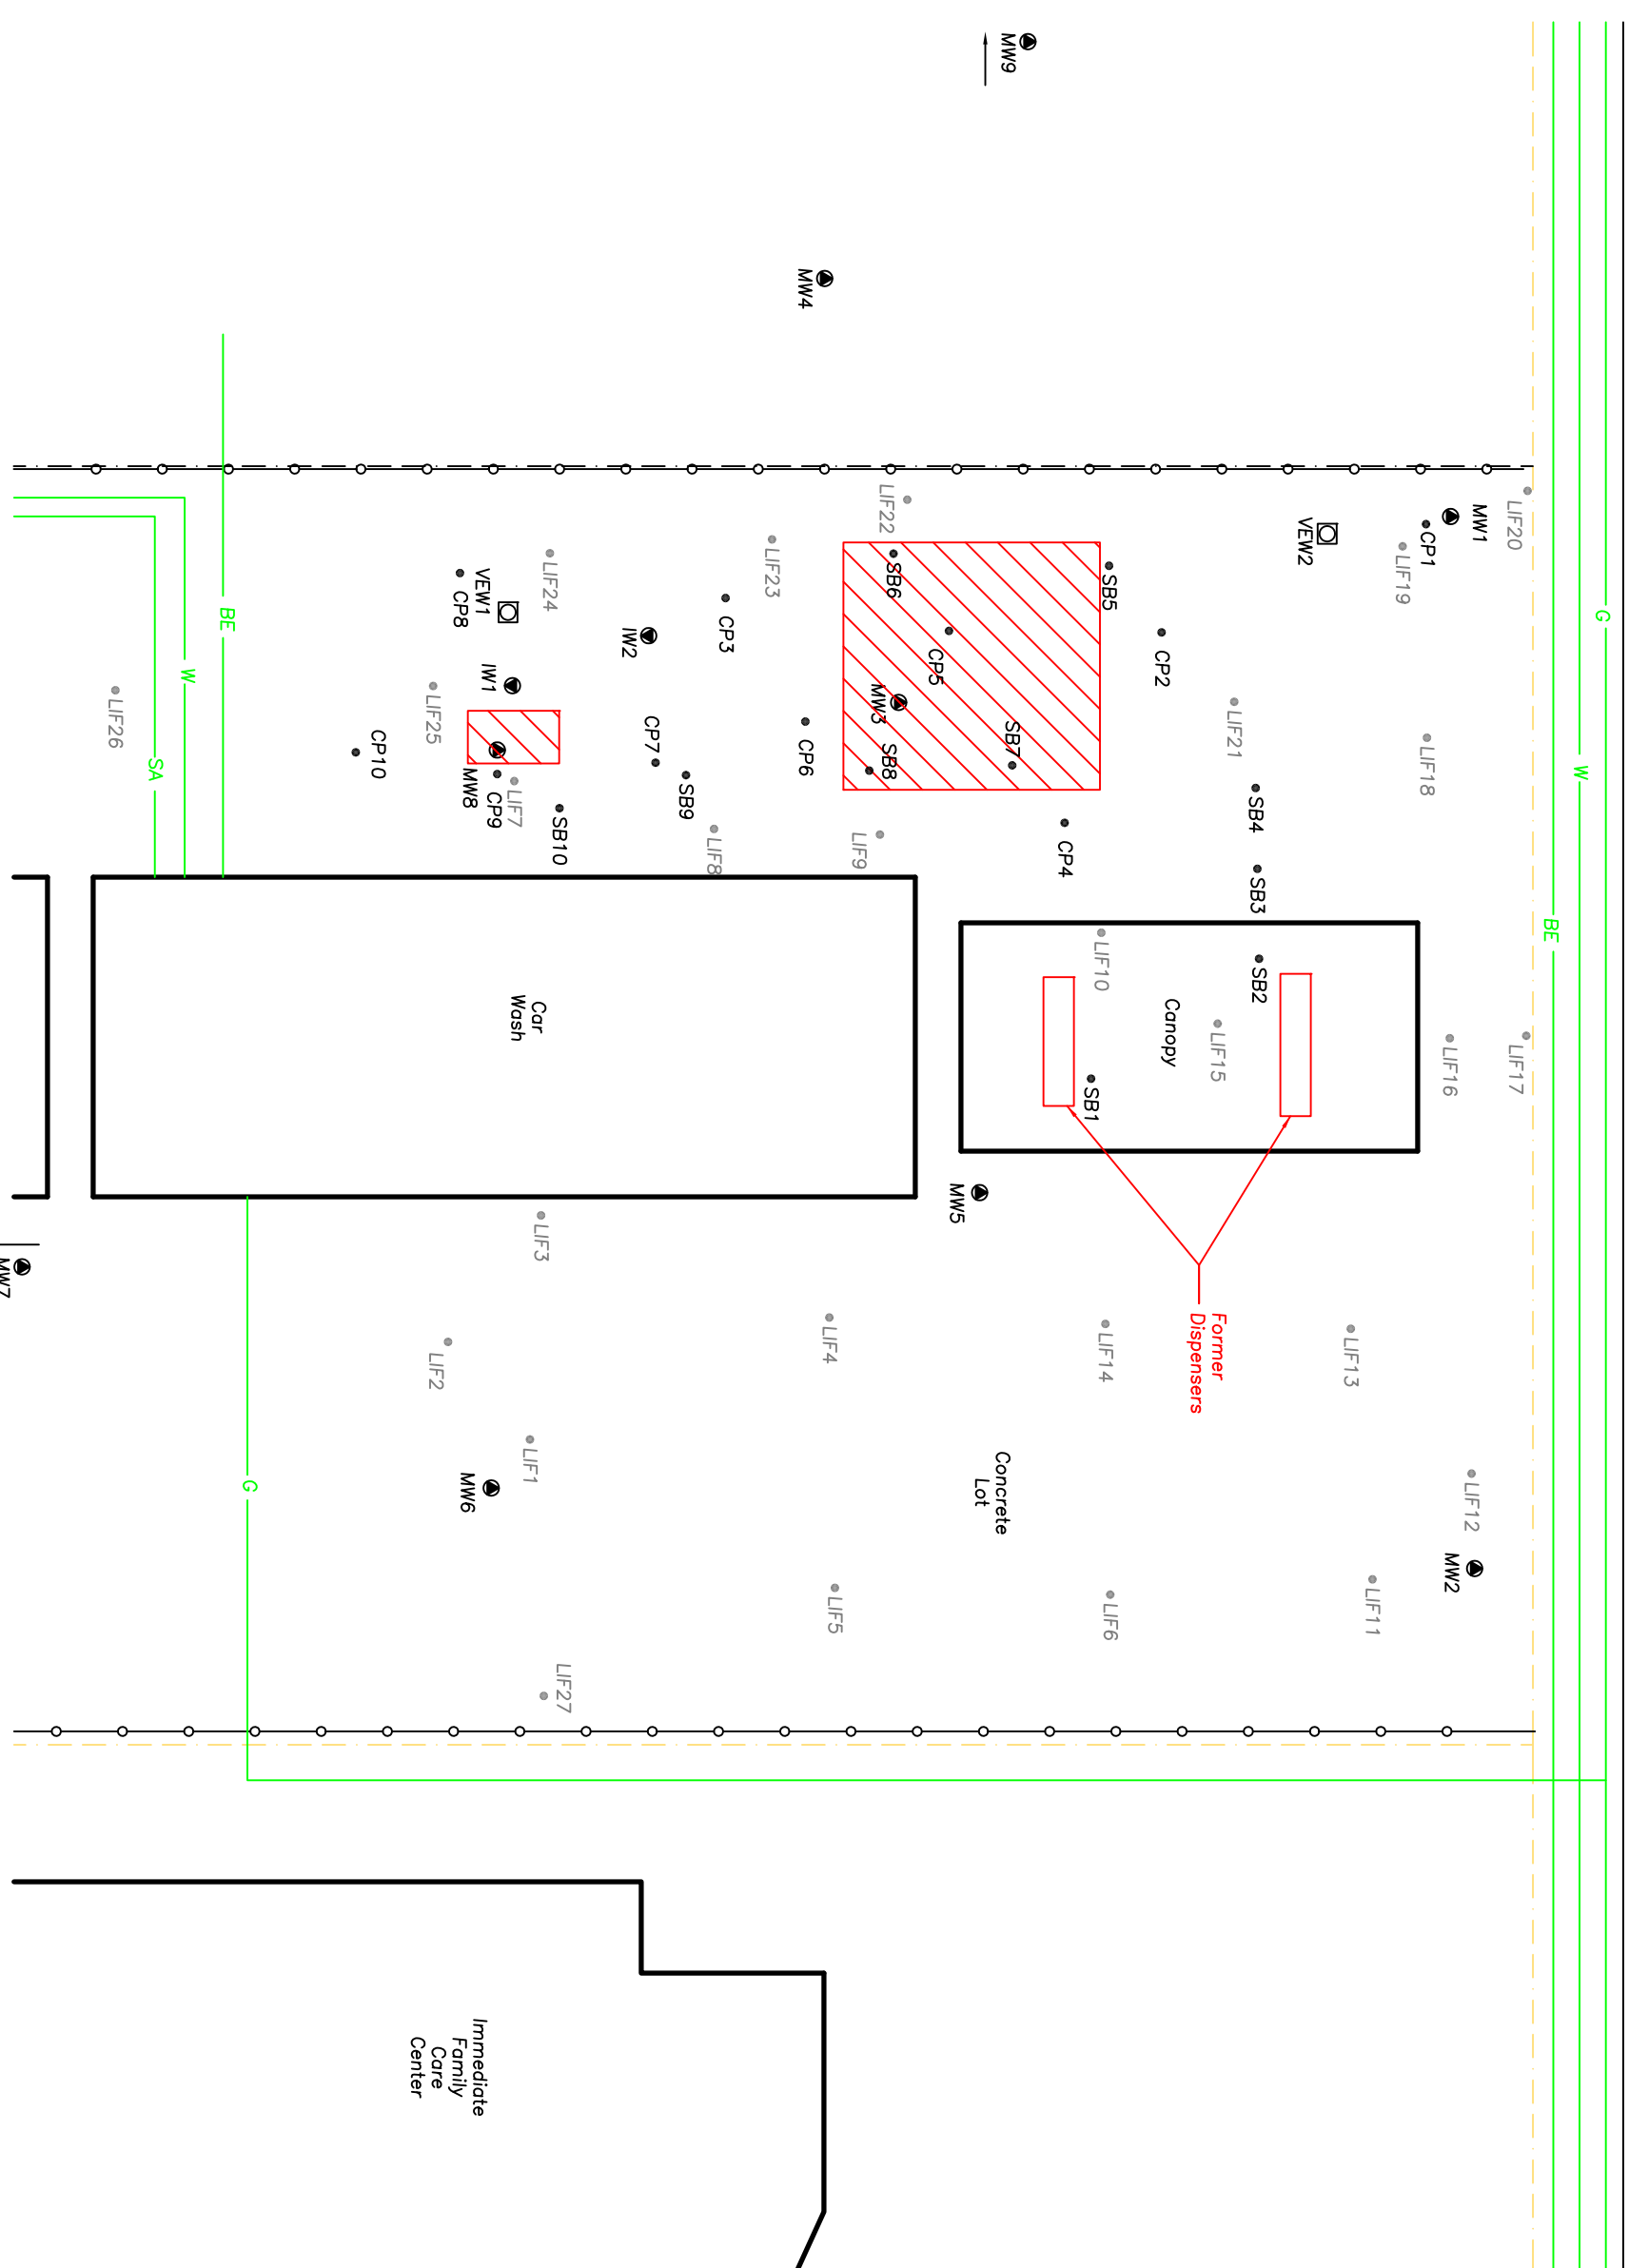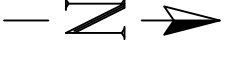

Legend

- MW1 – Monitoring Well Location
- “PMW” Wells Associated with Pemco #244
- ☐ VEW1 – Multi-Phase Extraction Well
- CP1 – Air Sparge Well
- CP1 – Continuous Probe Location (CGP 2019)
- LIF1 – Laser Induced Fluorescence Probe (SCS 2017)
- SB1 – Soil Probe Location (SCS 2017)
- ▨ – Former UST
- — — Property Line
- Clark – Property Owner Name
- OH — Overhead Power Line
- SA — Sanitary Sewer Line (~4’ deep)
- FO — Fiber Optic (~3’ Deep)
- W — Water Line (~4’ deep)
- G — Gas Line (~3’ deep)
- BT — Buried Telephone (~2’ deep)
- ST — Storm Sewer (Culvert) (~1’ deep)
- PP ● — Power Pole
- LP ● — Light Pole
- MH ● — Manhole
- Ped ● — Phone Pedestal
- WM ● — Water Meter
- FH ● — Fire Hydrant
- CO ● — Clean Out
- — Tree



Site Detail Map
Moore Washes
Augusta, Kansas
KDHE Project Code: U2-008-13132
Remedial Design Report
CGP Project #18852K
Prepared By: MK Date: 04-06-2021
Reviewed By: MK Date: 04-06-2021
Figure 1.4
CGP, Inc. P0 Box 23, Wahoo, NE 68066