

WATER WELL RECORD Form WWC-5

Original Record Correction Change in Well Use

Division of Water Resources App. No.

Well ID

Well ID

1 LOCATION OF WATER WELL: County, Fraction, Section Number, Township Number, Range Number

2 WELL OWNER: Last Name, Business, Address, City, State, ZIP, Street or Rural Address

3 LOCATE WELL WITH 'X' IN SECTION BOX: NW, NE, SW, SE, S, 1 mile scale

4 DEPTH OF COMPLETED WELL: Depth(s) Groundwater Encountered, WELL'S STATIC WATER LEVEL, Pump test data, Estimated Yield, Bore Hole Diameter

5 Latitude, Longitude, Datum, Source for Latitude/Longitude, GPS, Land Survey, Topographic Map, Online Mapper

6 Elevation: Ground Level, TOC, Source: Land Survey, GPS, Topographic Map, Other

7 WELL WATER TO BE USED AS: Domestic, Irrigation, Industrial, Public Water Supply, Dewatering, Aquifer Recharge, Monitoring, Environmental Remediation, Oil Field Water Supply, Test Hole, Geothermal, Other



Was a chemical/bacteriological sample submitted to KDHE? Water well disinfected?

8 TYPE OF CASING USED: Steel, PVC, Other, CASING JOINTS, Casing diameter, Casing height, TYPE OF SCREEN OR PERFORATION MATERIAL, SCREEN OR PERFORATION OPENINGS ARE, SCREEN-PERFORATED INTERVALS, GRAVEL PACK INTERVALS

9 GROUT MATERIAL: Neat cement, Cement grout, Bentonite, Other, Grout Intervals, Nearest source of possible contamination: Septic Tank, Sewer Lines, Watertight Sewer Lines, Lateral Lines, Cess Pool, Seepage Pit, Pit Privy, Sewage Lagoon, Feedyard, Livestock Pens, Fuel Storage, Fertilizer Storage, Insecticide Storage, Abandoned Water Well, Oil Well/Gas Well

Table with columns: FROM, TO, LITHOLOGIC LOG, FROM, TO, LITHO. LOG (cont.) or PLUGGING INTERVALS. Includes a Notes section.

11 CONTRACTOR'S OR LANDOWNER'S CERTIFICATION: This water well was constructed, reconstructed, or plugged under my jurisdiction and was completed on (mo-day-year) and this record is true to the best of my knowledge and belief.

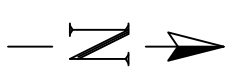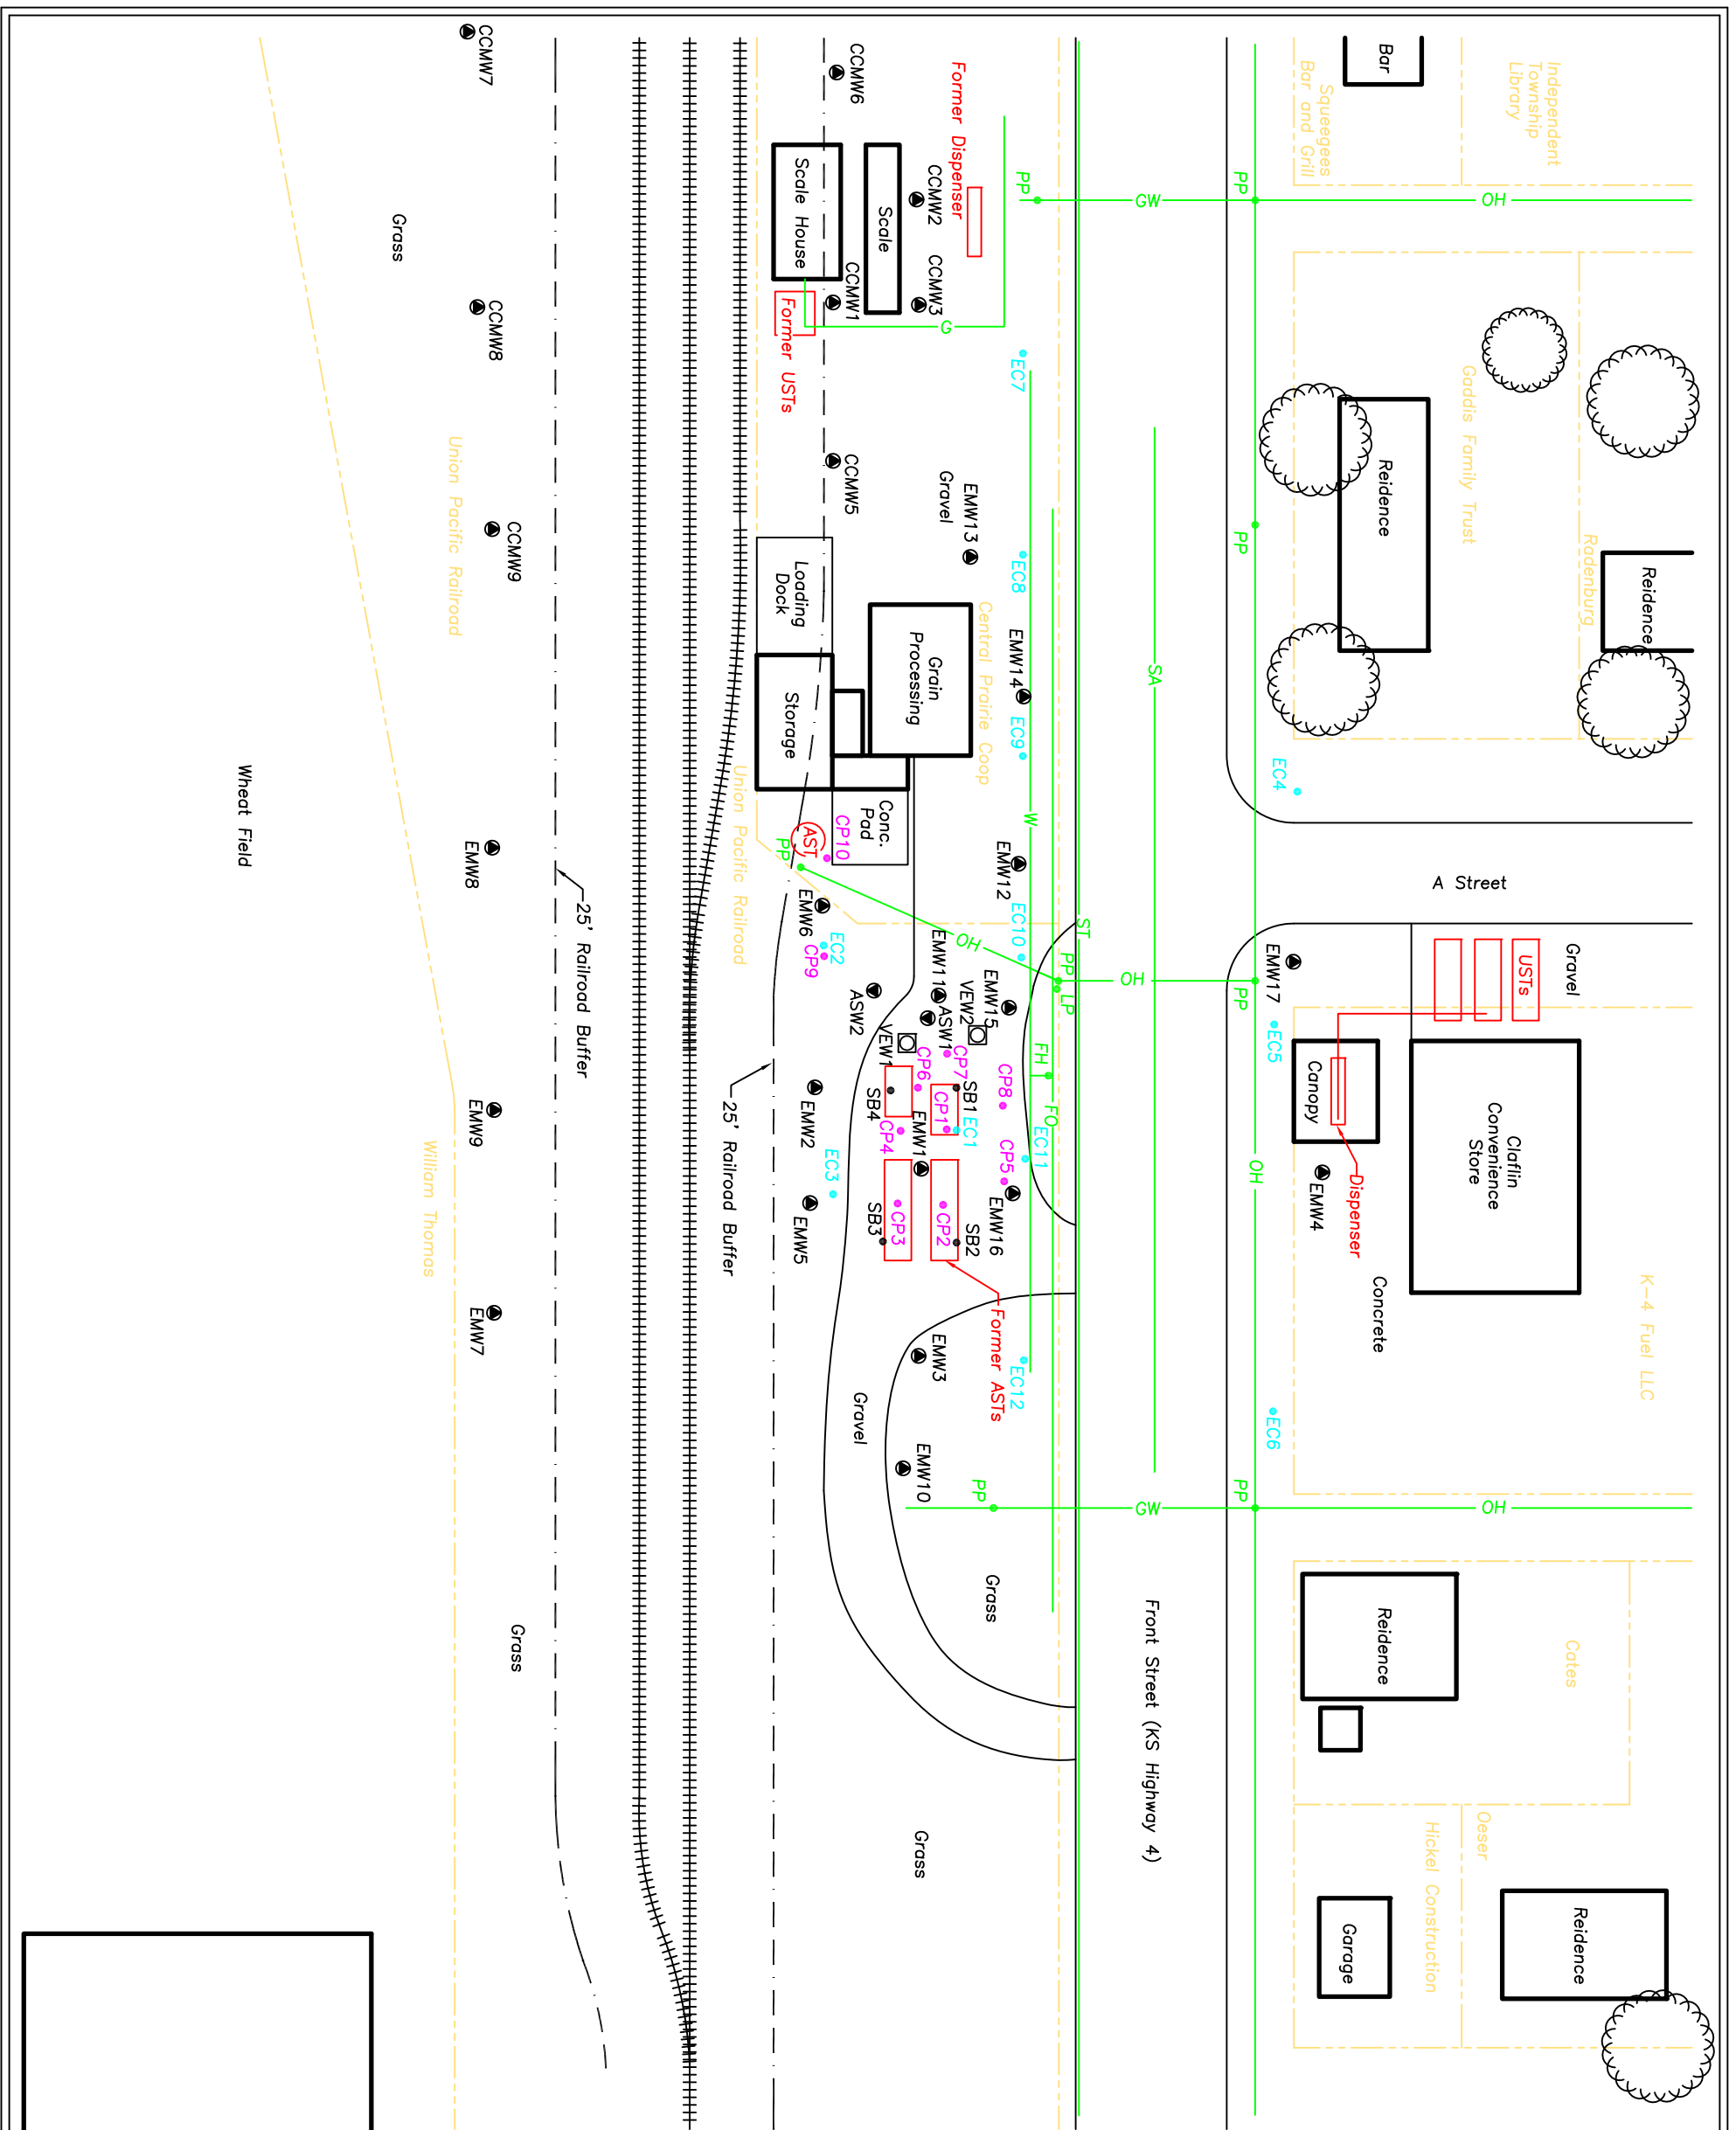

Legend

- EMW1 – Essmiller Monitoring Well
- CCMW1 – Claflin Coop Monitoring Well (Existing)
- ☐ VEW1 – Vapor Extraction Well
- Air Sparge Well
- EC1 – Electric Conductivity Probe
- CP1 – Continuous Probe
- SB1 – Soil Boring (GSI 2020)
- Property Line
- Union Pacific Railroad – Property Owner Name
- OH – Overhead Power Line
- SA – Sanitary Sewer Line (~4' deep)
- FO – Fiber Optic (~3' Deep)
- W – Water Line (~4' deep)
- G – Gas Line (~3' deep)
- BT – Buried Telephone (~3' deep)
- ST – Storm Sewer (~2' deep)
- GW – Guy Wire
- Ppe – Power Pole
- LP – Light Pole
- Mh – Manhole
- Ped – Phone Pedestal
- WM – Water Meter
- FH – Fire Hydrant
- CO – Clean Out
- Tree

Scale In Feet
0 50 100

| |
|--------------------------------------|
| Site Base Map |
| Essmiller Oil Co. |
| Claflin, Kansas |
| KDHE Project Code: A6-005-40491 |
| RDR Addendum |
| CGP Project #21916K |
| Prepared By: MK Date: 02-11-2022 |
| Reviewed By: MK Date: 02-11-2022 |
| Figure 1.3 |
| CGP, Inc. P0 Box 23, Wahoo, NE 68066 |