

WATER WELL RECORD Form WWC-5

Original Record Correction Change in Well Use

Division of Water Resources App. No.

Well ID

1 LOCATION OF WATER WELL: County: Fraction Section Number Township Number Range Number

2 WELL OWNER: Last Name: Business: Address: City: State: ZIP: Street or Rural Address where well is located

3 LOCATE WELL WITH 'X' IN SECTION BOX: NW NE SW SE

4 DEPTH OF COMPLETED WELL: Depth(s) Groundwater Encountered: WELL'S STATIC WATER LEVEL: Pump test data: Estimated Yield: Bore Hole Diameter:

5 Latitude: Longitude: Datum: Source for Latitude/Longitude: 6 Elevation: Source:

7 WELL WATER TO BE USED AS: 1. Domestic: 2. Irrigation: 3. Feedlot: 4. Industrial: 5. Public Water Supply: 6. Dewatering: 7. Aquifer Recharge: 8. Monitoring: 9. Environmental Remediation: 10. Oil Field Water Supply: 11. Test Hole: 12. Geothermal: 13. Other

Was a chemical/bacteriological sample submitted to KDHE? Water well disinfected?

8 TYPE OF CASING USED: CASING JOINTS: Casing diameter: Casing height above land surface: TYPE OF SCREEN OR PERFORATION MATERIAL: SCREEN OR PERFORATION OPENINGS ARE: SCREEN-PERFORATED INTERVALS: GRAVEL PACK INTERVALS:

9 GROUT MATERIAL: Grout Intervals: Nearest source of possible contamination: Direction from well?

Table with columns: FROM, TO, LITHOLOGIC LOG, FROM, TO, LITHO. LOG (cont.) or PLUGGING INTERVALS. Includes a Notes section.

11 CONTRACTOR'S OR LANDOWNER'S CERTIFICATION: This water well was constructed, reconstructed, or plugged under my jurisdiction and was completed on (mo-day-year) and this record is true to the best of my knowledge and belief.

FULL SITE SURVEY

Central Prairie Coop
City of Clafflin, Barton County, Kansas

| Point | North Coordinate | East Coordinate | Distance SE Cor. Sec. 4 North West | From Sec. 4 West | * Elev. Top of Rim or PK Nail | Elev. Top of PVC Pipe | Latitude North | Longitude West |
|---------------------------|------------------|-----------------|------------------------------------|------------------|-------------------------------|-----------------------|----------------|----------------|
| SE Cor. Sec. 04-T18S-R11W | 10000 | 10000 | | | | | | |
| Well - M.W. - 1 | 15020.88 | 9914.90 | 5070.88 | 85.10 | 1803.48 | 1802.97 | 38.52119 | 98.53603 |
| Well - M.W. - 2 | 14969.20 | 9911.62 | 4969.20 | 86.38 | 1803.65 | 1803.39 | 38.52105 | 98.53604 |
| Well - M.W. - 3 | 14918.57 | 9928.52 | 4918.57 | 71.48 | 1802.68 | 1802.33 | 38.52091 | 98.53598 |
| Well - M.W. - 4 | 15064.58 | 9895.95 | 5064.58 | 104.05 | 1804.07 | 1803.71 | 38.52131 | 98.53609 |
| Well - M.W. - 5 | 15011.39 | 9977.93 | 5011.39 | 22.07 | 1804.80 | 1804.53 | 38.52116 | 98.53581 |
| Well - M.W. - 6 | 14948.34 | 9973.27 | 4948.34 | 26.73 | 1804.31 | 1803.92 | 38.52099 | 98.53582 |
| Well - M.W. - 7 | 15018.93 | 9872.02 | 5018.93 | 127.98 | 1803.61 | 1803.29 | 38.52118 | 98.53618 |
| Well - M.W. - 8 | 14958.01 | 9853.62 | 4958.01 | 146.38 | 1803.24 | 1802.84 | 38.52110 | 98.53624 |
| Well - M.W. - 9 | 14850.08 | 9872.85 | 4850.08 | 127.15 | 1802.45 | 1802.01 | 38.52072 | 98.53617 |
| Well - M.W. - 10 | 15049.35 | 9843.18 | 5049.35 | 156.82 | 1804.46 | 1804.11 | 38.52127 | 98.53627 |
| Well - M.W. - 11 | 15027.12 | 9779.76 | 5027.12 | 20.24 | 1804.41 | 1804.13 | 38.52121 | 98.53649 |
| Well - M.W. - 12 | 14948.07 | 9796.65 | 4948.07 | 203.35 | 1803.03 | 1802.56 | 38.52099 | 98.53643 |
| Well - M.W. - 13 | 14845.74 | 9886.74 | 4845.74 | 13.26 | 1805.07 | 1804.50 | 38.52071 | 98.53577 |
| Well - M.W. - 14 | 14732.78 | 9928.42 | 4732.78 | 71.58 | 1803.47 | 1802.96 | 38.52040 | 98.53597 |
| Well - M.W. - 15 | 14977.44 | 10017.87 | 4977.44 | 17.87E. | 1804.55 | 1804.19 | 38.52107 | 98.53566 |
| Well - M.W. - 16 | 14631.21 | 9985.34 | 4631.21 | 14.66 | 1805.36 | 1804.94 | 38.52012 | 98.53578 |
| Well - M.W. - 17 | 15081.78 | 9912.06 | 5081.78 | 287.47 | 1804.95 | 1804.43 | 38.52136 | 98.53673 |
| Well - M.W. - 18 | 15123.97 | 9912.06 | 5123.97 | 87.94 | 1805.26 | 1804.88 | 38.52148 | 98.53603 |
| Well - M.W. - 19 | 15117.69 | 9858.51 | 5117.69 | 141.49 | 1805.09 | 1805.24 | 38.52146 | 98.53622 |
| Well - M.W. - 20 | 15086.28 | 9848.61 | 5086.28 | 151.39 | 1805.12 | 1804.68 | 38.52137 | 98.53625 |
| Well - M.W. - 21 | 15188.59 | 9854.64 | 5188.59 | 145.36 | 1804.06 | 1803.55 | 38.52165 | 98.53623 |
| Well - V.E.W. - 1 | 15021.44 | 9852.67 | 5021.44 | 147.33 | 1803.78 | 1803.24 | 38.52120 | 98.53624 |
| Well - V.E.W. - 2 | 15017.51 | 9843.08 | 5017.51 | 156.92 | 1803.88 | 1803.49 | 38.52118 | 98.53620 |
| Well - A.S. - 1 | 15014.47 | 9863.28 | 5014.47 | 136.72 | 1803.70 | 1803.25 | 38.52118 | 98.53620 |
| Well - A.S. - 2 | 15001.10 | 9855.97 | 5001.10 | 144.03 | 1803.76 | 1803.29 | 38.52114 | 98.53623 |
| Soil Boring - SB1 | 14958.39 | 9741.79 | 4958.39 | 258.21 | | | | |
| Soil Boring - SB2 | 14930.83 | 9743.92 | 4930.83 | 256.08 | | | | |
| Soil Boring - SB3 | 14934.40 | 9788.46 | 4934.40 | 211.54 | | | | |
| Soil Boring - SB4 | 14983.09 | 9803.10 | 4983.09 | 196.90 | | | | |
| Soil Boring - SB5 | 15002.79 | 9829.87 | 5002.79 | 170.13 | | | | |
| Soil Boring - SB6 | 15014.17 | 9847.66 | 5014.17 | 152.34 | | | | |
| Soil Boring - SB7 | 15027.94 | 9867.92 | 5027.94 | 132.08 | | | | |
| Soil Boring - SB8 | 15079.18 | 9948.29 | 5079.18 | 51.71 | | | | |
| Soil Boring - SB9 | 15006.19 | 9870.74 | 5006.19 | 29.26 | | | | |
| EC Log - 1 | 15032.53 | 9871.76 | 5032.53 | 128.24 | | | | |
| EC Log - 2 | 15008.80 | 9870.34 | 5008.80 | 129.66 | | | | |
| EC Log - 3 | 14982.32 | 9870.62 | 4982.32 | 129.38 | | | | |
| EC Log - 4 | 14959.97 | 9870.73 | 4959.97 | 129.27 | | | | |
| EC Log - 5 | 14908.58 | 9791.09 | 4908.58 | 208.91 | | | | |
| EC Log - 6 | 14908.18 | 9807.63 | 4908.18 | 292.37 | | | | |
| EC Log - 7 | 14907.52 | 9823.07 | 4907.52 | 276.93 | | | | |
| EC Log - 8 | 14906.81 | 9838.95 | 4906.81 | 261.05 | | | | |
| EC Log - 9 | 14906.98 | 9853.56 | 4906.98 | 246.44 | | | | |
| EC Log - 10 | 14906.10 | 9869.12 | 4906.10 | 230.88 | | | | |
| EC Log - 11 | 14905.93 | 9883.53 | 4905.93 | 116.47 | | | | |
| EC Log - 12 | 14904.30 | 9896.88 | 4904.30 | 103.12 | | | | |
| EC Log - 13 | 14902.23 | 9909.67 | 4902.23 | 90.33 | | | | |
| EC Log - 14 | 14903.35 | 9921.91 | 4903.35 | 78.09 | | | | |
| EC Log - 15 | 14902.82 | 9936.55 | 4902.82 | 63.45 | | | | |
| Site B.M. | 15079.18 | 9948.29 | 5079.18 | 51.71 | | | | |



Description: "□" Square cut on southeast corner of sign base

LEGEND

- MW1 ⊕ MONITOR WELL LOCATION
- VIEW1 ⊕ SOIL VAPOR EXTRACTION WELL LOCATION
- AS1 ⊕ AIR SPARGE WELL LOCATION
- ⊕ SITE BENCHMARK
- ⊕ POWER POLE
- ⊕ FIRE HYDRANT
- ⊕ WATER METER
- ⊕ TELEPHONE PEDESTAL
- ⊕ DRAINAGE DIRECTION
- OE — OVERHEAD ELECTRIC LINE
- W — WATER LINE
- T — UNDERGROUND TELEPHONE LINE



2017 Vonesta Place, Suite 110 • Manhattan, Kansas 66503
(785) 776-0541 • FAX 776-9760 • Email: tim@smhconsultants.com
Project #1808MN1224 DD #112

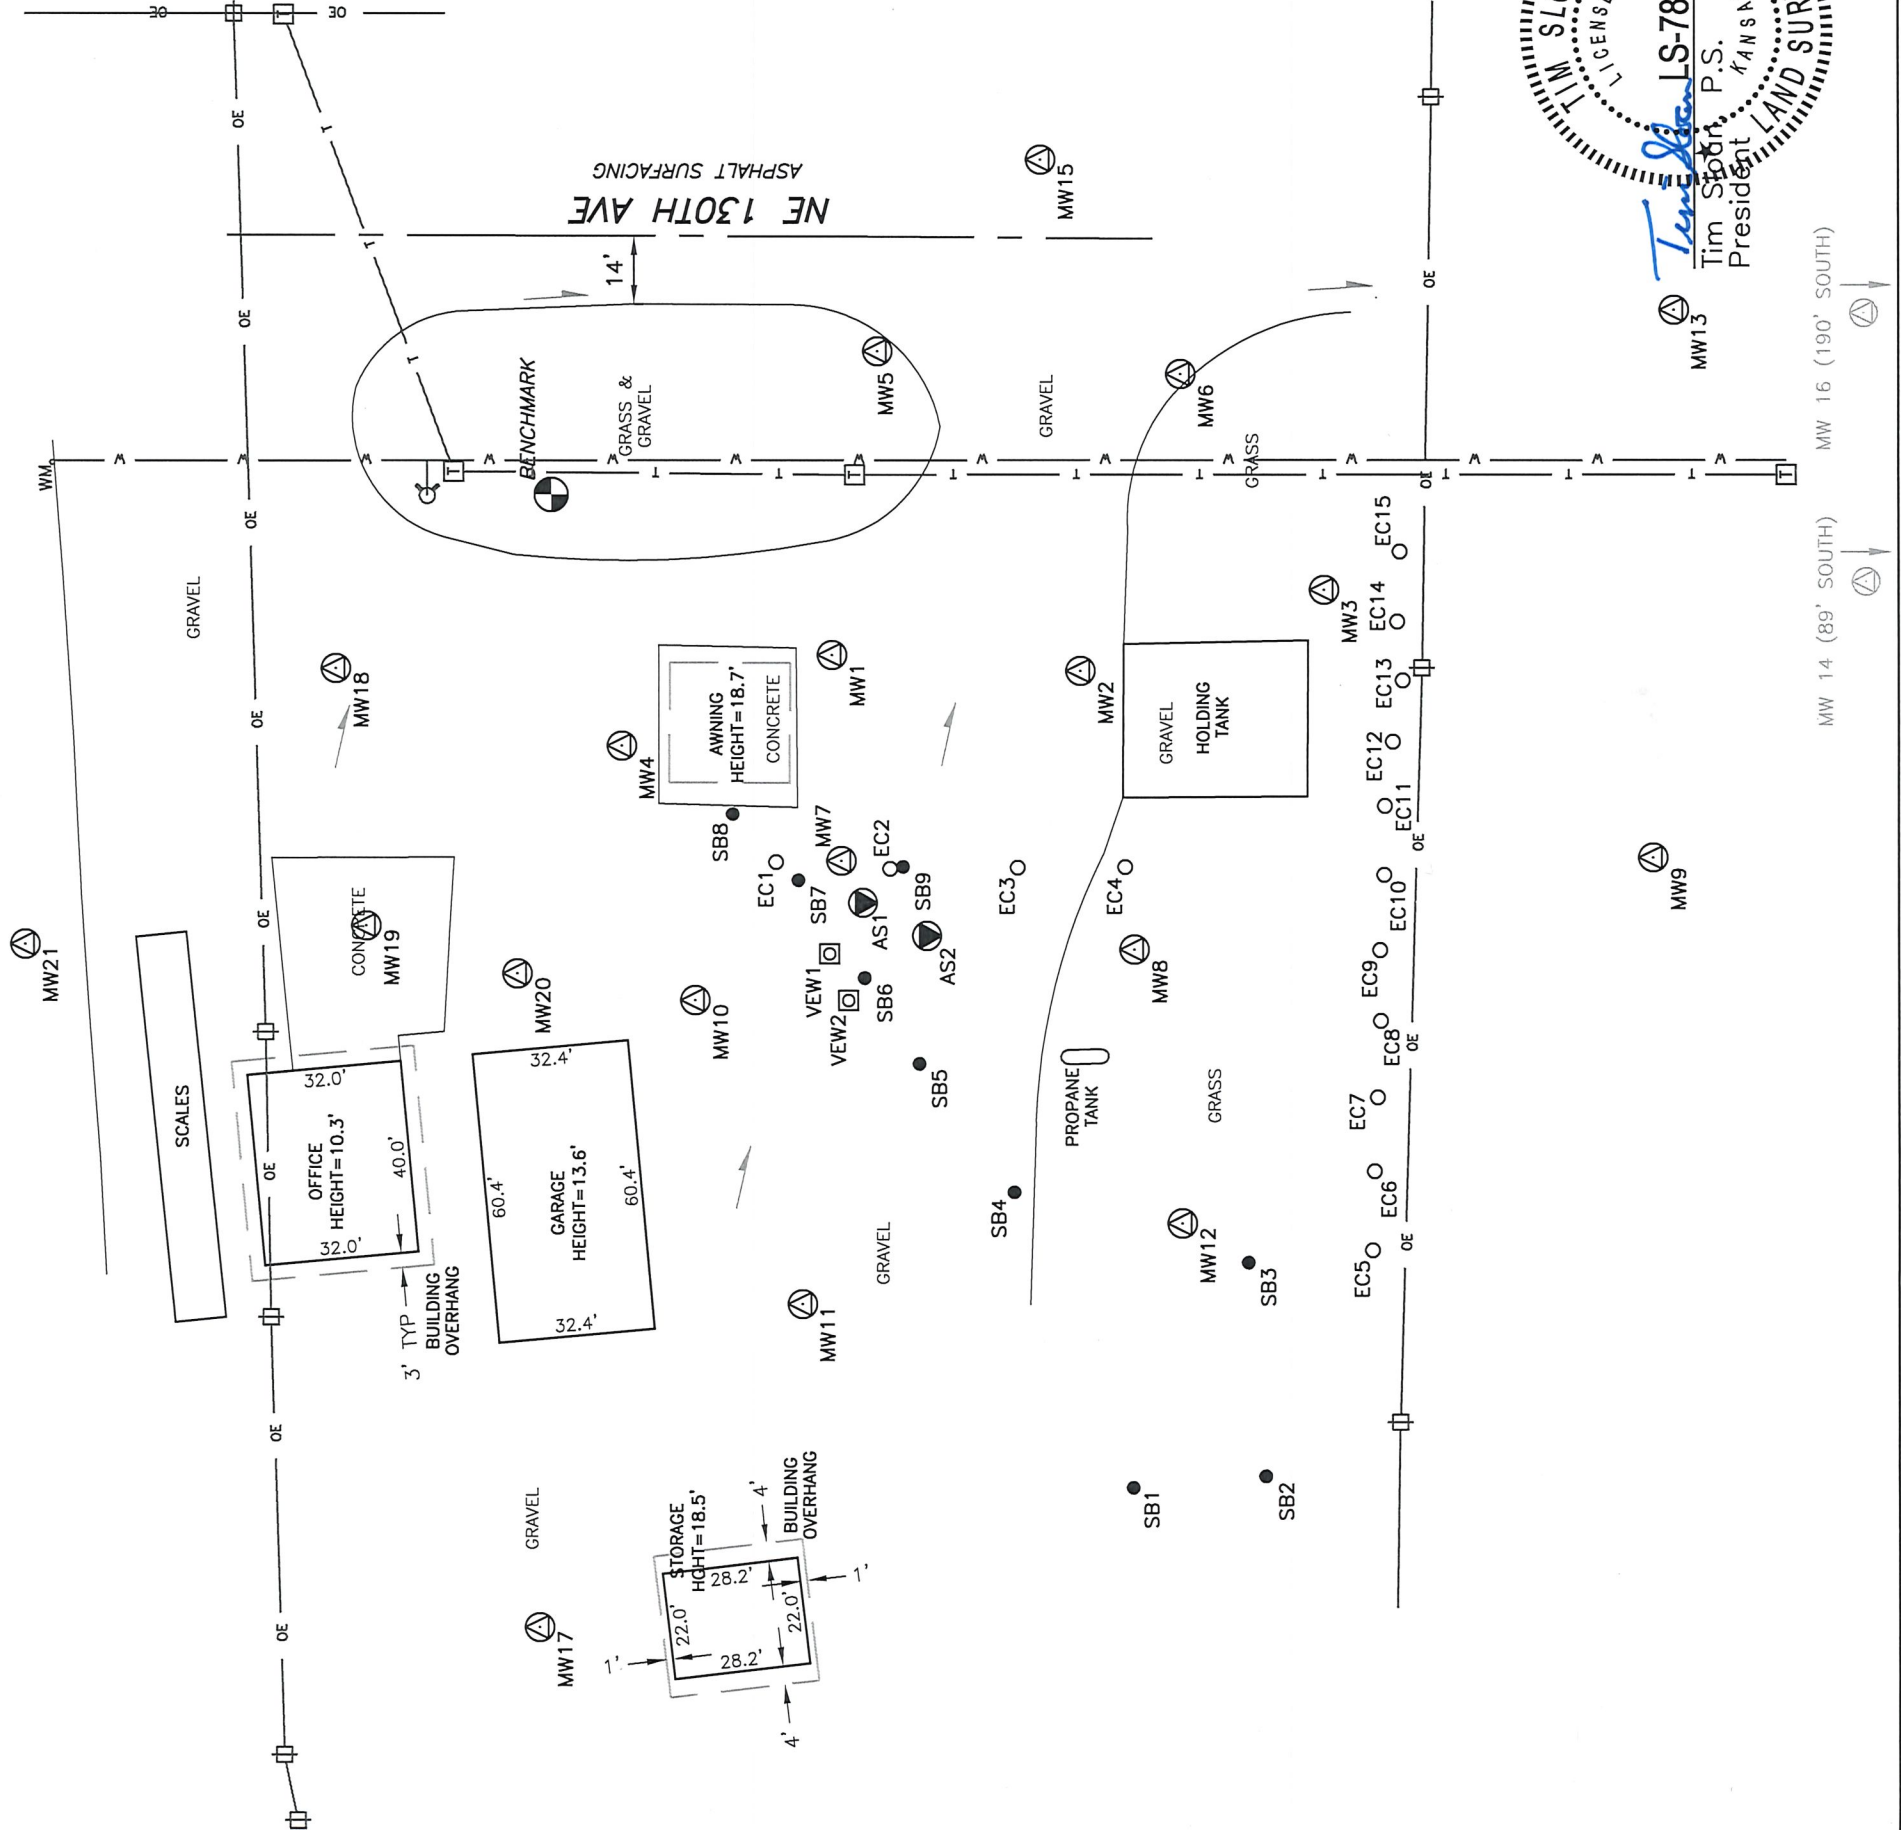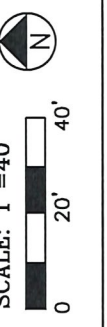

TIM SLOAN
LICENSED
LS-783161219
Tim Sloan P.S.
President
KANSAS LAND SURVEYORS

MW 14 (89' SOUTH)
MW 16 (190' SOUTH)