
				WWC-5		ivision of Water			MW-1S	
				e in Well Use		sources App. No.	Taumahin Numh	Well ID	ge Number	
	y: Barton	WATER WEL	، L :	Fraction NE ¼ NW ¼ NE ½		ection Number 4	Township Numb		$\Box E \blacksquare W$	
	OWNER:	Last Name:		First:		ural Address wh	ere well is located			
Business	Business: Kansas Dept. of Health and Environment					direction from nearest town or intersection): If at owner's address, check here:				
Address: Address:						1097 NE 130 Ave., Claflin				
City: Topeka State: KS ZIP: 66612										
3 LOCAT					40		38.52152	22	· · · · · · · · · · · · · · · · · · ·	
WITH '				IPLETED WELL: Encountered: 1)		IL. 5 Latitude	de: -98.5387	778 (decimal degrees)	
	ON BOX: N		2) ft. 3) ft., or			Horizont	al Datum: WGS 84	• 🔳 NAD 8	$3 \square \text{NAD } 27$	
· · · · · · ·		WELL'S STATIC WATER LEVEL:			ft.	Source fo	or Latitude/Longitude			
NW	NE	D above land surface, measured on (mo-da Pump test data: Well water was				(WAAS enabled? ☐ Yes ☐ No) ■ Land Survey ☐ Topographic Map			0	
w		1 ~	after hours pumping							
	SE		Well water was							
	1		after hours pumping			6 Elevatio	n :ft.	Ground]	Level 🗖 TOC	
	S	Estimated Yield:gpm Bore Hole Diameter:7 in. to								
	1 mile			in. to	ft. 🗌 Other					
7 WELL	WATER T	O BE USED A	S:							
1. Domestic										
House	ahold & Garden			g: how many wells?						
Livest		8.	 7. Aquifer Recharge: well ID 8. Monitoring: well ID			12. Geothern	12. Geothermal: how many bores?			
2. 🗌 Irrigat	ion	9. Er	vironmenta	al Remediation: well I	D	a) Closed Loop \square Horizontal \square Vertical				
3. 🗖 Feedlo			☐ Air Sparge ☐ Soil Vapor				b) Open Loop Surface Discharge Inj. of Water 13. Other (specify):			
4. 🗌 Indust		·	Recovery							
Was a chemical/bacteriological sample submitted to KDHE? 🗆 Yes 🔳 No If yes, date sample was submitted:										
	Water well disinfected? ☐ Yes ■ No 8 TYPE OF CASING USED: ☐ Steel ■ PVC ☐ Other CASING JOINTS: ☐ Glued ☐ Clamped ☐ Welded ■ Threaded									
Casing diam	neter 2	in. to	30 _{ft}	Diameter	in to	ft. Diamete	r in. to	the weided	Theaded	
Casing diameter										
	TYPE OF SCREEN OR PERFORATION MATERIAL:									
□ Steel □ Stainless Steel □ Fiberglass ■ PVC □ Other (Specify)										
□ Brass □ Galvanized Steel □ Concrete tile □ None used (open hole) SCREEN OR PERFORATION OPENINGS ARE:										
	nuous Slot				orch Cut 🔲	Drilled Holes] Other (Specify)			
		🗌 Key Punch	ed 🗌 W	ire Wrapped 🛛 🗌 Sa	w Cut 🛛 🗖	None (Open Hole)			
SCREEN-I	PERFORAT	ED INTERVA	LS: From	30 ft. to 40	ft., From	ft. to	ft., From	ft. to	ft.	
GRAVEL PACK INTERVALS: From										
9 GROUT MATERIAL: □ Neat cement □ Cement grout ■ Bentonite ■ Other Concrete Grout Intervals: From										
Nearest source of possible contamination:										
□ Septic Tank □ Lateral Lines □ Pit Privy □ Livestock Pens □ Insecticide Storage										
Sewer Lines Cess Pool Sewage Lagoon Fuel Storage Abandoned Water Well Watertight Sewer Lines Seepage Pit Feedyard Fertilizer Storage Oil Well/Gas Well								ell		
			eepage Pit	🔲 Feedyard	L.	Fertilizer Storag	e 🗌 Oil Wel	l/Gas well		
□ Other (Specify) Direction from well?										
10 FROM	TO	L	THOLOG		FROM		THO. LOG (cont.) or	PLUGGING	INTERVALS	
0		Clay with silt		·						
3	9 11	Clay, Brown					···			
9 11	42	Sand, vf, some silt Clay, Brown								
11	72	Clay, Blown								
					Notes:	· · · · · · · · · · · · · · · · · · ·				
11 CONTRACTOR'S OR LANDOWNER'S CERTIFICATION: This water well was constructed, reconstructed, or plugged under my jurisdiction and was completed on (mo-day-year) .4/24/2019 and this record is true to the best of my knowledge and belief.										
Kansas Water Well Contractor's License No. 527 This Water Well Record was completed on (mo-day-year) 5/1.3/2019										
under the h	usiness nan	ne of GeoCor	e. LLC			ignature	Ic. a. In Ve	<u> </u>		
Mail	1 white copy a	ong with a fee of \$	5.00 for eacl	h constructed well to: Kar	isas Departmer	nt of Health and Env	ironment, Bureau of Wa	ter, GWTS See	stion,	
1000 SW Jackson St., Suite 420, Topeka, Kansas 66612-1367. Mail one to Water Well Owner and retain one for your records. Telephone 785-296-5524. Visit us at http://www.kdheks.gov/waterwell/index.html KSA 82a-1212 Revised 7/10/2015										

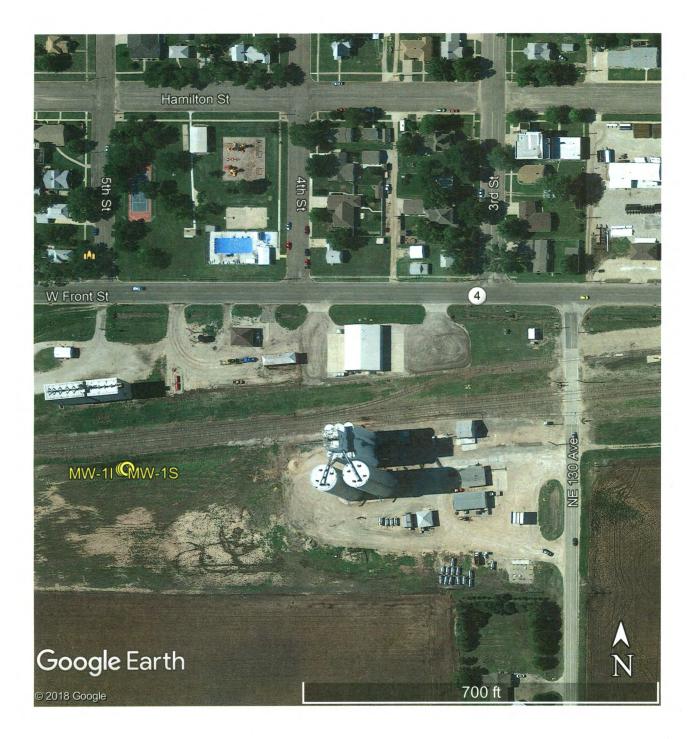

Facility Address: Central Prairie Coop 1097 NE 130 Ave., Claflin Well Owner: KDHE

GPS Coordinates:

MW-1S:	38.5215222, -98.5387778
MW-1I:	38.5215222, -98.5387944
MW-1D:	38.5215194, -98.5388083

RECEIVED MAY 2 9 2019 BUREAU OF WATER