
			Form WW(			vision of Water			MW-1I	
		Correction				ources App. No.		Well ID	ac Number	
		WATER WELI				ction Number 4	Township Numb		ige Number 1 □ E ■ W	
	y: Barton			4 NW ¼ NE ½		ural Address where well is located (if unknown, distance and				
2 WELL OWNER: Last Name: First: Street or Rural Address where well is located (if unknown, dist direction from nearest town or intersection): If at owner's address, chec									check here:	
Address:		Jackson St.,		1011				. o acceroso,		
Address:					1097 NE 1	30 Ave., Clafli	n			
City:	Topeka	S	State: KS ZIP:	66612						
3 LOCAT		4 DEPTH	OF COMPLET	TED WELL:	60 f	t. 5 Latitude	38.52152	22	(decimal degrees)	
WITH "	'X" IN ON BOX:		undwater Encoun			Longitu	de: -98,5387	7944	(decimal degrees)	
	N BOA:		ft. 3)			Horizont	al Datum: WGS 8	4 🖾 NAD	83 NAD 27	
	T X		ATIC WATER L				or Latitude/Longitude			
'	1 ' 1		nd surface, measu				(unit make/model: (WAAS enabled? □			
NW	NE		above land surface, measured on (mo-day-yr)  Pump test data: Well water was			1	Survey ☐ Topogr		,0)	
l wl-	E	1 -	after hours pumping gpm				ne Mapper:			
ew.	SE		Well water was ft.							
3\	35		after hours pumping			6 Elevation:ft. Ground Level TOC				
	S	Pore Hole Di	Estimated Yield:gpm Bore Hole Diameter:7in. to63			Source:    Land Survey    GPS    Topographic Map				
<u>├</u> 1₁	-	Bole Hole Di	in. to ft.				Other			
7 WELL WATER TO BE USED AS:										
1. Domestic			Public Water Sup	ply: well ID		10. 🔲 Oil F	ield Water Supply: Id	ase		
	☐ Household 6. ☐ Dewatering: how many wells?					11. Test Hole: well ID				
_	☐ Lawn & Garden 7. ☐ Aquifer Recharge: well ID				A/ 41		☐ Cased ☐ Uncased ☐ Geotechnical			
						12. Geothermal: how many bores?				
	2. ☐ Irrigation 9. Environmental Remediation: well III 3. ☐ Feedlot ☐ Air Sparge ☐ Soil Vapor F					a) Closed Loop ☐ Horizontal ☐ Vertical b) Open Loop ☐ Surface Discharge ☐ Inj. of Water				
4. Industrial Recovery				☐ Injection	· · · · · · · · · · · · · · · · · · ·					
Was a chemical/bacteriological sample submitted to KDHE?  \( \square\) Yes \( \square\) No If yes, date sample was submitted:										
Water well disinfected?  Yes No										
8 TYPE OF CASING USED: ☐ Steel ■ PVC ☐ Other										
Casing diameter 2 in to 50 ft. Diameter in to ft. Diameter in to ft.										
Casing height above land surface										
TYPE OF SCREEN OR PERFORATION MATERIAL:										
☐ Steel ☐ Stainless Steel ☐ Fiberglass ■ PVC ☐ Other (Specify)										
☐ Brass ☐ Galvanized Steel ☐ Concrete tile ☐ None used (open hole)  SCREEN OR PERFORATION OPENINGS ARE:										
☐ Continuous Slot ☐ Mill Slot ☐ Gauze Wrapped ☐ Torch Cut ☐ Drilled Holes ☐ Other (Specify)										
□ Louvered Shutter □ Key Punched □ Wire Wrapped □ Saw Cut □ None (Open Hole)										
SCREEN-PERFORATED INTERVALS: From .50 ft. to .60 ft., From										
GRAVEL PACK INTERVALS: From										
9 GROUT MATERIAL: ☐ Neat cement ☐ Cement grout ■ Bentonite ■ Other Concrete  Grout Intervals: From 0 ft. to 3 ft., From ft. to 47 ft., From ft. to ft.										
Nearest source of possible contamination:										
☐ Septic			nteral Lines	☐ Pit Privy	П	Livestock Pens	☐ Insection	ide Storage		
Sewer			ess Pool	☐ Sewage La		Fuel Storage		ned Water V	Well	
☐ Watertight Sewer Lines ☐ Seepage Pit ☐ Feedyard ☐ Fertilizer Storage ☐ Oil Well/Gas Well										
☐ Other (Specify)  Direction from well?  Distance from well?  ft.										
10 FROM	TO TO		THOLOGIC LO		FROM		π. ΓΗΟ. LOG (cont.) or		INTERVALS	
0	3	Clay with silt	Inologic Lo	,G	TROM	TO LI	THO. LOG (cont.) of	LUGGIN	JIVIERVALS	
3	9	Clay, Brown								
9	11	Sand, vf, some	e silt							
11	47.5	Clay, Brown								
47.5	51.5	Clay w/silt								
51.5	53.5	Sand, f					•			
53.5	61	Clay, some silt			Notes:	Notes:				
11 CONTRACTORS OR LANDOWNERS CERTIFICATION. This materials are a second as Table and										
11 CONTRACTOR'S OR LANDOWNER'S CERTIFICATION: This water well was constructed, reconstructed, or plugged under my jurisdiction and was completed on (mo-day-year) .4/24/2019 and this record is true to the best of my knowledge and belief.										
Kansas Water Well Contractor's License No. 527 This Water Well Record was completed on (mo-day-year) 5/13/2019										
under the business name of GeoCore, LLC Signature										
Mail 1 white copy along with a fee of \$5.00 for each constructed well to: Kansas Department of Health and Environment, Bureau of Water, GWTS Section, 1000 SW Jackson St., Suite 420, Topeka, Kansas 66612-1367. Mail one to Water Well Owner and retain one for your records. Telephone 785-296-5524.										
							or your records. Teleph	one 785-290-: Revised	7/10/2015	
Visit us at http://www.kdheks.gov/waterwell/index.html KSA 82a-1212 Revised 7/10/2015										

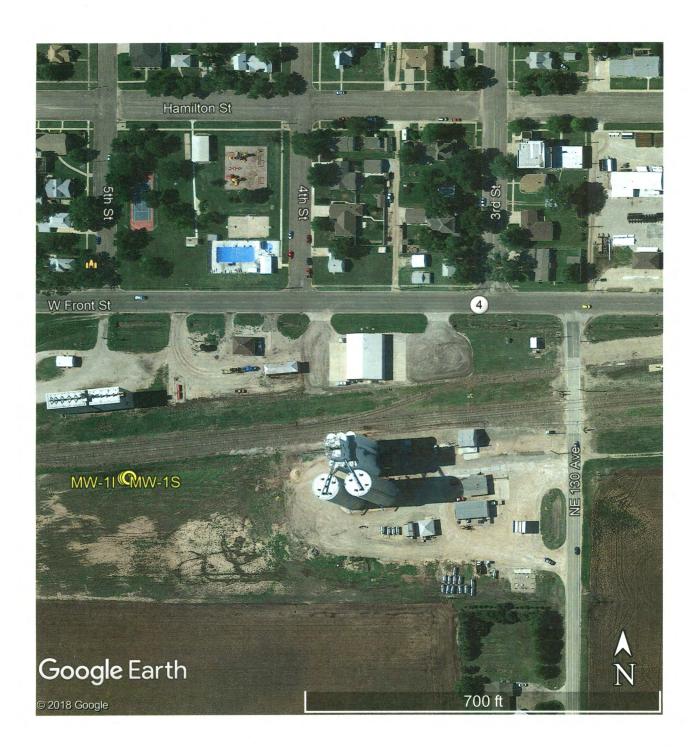

Facility Address: Central Prairie Coop 1097 NE 130 Ave., Claflin Well Owner: KDHE

## **GPS Coordinates:**

MW-1S: 38.5215222, -98.5387778 MW-1I: 38.5215222, -98.5387944 MW-1D: 38.5215194, -98.5388083 RECEIVED

MAY 29 2019

BUREAU OF WATER