
WATER WELL	RECORD	Form V	WWC-5	Di	vision of Wate	er			SVE3	
Original Record			e in Well Use		ources App. 1			Well ID		
1 LOCATION OF V	WATER WEL	L:	Fraction		ction Numbe		ship Numb		nge Number	
County: Barton			NE 14 NE 14 NE 1							
2 WELL OWNER:		Street or Rural Address where well is located (if unknown, distance and								
Business: Central I	direction from nearest town or intersection): If at owner's address, check here:									
Address: PO BOX	159			1097 NE 1	097 NE 130 Avenue, Claflin					
City: Sterling		State: KS	ZIP: 67579							
3 LOCATE WELL	4 DEDTH	OF COM	IPLETED WELL:	26 f	5 T a4:4		38 5212	3	(desimal demans)	
WITH "X" IN					ft. 5 Latitude: 38.52123 (decimal degrees) Longitude: -98.53618 (decimal degrees)					
SECTION BOX:		Depth(s) Groundwater Encountered: 1)				Horizontal Datum: WGS 84 NAD 83 NAD 27				
N			TER LEVEL:			Source for Latitude/Longitude:				
T X	☐ below l	☐ below land surface, measured on (mo-day-yr)				GPS (unit make/model: Spectra Precision Epo.)				
NW NE		above land surface, measured on (mo-day-yr)				(				
	٠ .	Pump test data: Well water was				☐ Land Survey ☐ Topographic Map				
W	anter		ater was		☐ Online Mapper:					
SW SE	after	offer house number on the second								
	Estimated Y	Estimated Yield gnm				6 Elevation: 1803.35ft. ■ Ground Level □ TOC				
S	Bore Hole I	Bore Hole Diameter:11 in. to26 ft. and				Source: Land Survey GPS Topographic Map				
1 mile  in. to ft.										
7 WELL WATER TO BE USED AS:										
1. Domestic:			ter Supply: well ID							
☐ Household ☐ Lawn & Garden	6. Dewatering: how many wells?									
Livestock		7. ☐ Aquifer Recharge: well ID				hermal: how				
2. Irrigation	9. Ei	9. Environmental Remediation: well ID SVE				losed Loop				
3. ☐ Feedlot		☐ Air Sparge ■ Soil Vapor Extraction							Inj. of Water	
4. Industrial		Recovery	☐ Injection		13. 🔲 O	ther (specify	·):			
Was a chemical/bacteriological sample submitted to KDHE? ☐ Yes ■ No If yes, date sample was submitted:										
Water well disinfected? ☐ Yes ■ No										
8 TYPE OF CASING USED: ☐ Steel ■ PVC ☐ Other										
Casing diameter 4 in to 16 ft., Diameter in to ft., Diameter in to ft.										
Casing height above land surface										
TYPE OF SCREEN OR PERFORATION MATERIAL:										
☐ Steel ☐ Stainless Steel ☐ Fiberglass ☐ PVC ☐ Other (Specify)										
SCREEN OR PERFORATION OPENINGS ARE:										
☐ Continuous Slot ☐ Mill Slot ☐ Gauze Wrapped ☐ Torch Cut ☐ Drilled Holes ☐ Other (Specify)										
□ Louvered Shutter □ Key Punched □ Wire Wrapped □ Saw Cut □ None (Open Hole)  SCREEN-PERFORATED INTERVALS: From16										
GRAVEL PACK INTERVALS: From										
9 GROUT MATERIAL: ☐ Neat cement ☐ Cement grout ■ Bentonite ☐ Other										
Grout Intervals: From										
Nearest source of possible contamination:										
☐ Septic Tank       ☐ Lateral Lines       ☐ Pit Privy       ☐ Livestock Pens       ☐ Insecticide Storage         ☐ Sewer Lines       ☐ Cess Pool       ☐ Sewage Lagoon       ☐ Fuel Storage       ☐ Abandoned Water Well										
☐ Watertight Sewer Lines ☐ Seepage Pit ☐ Feedyard ☐ Fertilizer Storage ☐ Oil Well/Gas Well										
Other (Specify)										
Direction from well?										
10 FROM TO		ITHOLOG		FROM	TO	LITHO. LC	OG (cont.) or	PLUGGIN	G INTERVALS	
0 5	Hydroexcava									
5 7	Clay, silty, D		-		<u> </u>					
7 14			o Yellow Brown		<b></b> _	· · · · · · · · · · · · · · · · · · ·				
14 18		Clay, v. silty w/silt strngrs, Brown Clay, silty, Lt. Red Brown			<b> </b>	<u>-</u>				
18 24				1						
24 26	Clay, Lt. Rec	Brown u	nottled Lt. Gray	N-4						
	Notes:									
KDHE Project: Ub-005-15000										
11 CONTRACTOR'S OR LANDOWNER'S CERTIFICATION: This water well was constructed, reconstructed, or plugged										
under my jurisdiction and was completed on (mo-day-year) .2/5/2020 and this record is true to the best of my knowledge and belief.										
Kansas Water Well Contractor's License No. 527 This Water Well Record was completed on (mo day-year) 3/3/2020										
under the business nar	ne of GeoCo	re. LLC		Si	gnature 3	Solle. R	X4	, ,		
Mail 1 white copy along with a fee of \$5.00 for each constructed well to: Kansas Department of Health and Environment, Bureau of Water, GWTS Section, 1000 SW Jackson St., Suite 420, Topeka, Kansas 66612-1367. Mail one to Water Well Owner and retain one for your records. Telephone 785-296-5524.										
			66612-1367. Mail one to	Water Well Ow KSA 82a-12		one for your re	coras. Teleph		-5524. <b>I 7/10/2015</b>	
Visit us at http://www.kdhe	ks.gov/waterwell/i	nucx.nuni		1204 074-17	14			14C 4 13CO	111U14U1J	

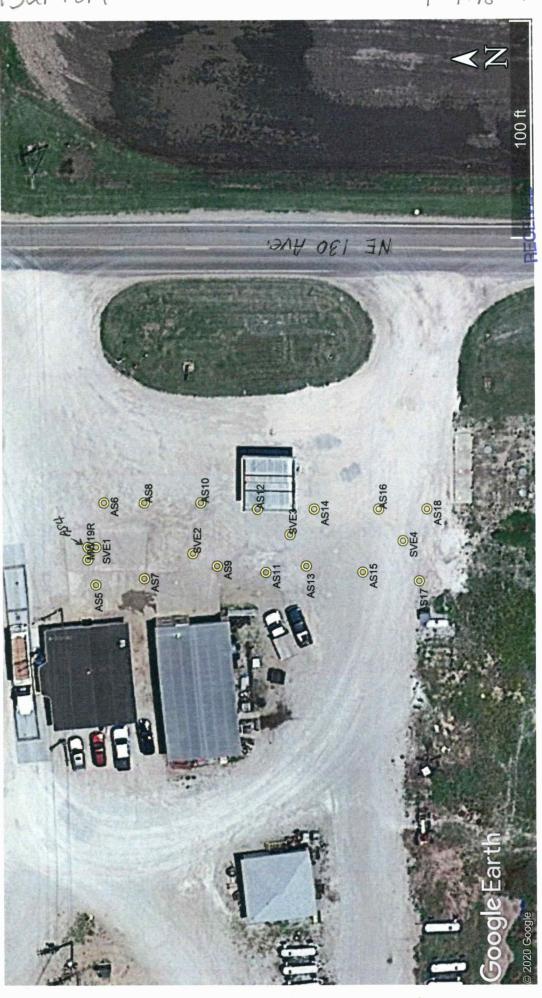

BUREAU OF WATER

MW19R: 38.52148, -98.53622 SVE1: 38.52147, -98.53620 SVE2: 38.52135, -98.53621 38.52123, -98.53618 SVE3: 38.52120, -98.53614 38.52112, -98.53614 38.52107, -98.53624 38.52114, -98.53624

38.52109, -98.53619

SVE4:

38.52106, -98.53614

38.52134, -98.53613 38.52126, -98.53624 38.52127, -98.53614 38.52132, -98.53623 AS10: AS11: AS12: AS9:

AS14: AS15: AS16: AS17: AS18:

38.52121, -98.53623 AS13:

> 38.52146, -98.53613 38.52141, -98.53613 38.52141, -98.53625 AS6: AS7: AS8:

38.52147, -98.53626 AS5:

KDHE Project Code: U6-005-15000

Central Prairie Coop, Claflin

Project Site:

38.52148, -98.53620

AS4:

GPS Coordinates: