
WATER WELL		WWC-5	Div	ision of Water		SVE2	
Original Record		ge in Well Use		ources App. No.		Well ID	
1 LOCATION OF V	WATER WELL:	Fraction		tion Number	Township Numb		
County: Barton	NE ¼	4	T 18 S	R 11 □ E ■ W			
2 WELL OWNER: Last Name: First: Street or Rural Address where well is located (if unknown, distance and							
Business: Central Prairie Coop Address: PO Box 159 direction from nearest town or intersection): If at owner's address, check her							
Address: 1097 NE 130 Avenue, Claffin							
City: Sterling	State: KS	ZIP: 67579					
3 LOCATE WELL WITH "Y" IN 4 DEPTH OF COMPLETED WELL:26 ft. 5 Latitude:38.52135							
WITH "X" IN		Encountered: 1)				221 (decimal degrees)	
SECTION BOX:		3) ft., or 4) □		Dry Well Horizontal Datum: WGS 84 NAD 83 NAD 27			
	WELL'S STATIC WA	ATER LEVEL:	ft.	Source for	or Latitude/Longitude	:	
		e, measured on (mo-day-					
NWNE	NWNE □ above land surface, measured on (mo-day-y Pump test data: Well water was			(***===* ******************************			
	W after hours pumping			☐ Land Survey ☐ Topographic Map ☐ Online Mapper:			
1 1 1 1 1	Well water was ft			Offinic Wapper			
SW SE	after hours pumpinggpm				1804.92	T 0 11 1 T T O 0	
	Estimated Yield:gpm			6 Elevation: 1804.92			
S				Source: Land Survey GPS Topographic Map Other			
7 WELL WATER TO BE USED AS:							
1. Domestic:		ater Supply: well ID		10 🗆 Oil E	ield Water Supply: Id	2250	
1. Domestic: 5. ☐ Public Water Supply: well ID				10. ☐ Oil Field Water Supply: lease			
☐ Lawn & Garden	,						
☐ Livestock 8. ☐ Monitoring: well ID				12. Geothermal: how many bores?			
2. Irrigation 9. Environmental Remediation: well ID				a) Closed Loop ☐ Horizontal ☐ Vertical b) Open Loop ☐ Surface Discharge ☐ Inj. of Water			
3. ☐ Feedlot ☐ Air Sparge ☐ Soil Vapor Ex			xtraction				
Was a chemical/bacteriological sample submitted to KDHE? ☐ Yes ■ No If yes, date sample was submitted:							
8 TYPE OF CASING USED: Steel PVC Other CASING JOINTS: Glued Clamped Welded Threaded							
Casing diameter 4 in to 16 ft. Diameter in to ft. Diameter in to ft.							
Casing diameter 4 in to 16 ft., Diameter in to ft., Diameter in to ft. Casing height above land surface -11.4 in Weight lbs./ft. Wall thickness or gauge No. Sch. 40							
TYPE OF SCREEN OR PERFORATION MATERIAL:							
☐ Steel ☐ Stainless Steel ☐ Fiberglass ☐ PVC ☐ Other (Specify)							
☐ Brass ☐ Galvanized Steel ☐ Concrete tile ☐ None used (open hole) SCREEN OR PERFORATION OPENINGS ARE:							
☐ Continuous Slot ■ Mill Slot ☐ Gauze Wrapped ☐ Torch Cut ☐ Drilled Holes ☐ Other (Specify)							
☐ Louvered Shutter ☐ Key Punched ☐ Wire Wrapped ☐ Saw Cut ☐ None (Open Hole)							
SCREEN-PERFORATED INTERVALS: From16							
GRAVEL PACK INTERVALS: From							
9 GROUT MATERIAL: ☐ Neat cement ☐ Cement grout ☐ Bentonite ☐ Other							
Grout Intervals: From							
Nearest source of possil	ble contamination: Lateral Lin	es 🔲 Pit Privy		Livestock Pens	□ Incoctic	sida Staraga	
☐ Septic Tank ☐ Lateral Lines ☐ Pit Privy ☐ Livestock Pens ☐ Insecticide Storage ☐ Sewer Lines ☐ Cess Pool ☐ Sewage Lagoon ☐ Fuel Storage ☐ Abandoned Water Well							
☐ Watertight Sewer Lines ☐ Seepage Pit ☐ Feedyard ☐ Fertilizer Storage ☐ Oil Well/Gas Well							
☐ Other (Specify)							
Direction from well?							
10 FROM TO	Clay oilty Brown (511)		FROM	TO LI	1HO. LOG (cont.) or	PLUGGING INTERVALS	
0 5 5 21	Clay, silty, Brown (fill) Sand, f-c, w/f gravel,						
21 25	Clay, silty, Lt. Red Br		-				
25 26	Clay, Lt. Gray Brown	OVVII					
	ay Lat. Olay Diowil						
Notes:						-	
KDHE Project 166-005-15000							
11 CONTRACTOR'S OR LANDOWNER'S CERTIFICATION: This water well was constructed, reconstructed, or plugged under my jurisdiction and was completed on (mo-day-year) .2/6/2020 and this record is true to the best of my knowledge and belief.							
Kansas Water Well Contractor's License No. 527 This Water Well Record was completed on (mo-day-year) .3/3/2020							
under the business nan	ne of GeoCore LLC.		Sig	nature	1 Mill		
Mail 1 white copy along with a fee of \$5.00 for each constructed well to: Kansas Department of Health and Environment, Bureau of Water, GWTS Section,							
1000 SW Jackson St., Suite 420, Topeka, Kansas 66612-1367. Mail one to Water Well Owner and retain one for your records. Telephone 785-296-5524.							
visit us at http://www.kdhel	ks.gov/waterwell/index.html		KSA 82a-12	14		Revised 7/10/2015	

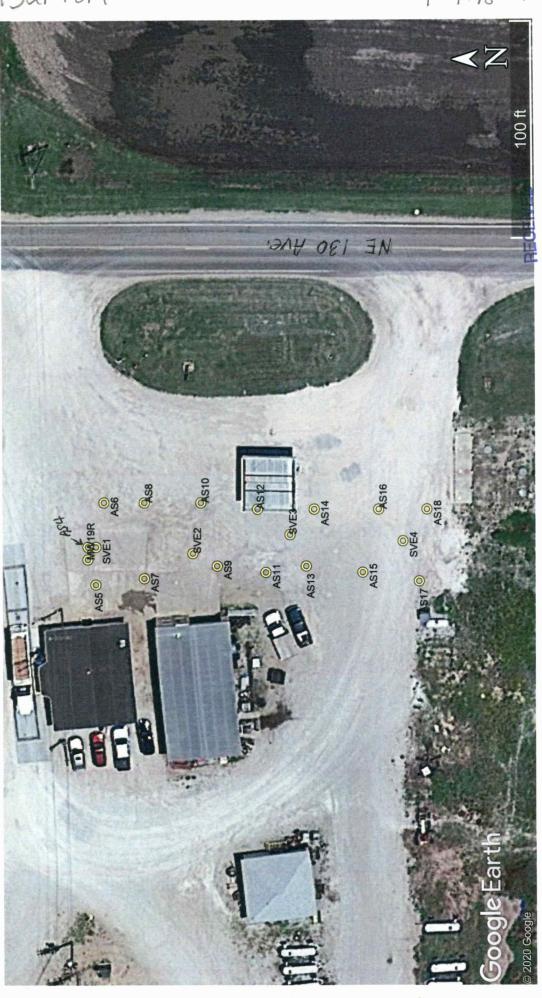

BUREAU OF WATER

MW19R: 38.52148, -98.53622 SVE1: 38.52147, -98.53620 SVE2: 38.52135, -98.53621 38.52123, -98.53618 SVE3: 38.52120, -98.53614 38.52112, -98.53614 38.52107, -98.53624 38.52114, -98.53624

38.52109, -98.53619

SVE4:

38.52106, -98.53614

38.52134, -98.53613 38.52126, -98.53624 38.52127, -98.53614 38.52132, -98.53623 AS10: AS11: AS12: AS9:

AS14: AS15: AS16: AS17: AS18:

38.52121, -98.53623 AS13:

> 38.52146, -98.53613 38.52141, -98.53613 38.52141, -98.53625 AS6: AS7: AS8:

38.52147, -98.53626 AS5:

KDHE Project Code: U6-005-15000

Central Prairie Coop, Claflin

Project Site:

38.52148, -98.53620

AS4:

GPS Coordinates: