
WATER WELL RECORD Form WWC-5				vision of Water		AS18	
				ources App. No.		Well ID	
1 LOCATION OF W.	ATER WELL:	Fraction	Se	ction Number	Township Numb		
County: Barton		NE 14 NE 14 NE 14		4	T 18 S	R 11 □E ■ W	
2 WELL OWNER: Last Name: First: Street or Rural Address where well is located (if unknown, distance and							
Business: Central Pr				rection from nearest town or intersection): If at owner's address, check here:			
Address: PO Box 15	59	1					
Address: 1097 NE 130 Avenue, Claffin							
City: Sterling State: KS ZIP: 67579							
3 LOCATE WELL	35 6	F T addange	38 5210	6 (4			
SECTION BOX. 4 DEPTH OF COMPLETED WELL:35							
SECTION BOX: Depth(s) Groundwater Encountered: 1)27.							
2) ft. 3) ft., or 4) \(\sqrt{WELL'S STATIC WATER LEVEL:						4 🖩 NAD 83 🗖 NAD 2	
				Source for	r Latitude/Longitude	: Enactra Bracisian En	
				_ = = = (;			
				· · · · · · · · · · · · · · · · · · ·			
Pump test data: Well water was				☐ Land Survey ☐ Topographic Map			
Well water was ft.				Online Mapper:			
after hours pumping							
Estimated Yield:gpm				6 Elevatio	ո ։ 1803.27 դ	■ Ground Level □ TO	
S	8 in to 35	f and			GPS Topographic Ma		
S Bore Hole Diameter:							
7 WELL WATER TO BE USED AS:							
7 WELL WATER TO BE USED AS: 1. Domestic: 5. □ Public Water Supply: well ID							
I. Domestic:	2. ☐ Laplic Ma	ici suppiy: well ID	••••••				
· —							
☐ Lawn & Garden 7. ☐ Aquifer Recharge: well ID							
					•		
	2. ☐ Irrigation 9. Environmental Remediation: well ID.			, <u> </u>			
3. Feedlot	Air Sparge		extraction				
4. Industrial Recovery Injection 13. Other (specify):							
Was a chemical/bacteriological sample submitted to KDHE? Tyes No If yes, date sample was submitted:							
Water well disinfected?	☐ Yes ■ No						
8 TYPE OF CASING USED: ☐ Steel ■ PVC ☐ Other							
Casing diameter 2 in to 32.5 ft. Diameter in to ft. Diameter in to ft.							
Casing height above land surface6.12 in. Weight							
TYPE OF SCREEN OR PERFORATION MATERIAL:							
	less Steel			☐ Other	(Specify)		
☐ Brass ☐ Galvanized Steel ☐ Concrete tile ☐ None used (open hole)							
SCREEN OR PERFORATION OPENINGS ARE:							
☐ Continuous Slot ■ Mill Slot ☐ Gauze Wrapped ☐ Torch Cut ☐ Drilled Holes ☐ Other (Specify)							
☐ Louvered Shutter ☐ Key Punched ☐ Wire Wrapped ☐ Saw Cut ☐ None (Open Hole)							
SCREEN-PERFORATED INTERVALS: From .32.5. ft. to .35. ft., From ft. to ft. ft. of ft.							
GRAVEL PACK INTERVALS: From 30 ft. to 35 ft., From ft. to ft., From ft. to ft.							
9 GROUT MATERIAL: Neat cement Cement grout Bentonite Other							
Grout Intervals: From 4. ft. to 30 ft., From ft. to ft.							
Nearest source of possible contamination:							
☐ Septic Tank ☐ Lateral Lines ☐ Pit Privy ☐ Livestock Pens ☐ Insecticide Storage ☐ Sewer Lines ☐ Cess Pool ☐ Sewage Lagoon ☐ Fuel Storage ☐ Abandoned Water Well							
□ Watertight Sewer Lines □ Seepage Pit □ Feedyard □ Fertilizer Storage □ Oil Well/Gas Well □ Other (Specify) □ Other (Specify)							
Direction from well?							
10 FROM TO			_			DI LICCDIC DITERMAT	
	LITHOLOG		FROM	10 LI	ino. Log (cont.) or	PLUGGING INTERVAL	
	lydroexcavated - No	Sample					
	clay, sl. silty, Brown						
	Clay, silty, Lt. Brown w						
	Silt, clayey, Red Brow						
16.5 21 C	Clay, silty, Lt. Red Bro	wn					
	lay, sl. silty, Lt. Red I						
	lay, sl. silty, Brown m		Notes:				
	Clay, v. sl. silty, Brown		╡	^			
KDHE Project! Ub-005-15000							
11 CONTRACTOR'S OR LANDOWNER'S CERTIFICATION: This water well was constructed, reconstructed, or plugged							
under my jurisdiction and was completed on (mo-day-year) .1/30/2020 and this record is true to the best of my knowledge and belief.							
Kansas Water Well Contractor's License No. 527 This Water Well Record was completed on in populary-year) 3/3/2020							
under the business name of GeoCore. LLC							
Mail 1 white converse	ng with a fee of \$5 00 for and	constructed well to: Va-	sas Denortmon	gilatuit	ironment Rureau of W.	ater GWTS Section	
Mail 1 white copy along with a fee of \$5.00 for each constructed well to: Kansas Department of Health and Environment, Bureau of Water, GWTS Section, 1000 SW Jackson St., Suite 420, Topeka, Kansas 66612-1367. Mail one to Water Well Owner and retain one for your records. Telephone 785-296-5524.							
Visit us at http://www.kdheks.			KSA 82a-12		or your records. Teleph	Revised 7/10/2015	
	MO . ! TIGIOL ITOLD HIGUALIUM			 			

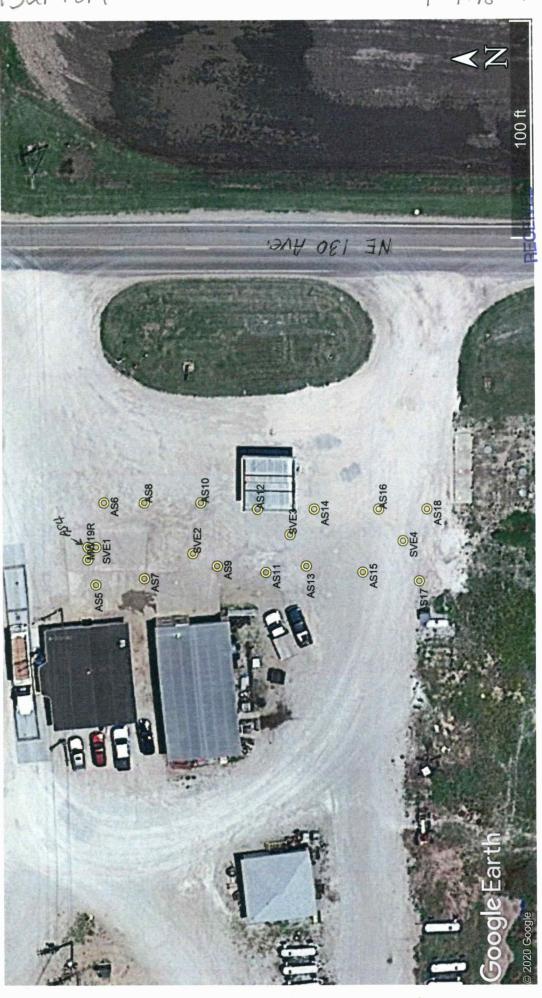

BUREAU OF WATER

MW19R: 38.52148, -98.53622 SVE1: 38.52147, -98.53620 SVE2: 38.52135, -98.53621 38.52123, -98.53618 SVE3: 38.52120, -98.53614 38.52112, -98.53614 38.52107, -98.53624 38.52114, -98.53624

38.52109, -98.53619

SVE4:

38.52106, -98.53614

38.52134, -98.53613 38.52126, -98.53624 38.52127, -98.53614 38.52132, -98.53623 AS10: AS11: AS12: AS9:

AS14: AS15: AS16: AS17: AS18:

38.52121, -98.53623 AS13:

> 38.52146, -98.53613 38.52141, -98.53613 38.52141, -98.53625 AS6: AS7: AS8:

38.52147, -98.53626 AS5:

KDHE Project Code: U6-005-15000

Central Prairie Coop, Claflin

Project Site:

38.52148, -98.53620

AS4:

GPS Coordinates: