
WATER WELL RI		WWC-5		ision of Water			AS16	
Original Record		e in Well Use		ources App. No.	T	Well ID		
1 LOCATION OF WA	ATER WELL:	Fraction		tion Number	Township Numbe		ige Number	
County: Barton		NE 14 NE 14 NE 1/4						
2 WELL OWNER: Last Name: First: Street or Rural Address where well is located (if unknown, distance and								
Business: Central Pra	direction from nearest town or intersection): If at owner's address, check here:							
Address: PO Box 159 Address: 1097 NE 130 Avenue, Claflin								
City: Sterling State: KS ZIP: 67579								
3 LOCATE WELL	I		05 -		20 50442			
WITH "Y" IN 4 DEPTH OF COMPLETED WELL: 89 II. 5 Latitude:							(decimal degrees)	
SECTION BOX:								
2) ft., or 4) \(\subseteq WELL'S STATIC WATER LEVEL:								
below land surface, measured on (mo-day-				Source for Latitude/Longitude.				
above land surface, measured on (mo-day-			·vr)	(WAAS enabled? Yes No)				
Pump test data: Well water was				Land Survey Topographic Map				
w + E					Online Mapper:			
1 ' '	Well water was ft.							
SW SE	gpm	C 1714:	1803.36	M C	H T TOC			
Estimated Yield:gpm				6 Elevation: 1803.36 ft. Ground Level TOC				
S Bore Hole Diameter:8 in. to								
mile in. to								
1. Domestic:		ton Cumulan and 11 175		10 🗆 🗠 🖰	ald Water Committee 1			
I. Domestic: Household		ter Supply: well ID		10. L Oil Fi	eld Water Supply: lea	sc		
☐ Household 6. ☐ Dewatering: how many wells? ☐ Lawn & Garden 7. ☐ Aquifer Recharge: well ID					11. Test Hole: well ID			
☐ Livestock Monitoring: well ID					12. Geothermal: how many bores?			
2. Irrigation 9. Environmental Remediation: well ID				a) Closed Loop Horizontal Vertical				
3. Feedlot Air Sparge Soil Vapor E				b) Open Loop Surface Discharge Inj. of Water				
4. Industrial	☐ Recovery				(specify):			
Was a chemical/bacteriological sample submitted to KDHE? ☐ Yes ■ No If yes, date sample was submitted:								
Water well disinfected? \square Yes \square No								
8 TYPE OF CASING USED: Steel PVC Other CASING JOINTS: Glued Clamped Welded Threaded								
Casing diameter								
Casing height above land surface9.36 in. Weight								
TYPE OF SCREEN OR PERFORATION MATERIAL:								
☐ Steel ☐ Stainless Steel ☐ Fiberglass ■ PVC ☐ Other (Specify)								
☐ Brass ☐ Galvanized Steel ☐ Concrete tile ☐ None used (open hole)								
SCREEN OR PERFORATION OPENINGS ARE:								
☐ Continuous Slot ☐ Mill Slot ☐ Gauze Wrapped ☐ Torch Cut ☐ Drilled Holes ☐ Other (Specify)								
☐ Louvered Shutter ☐ Key Punched ☐ Wire Wrapped ☐ Saw Cut ☐ None (Open Hole)								
SCREEN-PERFORATED INTERVALS: From .32.5 ft. to .35 ft., From ft. to ft., From ft. to ft.								
GRAVEL PACK INTERVALS: From								
9 GROUT MATERIAL: ☐ Neat cement ☐ Cement grout ☐ Bentonite ☐ Other								
Grout Intervals: From								
Nearest source of possible contamination: □ Septic Tank □ Lateral Lines □ Pit Privy □ Livestock Pens □ Insecticide Storage								
☐ Septic Tank ☐ Sewer Lines	☐ Lateral Line: ☐ Cess Pool	s ☐ Pit Privy ☐ Sewage La		Livestock Pens	☐ Insectici			
☐ Watertight Sewer Line		☐ Sewage La		Fuel Storage Fertilizer Storage			Well	
Other (Specify)								
Direction from well?								
10 FROM TO	LITHOLOG		FROM		THO. LOG (cont.) or I	LUGGIN	G INTERVALS	
0 5 H	ydroexcavated - No	Sample						
5 8 C 8 13 C	lay, silty, Brown						,,,,,,,,,,,,,,,,,,,,,,,,,,,,,,,,,,,,,,,	
8 13 C	lay, silty, Lt. Brown w	/occ. wh calc. mat						
13 17 S	ilt, sl. clayey, Red Bro							
17 25 C	lay, v. silty, Lt. Red E							
25 27.5 C	lay, silty, Lt. Gray Bro							
27.5 31 C	lay, Lt. Gray Brown		Notes:					
WHE Project. U.6-003-13000								
11 CONTRACTOR'S OR LANDOWNER'S CERTIFICATION: This water well was constructed, reconstructed, or plugged								
under my jurisdiction and was completed on (mo-day-year) .1/30/2020 and this record is true to the best of my knowledge and belief.								
Kansas Water Well Contractor's License No. 527 This Water Well Record was completed on (mo-day-year) 3/3/2020								
under the business name of GeoCore, LLC. Mail 1 white copy along with a fee of \$5.00 for each constructed well to. Kansas Department of Health and Environment, Bureau of Water, GWTS Section,								
Mail I white copy along with a fee of \$5.00 for each constructed well to: Kansas Department of Health and Environment, Bureau of Water, GW18 Section, 1000 SW Jackson St., Suite 420, Topeka, Kansas 66612-1367. Mail one to Water Well Owner and retain one for your records. Telephone 785-296-5524.								
Visit us at http://www.kdheks.			KSA 82a-12		or your records. Telephol		7/10/2015	

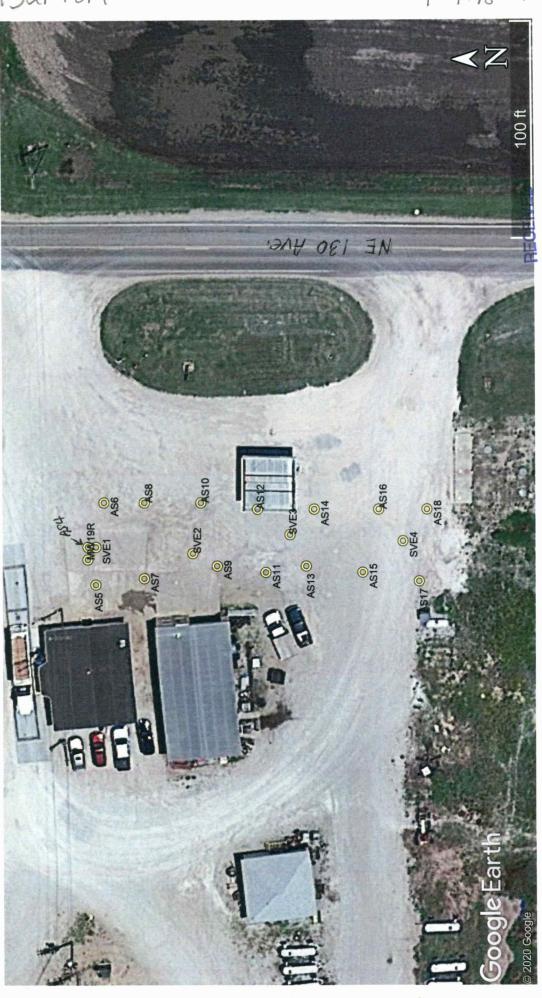

BUREAU OF WATER

MW19R: 38.52148, -98.53622 SVE1: 38.52147, -98.53620 SVE2: 38.52135, -98.53621 38.52123, -98.53618 SVE3: 38.52120, -98.53614 38.52112, -98.53614 38.52107, -98.53624 38.52114, -98.53624

38.52109, -98.53619

SVE4:

38.52106, -98.53614

38.52134, -98.53613 38.52126, -98.53624 38.52127, -98.53614 38.52132, -98.53623 AS10: AS11: AS12: AS9:

AS14: AS15: AS16: AS17: AS18:

38.52121, -98.53623 AS13:

> 38.52146, -98.53613 38.52141, -98.53613 38.52141, -98.53625 AS6: AS7: AS8:

38.52147, -98.53626 AS5:

KDHE Project Code: U6-005-15000

Central Prairie Coop, Claflin

Project Site:

38.52148, -98.53620

AS4:

GPS Coordinates: