
Toriginal Record ☐ Correction ☐ Change in Well Use Correction ☐ Change in Well Use	E ■ W ance and ik here:
County: Barton NE 1/4 NE 1/4 NE 1/4 NE 1/4 NE 1/4 T 18 S R 11 WELL OWNER: Last Name: Business: Central Prairie Coop Address: PO Box 159 Address: City: Sterling State: KS ZIP: 67579 SECTION BOX: N Depth(s) Groundwater Encountered: 1) 27.5 ft. 2)	E ■ W ance and ik here:
2 WELL OWNER: Last Name: Business: Central Prairie Coop Address: PO Box 159 Address: City: Sterling 3 LOCATE WELL WITH "X" IN SECTION BOX: N 4 DEPTH OF COMPLETED WELL: N 4 DEPTH OF COMPLETED WELL: N 5 Latitude: 1097 NE 130 Avenue, Claflin 6 Longitude: 1097 NE 130 Avenue, Claflin	ance and k here:
Business: Central Prairie Coop Address: PO Box 159 Address: City: Sterling State: KS ZIP: 67579 3 LOCATE WELL WITH "X" IN SECTION BOX: N Depth(s) Groundwater Encountered: 1) 27.5 ft. 2) ft., or 4) Dry Well WELL'S STATIC WATER LEVEL: ft. WELL'S STATIC WATER LEVEL: ft. direction from nearest town or intersection): If at owner's address, check 1097 NE 130 Avenue, Claflin 1097 NE 130 Avenue, Claflin 5 Latitude: 38.52114 (deci	k here:
Address: PO Box 159 Address: City: Sterling State: KS ZIP: 67579 3 LOCATE WELL WITH "X" IN SECTION BOX: N 4 DEPTH OF COMPLETED WELL:	
Address: 1097 NE 130 Avenue, Clafiin	mal degrees)
City: Sterling State: KS ZIP: 67579	mal degrees)
3 LOCATE WELL WITH "X" IN SECTION BOX: N 4 DEPTH OF COMPLETED WELL:35	mal degrees)
WITH "X" IN SECTION BOX: N Depth(s) Groundwater Encountered: 1)	mal degrees)
SECTION BOX: N Depth(s) Groundwater Encountered: 1)	
N 2)	
	nion Eno
— Of b (unit make model:	SIOII EDO.)
NWNE	
1 1 1 1 2 2 2 2 2 2	
Well water was ft.	
SW SE	
Estimated Yield:gpm 6 Elevation:003.54tt.	
S Bore Hole Diameter:8 in. to35 ft. and Source: ■ Land Survey □ GPS □ Topog	•
1 mile in. to ft. Uother	
7 WELL WATER TO BE USED AS:	
1. Domestic: 5. Dublic Water Supply: well ID	
☐ Household 6. ☐ Dewatering: how many wells?	
☐ Lawn & Garden 7. ☐ Aquifer Recharge: well ID ☐ Cased ☐ Uncased ☐ Geotechnical	
Livestock 8. Monitoring: well ID	
2. Irrigation 9. Environmental Remediation: well ID AS15	- f Watan
3.	
Was a chemical/bacteriological sample submitted to KDHE? Yes No If yes, date sample was submitted:	
Water well disinfected? ☐ Yes ■ No	
8 TYPE OF CASING USED: ☐ Steel PVC ☐ Other	
Casing diameter	
Casing height above land surface	
TYPE OF SCREEN OR PERFORATION MATERIAL:	
☐ Steel ☐ Stainless Steel ☐ Fiberglass ■ PVC ☐ Other (Specify)	• • • • • • • • • • • • • • • • • • • •
☐ Brass ☐ Galvanized Steel ☐ Concrete tile ☐ None used (open hole) SCREEN OR PERFORATION OPENINGS ARE:	
☐ Continuous Slot ☐ Mill Slot ☐ Gauze Wrapped ☐ Torch Cut ☐ Drilled Holes ☐ Other (Specify)	•••••
SCREEN-PERFORATED INTERVALS: From .32.5 ft. to .35 ft., From ft., From ft., From ft.	
GRAVEL PACK INTERVALS: From30 ft. to35 ft., From ft. to ft., From ft. to	Α
9 GROUT MATERIAL: ☐ Neat cement ☐ Cement grout ☐ Bentonite ☐ Other	• • • • • • •
Nearest source of possible contamination:	
☐ Septic Tank ☐ Lateral Lines ☐ Pit Privy ☐ Livestock Pens ☐ Insecticide Storage	
☐ Sewer Lines ☐ Cess Pool ☐ Sewage Lagoon ☐ Fuel Storage ☐ Abandoned Water Well	Į
☐ Watertight Sewer Lines ☐ Seepage Pit ☐ Feedyard ☐ Fertilizer Storage ☐ Oil Well/Gas Well	
☐ Other (Specify)	
Direction from well?	
10 FROM TO LITHOLOGIC LOG FROM TO LITHO. LOG (cont.) or PLUGGING IN	TERVALS
0 5 Hydroexcavated - No Sample	
5 7 Clay, silty, Brown	
7 12 Clay, v. silty, Yellow Brown	
12 15 Silt, sl. clayey, Lt. Red Brown	
15 23.5 Clay, silty, Yellow Brown	
100 F 107 F 101 W 0 B	
23.5 27.5 Clay, silty, Gray Brown	
23.5 27.5 Clay, silty, Gray Brown 27.5 35 Clay, sl. silty, Brown to Gray Brn mot Gy Notes:	
27.5 35 Clay, sl. silty, Brown to Gray Brn mot Gy Notes:	
27.5 35 Clay, sl. silty, Brown to Gray Brn mot Gy Notes: KDHE Project! Ub-005-15000	
27.5 35 Clay, sl. silty, Brown to Gray Brn mot Gy Notes: Chapter Contractor's Or Landowner's Certification: This water well was constructed, preconstructed, or []	plugged
27.5 35 Clay, sl. silty, Brown to Gray Brn mot Gy Notes: Chapter Chapte] plugged nd belief.
27.5 35 Clay, sl. silty, Brown to Gray Brn mot Gy Notes: Contractor's Or Landowner's Certification: This water well was constructed, or cunder my jurisdiction and was completed on (mo-day-year) .1/30/2020 and this record is true to the best of my knowledge at Kansas Water Well Contractor's License No. 527 This Water Well Record was completed on (mo-day-year) .3/3/2020.] plugged nd belief.
27.5 35 Clay, sl. silty, Brown to Gray Brn mot Gy Notes: Contractor's Or Landowner's Certification: This water well was constructed, or cunder my jurisdiction and was completed on (mo-day-year) .1/30/2020 and this record is true to the best of my knowledge at Kansas Water Well Contractor's License No. 527 This Water Well Record was completed on (mo-day-year) .3/3/2020. under the business name of GeoCore. LLC] plugged nd belief.
27.5 35 Clay, sl. silty, Brown to Gray Brn mot Gy Notes: Contractor's Or Landowner's Certification: This water well was constructed, or cunder my jurisdiction and was completed on (mo-day-year) .1/30/2020 and this record is true to the best of my knowledge at Kansas Water Well Contractor's License No. 527 This Water Well Record was completed on (mo-day-year) .3/3/2020.	plugged nd belief.

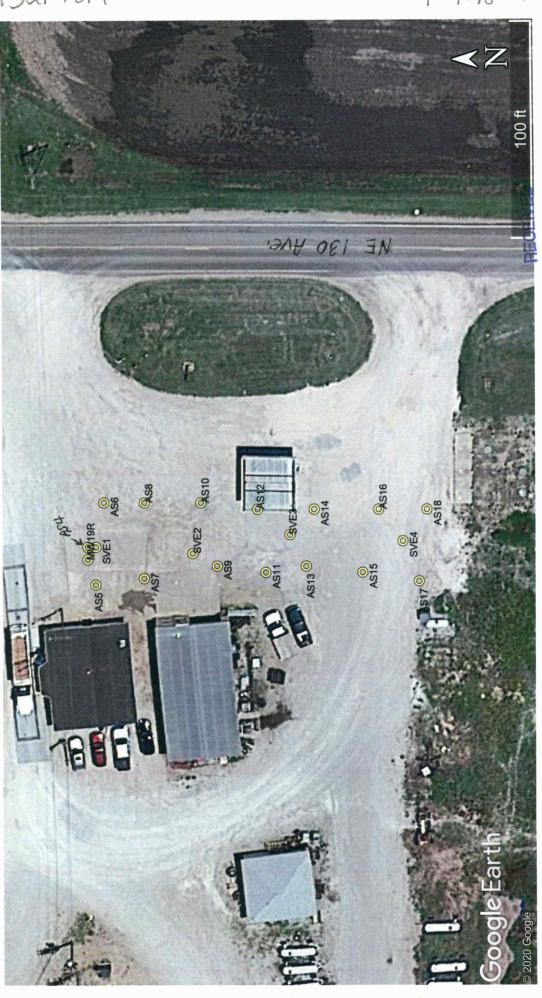

BUREAU OF WATER

MW19R: 38.52148, -98.53622 SVE1: 38.52147, -98.53620 SVE2: 38.52135, -98.53621 38.52123, -98.53618 SVE3: 38.52120, -98.53614 38.52112, -98.53614 38.52107, -98.53624 38.52114, -98.53624

38.52109, -98.53619

SVE4:

38.52106, -98.53614

38.52134, -98.53613 38.52126, -98.53624 38.52127, -98.53614 38.52132, -98.53623 AS10: AS11: AS12: AS9:

AS14: AS15: AS16: AS17: AS18:

38.52121, -98.53623 AS13:

> 38.52146, -98.53613 38.52141, -98.53613 38.52141, -98.53625 AS6: AS7: AS8:

38.52147, -98.53626 AS5:

KDHE Project Code: U6-005-15000

Central Prairie Coop, Claflin

Project Site:

38.52148, -98.53620

AS4:

GPS Coordinates: