
WATER WELL		WWC-5		ision of Water		*** 11 ***	AS13	
Original Record		ge in Well Use		ources App. No		Well ID	N	
1 LOCATION OF WATER WELL: County: Barton		Fraction NE 1/4 NE 1/4 NE 1/4			Township Numb		ge Number □ E ■ W	
2 WELL OWNER: Last Name: First: Street or Rural Address where well is located (if unknown, distance and								
Business: Central			lirection from nearest town or intersection): If at owner's address, check here:					
Address: PO Box 159							_	
Address: 1097 NE 130 Avenue, Claflin City: Sterling State: KS ZIP: 67579								
City: Sterling	State: KS							
3 LOCATE WELL 4 DEPTH OF COMPLETED WELL:35 ft. 5 Latitude:38.52121(decimal degree								
WITH "X" IN SECTION BOX:	Depth(s) Groundwater	Encountered: 1)27	′.5 ft.	ft. Longitude -98.53623 (decimal degrees)				
$N = \{2\} \dots \text{ft.} 3\} \dots \text{ft.} \text{ ft.}, \text{ or } 4\} \bot$				Dry Well Horizontal Datum: WGS 84 NAD 83 NAD 27				
WELL'S STATIC WATER LEVEL:								
below land surface, measured on (mo-day-				• • • • • • • • • • • • • • • • • • • •				
above land surface, measured on (mo-day-				(,,,,,,,,,,,,,,,,,,,,,,,,,,,,,,,,,,,,,,				
Pump test data: Well water was								
Well water was fi				Online Mapper:				
after hours pumping					4000.70			
Estimated Yield:gpm				6 Elevation: 1803.76 ft. I Ground Level TOC				
S Bore Hole Diameter:8 in. to35			ft. and	Source: Land Survey GPS Topographic Map				
1 mile in. to ft. Other								
7 WELL WATER TO BE USED AS:								
1. Domestic:		ater Supply: well ID			Field Water Supply: le			
Household					ole: well ID			
Lawn & Garden		Cased Uncased Geotechnical						
2. Irrigation					12. Geothermal: how many bores?			
3. ☐ Feedlot ☐ Air Sparge ☐ Soil Vapor Extract				a) Closed Loop ☐ Horizontal ☐ Vertical b) Open Loop ☐ Surface Discharge ☐ Inj. of Water				
4. Industrial	☐ Recovery		ZXII action					
Was a chemical/bacteriological sample submitted to KDHE? ☐ Yes ■ No If yes, date sample was submitted:								
8 TYPE OF CASING USED: ☐ Steel ☐ PVC ☐ Other								
Casing height above land surface9 in. Weightlbs./ft. Wall thickness or gauge No. Sch. 40								
TYPE OF SCREEN OR PERFORATION MATERIAL:								
☐ Steel ☐ Stainless Steel ☐ Fiberglass ■ PVC ☐ Other (Specify)								
☐ Brass ☐ Galvanized Steel ☐ Concrete tile ☐ None used (open hole)								
SCREEN OR PERFORATION OPENINGS ARE:								
☐ Continuous Slot ■ Mill Slot ☐ Gauze Wrapped ☐ Torch Cut ☐ Drilled Holes ☐ Other (Specify)								
□ Louvered Shutter □ Key Punched □ Wire Wrapped □ Saw Cut □ None (Open Hole)								
SCREEN-PERFORATED INTERVALS: From .32.5 ft. to .35 ft., From ft. to ft., From ft. to ft.								
GRAVEL PACK INTERVALS: From30 ft. to35 ft., From ft. to ft., From ft.								
9 GROUT MATERIAL: Neat cement								
Grout Intervals: From 4 ft. to 30 ft., From ft. to ft., From ft. to ft.								
Nearest source of possible contamination:								
☐ Septic Tank ☐ Lateral Lines ☐ Pit Privy ☐ Livestock Pens ☐ Insecticide Storage ☐ Sewer Lines ☐ Cess Pool ☐ Sewage Lagoon ☐ Fuel Storage ☐ Abandoned Water Well								
☐ Watertight Sewer Lines ☐ Seepage Pit ☐ Feedyard ☐ Fertilizer Storage ☐ Oil Well/Gas Well								
☐ Other (Specify)								
Direction from well?	***************************************	Distance from we	<u>:11?</u>					
10 FROM TO	LITHOLO	GIC LOG	FROM		ITHO. LOG (cont.) or		SINTERVALS	
0 5	Hydroexcavated - No	Sample						
5 7	Clay, sl. silty, Brown							
7 13	Clay, silty, Lt. Brown							
13 17	Silt, sl. clayey, Lt. Bro							
17 22	Clay, silty, Lt. Red Br				····			
22 25	Clay, silty, Lt. Gray B		Notes:					
25 27.5								
27.5 32 Clay, sl. silty, Gray Brown KDHE Project: U6-005-15000						\n\		
11 CONTRACTOR'S OR LANDOWNER'S CERTIFICATION: This water well was constructed, reconstructed, or plugged								
under my jurisdiction and was completed on (mo-day-year) .1/31/2020 and this record is true to the best of my knowledge and belief.								
Kansas Water Well Contractor's License No. 527 This Water Well Record was completed on (mo day-year) 3/3/2020 under the business name of GeoCore, LLC								
Mail 1 white copy along with a fee of \$5.00 for each constructed well to: Kansas Department of Health and Environment, Bureau of Water, GWTS Section,								
1000 SW Jackson St., Suite 420, Topeka, Kansas 66612-1367. Mail one to Water Well Owner and retain one for your records. Telephone 785-296-5524.								
Visit us at http://www.kdheks.gov/waterwell/index.html KSA 82a-1212 Revised 7/10/2015								

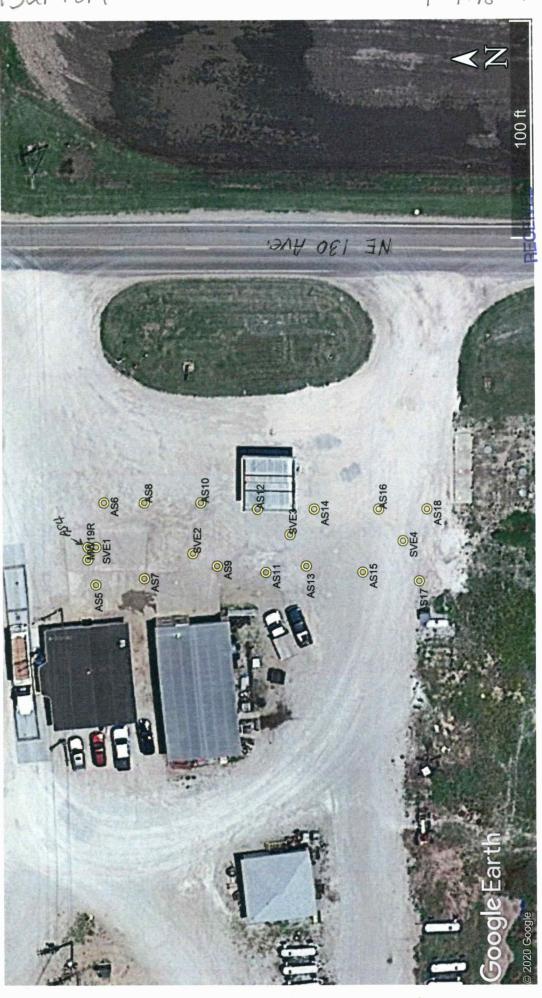

BUREAU OF WATER

MW19R: 38.52148, -98.53622 SVE1: 38.52147, -98.53620 SVE2: 38.52135, -98.53621 38.52123, -98.53618 SVE3: 38.52120, -98.53614 38.52112, -98.53614 38.52107, -98.53624 38.52114, -98.53624

38.52109, -98.53619

SVE4:

38.52106, -98.53614

38.52134, -98.53613 38.52126, -98.53624 38.52127, -98.53614 38.52132, -98.53623 AS10: AS11: AS12: AS9:

AS14: AS15: AS16: AS17: AS18:

38.52121, -98.53623 AS13:

> 38.52146, -98.53613 38.52141, -98.53613 38.52141, -98.53625 AS6: AS7: AS8:

38.52147, -98.53626 AS5:

KDHE Project Code: U6-005-15000

Central Prairie Coop, Claflin

Project Site:

38.52148, -98.53620

AS4:

GPS Coordinates: