
WATER WELL				ision of Water		Well ID AS12	
Original Record		Well Use		ources App. No.			
1 LOCATION OF W	I	raction	1	tion Number 4	Township Number T 18 S	Range Number R 11 □ E ■ W	
County: Barton		IE 14 NE 14 NE 14		·			
2 WELL OWNER: Last Name: First: Street or Rural Address where well is located (if unknown, distance and							
				irection from nearest town or intersection): If at owner's address, check here:			
Address: PO Box 159 Address: 1097 NE 130 Avenue, Claflin							
City: Sterling	State: KS	ZIP: 67579					
3 LOCATE WELL					00.50407		
WITH "X" IN	4 DEPTH OF COMP						
SECTION BOX:	Depth(s) Groundwater Encountered: 1)27.5			Longitude: -98.53614 (decimal degrees)			
N (2) ft. 3) ft., or 4) \square				Source for Latitude/Longitude: GPS (unit make/model: Spectra Precision Epo.)			
WELL'S STATIC WATER LEVEL:							
NW NE	above land surface, measured on (mo-day-y Pump test data: Well water was			☐ Land Survey ☐ Topographic Map			
WE	E after hours pumpinggg Well water was			Online Mapper:			
SW SE	after hours pumpinggp				4000.00		
	Estimated Yield:			6 Elevation: 1803.60ft. Ground Level TOC			
S				Source: Land Survey GPS Topographic Map			
mile] Other						
1. Domestic:		Supply: well ID		10. □ Oil F	ield Water Supply: lease	e	
☐ Household	6. ☐ Dewatering:			11. Test Hole: well ID			
☐ Lawn & Garden	t Garden 7. ☐ Aquifer Recharge: well ID			☐ Cased ☐ Uncased ☐ Geotechnical			
☐ Livestock	8. Monitoring: well ID			12. Geothermal: how many bores?			
2. Irrigation	9. Environmental Remediation: well ID			a) Closed Loop			
3. ☐ Feedlot ☐ Air Sparge ☐ Soil Vapor Ex							
4. Industrial Recovery Injection 13. Other (specify):							
Was a chemical/bacteriological sample submitted to KDHE? ☐ Yes ■ No If yes, date sample was submitted:							
Water well disinfected? Yes No							
8 TYPE OF CASING USED: ☐ Steel ☐ PVC ☐ Other							
Casing diameter							
Casing height above land surface							
TYPE OF SCREEN OR PERFORATION MATERIAL:							
☐ Steel ☐ Stainless Steel ☐ Fiberglass ■ PVC ☐ Other (Specify)							
☐ Brass ☐ Galvanized Steel ☐ Concrete tile ☐ None used (open hole)							
SCREEN OR PERFORATION OPENINGS ARE:							
☐ Continuous Slot ☐ Mill Slot ☐ Gauze Wrapped ☐ Torch Cut ☐ Drilled Holes ☐ Other (Specify)							
☐ Louvered Shutter ☐ Key Punched ☐ Wire Wrapped ☐ Saw Cut ☐ None (Open Hole)							
SCREEN-PERFORATED INTERVALS: From							
GRAVEL PACK INTERVALS: From30 ft. to35 ft., From							
9 GROUT MATERIAL: ☐ Neat cement ☐ Cement grout ■ Bentonite ☐ Other							
Grout Intervals: From							
Nearest source of possible contamination:							
☐ Septic Tank ☐ Lateral Lines ☐ Pit Privy ☐ Livestock Pens ☐ Insecticide Storage							
☐ Sewer Lines ☐ Cess Pool ☐ Sewage Lagoon ☐ Fuel Storage ☐ Abandoned Water Well							
☐ Watertight Sewer Lines ☐ Seepage Pit ☐ Feedyard ☐ Fertilizer Storage ☐ Oil Well/Gas Well							
☐ Other (Specify) Direction from well?							
10 FROM TO	LITHOLOGIC		FROM	TO LI	THO. LOG (cont.) or PI	LUGGING INTERVALS	
	Hydroexcavated - No Sa	mple	ļ				
	Clay, silty, Brown		ļl				
	<u>Clay, silty, Lt. Brown to Y</u>		<u> </u>				
	Silt, sl. clayey, Lt. Red Brown						
	lay, silty, Lt. Red Brown						
	Clay, silty, Brown						
	Clay, silty, Brown mottled	Notes:	•				
						5 5 4 S	
27.5 31 Clay, silty, Brown to Gray Brown 31 35 Clay, Brown to Gray Brown RDHE Project: U6-005-15000							
11 CONTRACTOR'S OR LANDOWNER'S CERTIFICATION: This water well was constructed, reconstructed, or plugged							
under my jurisdiction and was completed on (mo-day-year) .1/31/2020 and this record is true to the best of my knowledge and belief.							
Kansas Water Well Contractor's License No. 527 This Water Well Record was completed on (mo-day-year) 3/3/2020							
under the business nam	e of GeoCore_LLC		Siş	gnature	Jale Vill		
Mail 1 white copy along with a fee of \$5.00 for each constructed well to: Kansas Department of Health and Environment, Bureau of Water, GWTS Section,							
1000 SW Jackson St., Suite 420, Topeka, Kansas 66612-1367. Mail one to Water Well Owner and retain one for your records. Telephone 785-296-5524.							
Visit us at http://www.kdhek	s.gov/waterwell/index.html		KSA 82a-12	12		Revised 7/10/2015	

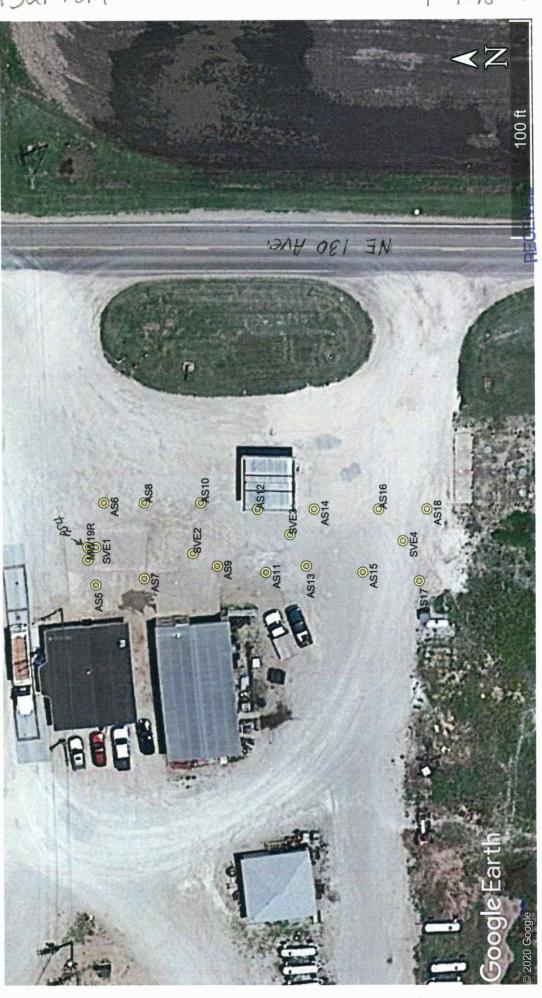

BUREAU OF WATER

MW19R: 38.52148, -98.53622 SVE1: 38.52147, -98.53620 SVE2: 38.52135, -98.53621 38.52123, -98.53618 SVE3: 38.52120, -98.53614 38.52112, -98.53614 38.52107, -98.53624 38.52114, -98.53624

38.52109, -98.53619

SVE4:

38.52106, -98.53614

38.52134, -98.53613 38.52126, -98.53624 38.52127, -98.53614 38.52132, -98.53623 AS10: AS11: AS12: AS9:

AS14: AS15: AS16: AS17: AS18:

38.52121, -98.53623 AS13:

> 38.52146, -98.53613 38.52141, -98.53613 38.52141, -98.53625 AS6: AS7: AS8:

38.52147, -98.53626 AS5:

KDHE Project Code: U6-005-15000

Central Prairie Coop, Claflin

Project Site:

38.52148, -98.53620

AS4:

GPS Coordinates: