
WATER WELL F		WWC-5		ision of Water			AS10		
Original Record		ge in Well Use		urces App. No.		Well ID			
1 LOCATION OF WATER WELL:		Fraction	Section Number Township N				ge Number		
County: Barton		NE ¼	4	T 18 S		E W			
2 WELL OWNER: Last Name: First: Street or Rural Address where well is located (if unknown, distance and									
Business: Central Prairie Coop			direction from nearest town or intersection): If at owner's address, check here:						
Address: PO Box 159 Address: 1097 NE 130 Avenue, Claflin									
City: Sterling	State: KS	1007 112 10	507 HZ 7507 H5H3, 5H3HH						
3 LOCATE WELL		ZIP: 67579							
WITH "X" IN	4 DEPTH OF COM	MPLETED WELL: .	35 ft						
•	SECTION ROX. Depth(s) Groundwater Encountered: 1)41.5								
N 2) ft. 3) ft., or 4) \square									
WELL'S STATIC WATER LEVEL:									
below land surface, measured on (mo-day-y									
above land surface, measured on (mo-day-y				(
Pump test data: Well water was									
W E		☐ Online Mapper:							
SW SE	SW SE Well water was ft. after hours pumping gr								
		6 Elevation: 1804.32ft. Ground Level TOC							
S Estimated Yield:gpm Bore Hole Diameter:8in. to							pographic Map		
1 mile Other									
7 WELL WATER TO BE USED AS:									
1. Domestic:		ater Supply: well ID		10. 🗀 Oil Fi	eld Water Supply: le	ase			
☐ Household	lousehold 6. Dewatering: how many wells?				11. Test Hole: well ID				
☐ Lawn & Garden		□ Cased	☐ Uncased ☐ C	Geotechnical	l				
☐ Livestock	☐ Livestock 8. ☐ Monitoring: well ID				al: how many bores				
2. 🔲 Irrigation	A\$10	a) Closed Loop							
3. Feedlot Air Sparge Soil Vapor Ex				b) Open Loop Surface Discharge Inj. of Water					
4. Industrial	☐ Recovery	☐ Injection		13. 🔲 Other	(specify):				
Was a chemical/bacteriological sample submitted to KDHE? ☐ Yes ■ No If yes, date sample was submitted:									
Water well disinfected? ☐ Yes ■ No									
8 TYPE OF CASING USED: ☐ Steel ■ PVC ☐ Other									
Casing diameter									
Casing height above land surface									
TYPE OF SCREEN OR PERFORATION MATERIAL:									
☐ Steel ☐ Stainless Steel ☐ Fiberglass ■ PVC ☐ Other (Specify)									
☐ Brass ☐ Galvanized Steel ☐ Concrete tile ☐ None used (open hole)									
SCREEN OR PERFORATION OPENINGS ARE:									
☐ Continuous Slot ■ Mill Slot ☐ Gauze Wrapped ☐ Torch Cut ☐ Drilled Holes ☐ Other (Specify)									
☐ Louvered Shutter ☐ Key Punched ☐ Wire Wrapped ☐ Saw Cut ☐ None (Open Hole)									
SCREEN-PERFORATED INTERVALS: From .32.5 ft. to .35 ft., From ft. to ft., From ft. to ft.									
GRAVEL PACK INTERVALS: From 30 ft. to 35 ft., From ft. to ft., From ft. to ft.									
9 GROUT MATERIAL: Neat cement Cement grout Bentonite Other									
Grout Intervals: From 4 ft. to 30 ft., From ft. to ft., From ft. to ft.									
Nearest source of possib			_						
☐ Septic Tank ☐ Lateral Lines ☐ Pit Privy ☐ Livestock Pens ☐ Insecticide Storage									
Sewer Lines Cess Pool Sewage Lagoon Fuel Storage Abandoned Water Well									
☐ Watertight Sewer Lines ☐ Seepage Pit ☐ Feedyard ☐ Fertilizer Storage ☐ Oil Well/Gas Well ☐ Other (Specify)									
Direction from well?									
10 FROM TO	LITHOLOG		FROM		HO. LOG (cont.) or	PLUGGING	INTERVALS		
	Hydroexcavated - No	··	I ROW	10 111	1.5. 255 (cont.) of	LLOGOIIN	S ALTALIK TALIS		
	Clay, silty, Dark Browi		+						
	Clay, silty, Brown to L		+						
		+			··· ·· · · · · · · · · · · · · · · · ·				
	Silt, sl. clayey, Lt. Brown	Clay, silty, Lt. Brown to Yellow Brown							
		1							
	Clay, silty, Lt. Gray Br								
	Clay, sl. silty, Gray Bro Clay, Gray Brown to E	Notes:							
31 35	1KNHE	= Project! U6-005-15000							
11 CONTRACTOR'S OR LANDOWNER'S CERTIFICATION: This water well was constructed, reconstructed, or plugged									
under my jurisdiction and was completed on (mo-day-year) .2/4/2020 and this record is true to the best of my knowledge and belief. Kansas Water Well Contractor's License No. 527 This Water Well Record was completed on mo-day-year) .3/3/2020									
under the business name of GeoCore, LLC. Signature Lole Lole Lole Lole LLC.									
Mail 1 white copy along with a fee of \$5.00 for each constructed well to: Kansas Department of Health and Environment, Bureau of Water, GWTS Section,									
1000 SW Jackson St., Suite 420, Topeka, Kansas 66612-1367. Mail one to Water Well Owner and retain one for your records. Telephone 785-296-5524.									
Visit us at http://www.kdheks.gov/waterwell/index.html KS					- ,		7/10/2015		

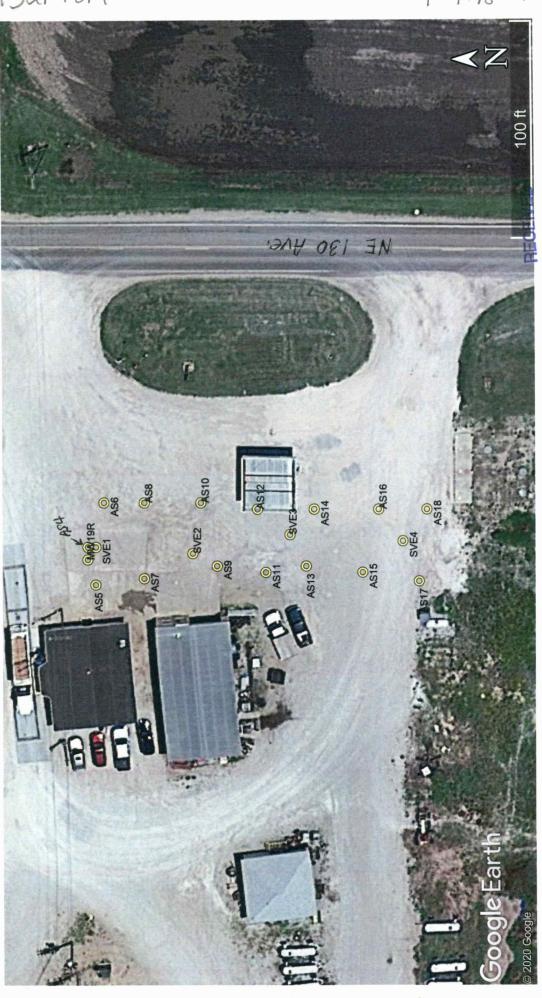

BUREAU OF WATER

MW19R: 38.52148, -98.53622 SVE1: 38.52147, -98.53620 SVE2: 38.52135, -98.53621 38.52123, -98.53618 SVE3: 38.52120, -98.53614 38.52112, -98.53614 38.52107, -98.53624 38.52114, -98.53624

38.52109, -98.53619

SVE4:

38.52106, -98.53614

38.52134, -98.53613 38.52126, -98.53624 38.52127, -98.53614 38.52132, -98.53623 AS10: AS11: AS12: AS9:

AS14: AS15: AS16: AS17: AS18:

38.52121, -98.53623 AS13:

> 38.52146, -98.53613 38.52141, -98.53613 38.52141, -98.53625 AS6: AS7: AS8:

38.52147, -98.53626 AS5:

KDHE Project Code: U6-005-15000

Central Prairie Coop, Claflin

Project Site:

38.52148, -98.53620

AS4:

GPS Coordinates: