
WATER WELL I		WWC-5		ision of Water			AS9	
Original Record		e in Well Use		ources App. No.		Well ID		
1 LOCATION OF WATER WELL:		Fraction		tion Number	Township Number		ge Number	
County: Barton NE ¼ NE								
2 WELL OWNER: Last Name: First: Street or Rural Address where well is located (if unknown, distance and direction from nearest town or intersection): If at owner's address, check here:								
Address: PO Box 159				,				
Address: 1097 NE 130 Avenue, Claffin								
City: Sterling	State: KS	ZIP: 67579						
3 LOCATE WELL 4 DEPTH OF COMPLETED WELL:35 ft. 5 Latitude:38.52132 (decimal d							(decimal degrees)	
Double (a) Convention to Convention of 1) 27				5ft. Longitude: -98.53623 (decimal degrees)				
SECTION BOX: Depth(s) Groundwater Encountered: 1)								
WELL'S STATIC WATER LEVEL:			ft. Source for Latitude/Longitude:					
below land surface, measured on (mo-day-y								
above land surface, measured on (mo-day-y				(
Pump test data: Well water was				☐ Land Survey ☐ Topographic Map				
W		m Online Mapper:						
Well water was ft. after hours pumping gg					4004.70			
	Estimated Yield:gpm			6 Elevation: 1804.76 ft. Ground Level TOC				
S	. ft. and	Source: Land Survey GPS Topographic Map						
1 mile in. to ft. Other								
7 WELL WATER TO BE USED AS: 1. Domestic: 5. Public Water Supply: well ID								
1. Domestic:		ter Supply: well ID						
Lawn & Garden	☐ Household 6. ☐ Dewatering: how many wells? ☐ Lawn & Garden 7. ☐ Aquifer Recharge: well ID							
Livestock								
2. Irrigation	AS9	a) Closed Loop Horizontal Vertical						
3. Feedlot Air Sparge Soil Vapor Ex				b) Open Loop Surface Discharge Inj. of Water				
4. Industrial	☐ Recovery	☐ Injection			(specify):			
Was a chemical/bacteriological sample submitted to KDHE? Yes No If yes, date sample was submitted:								
Water well disinfected? ☐ Yes ■ No								
8 TYPE OF CASING USED: ☐ Steel ■ PVC ☐ Other								
Casing diameter								
Casing height above land surface								
TYPE OF SCREEN OR PERFORATION MATERIAL:								
☐ Steel ☐ Stainless Steel ☐ Fiberglass ☐ PVC ☐ Other (Specify) ☐ Brass ☐ Galvanized Steel ☐ Concrete tile ☐ None used (open hole)								
SCREEN OR PERFORATION OPENINGS ARE:								
☐ Continuous Slot								
□ Louvered Shutter □ Key Punched □ Wire Wrapped □ Saw Cut □ None (Open Hole)								
SCREEN-PERFORATED INTERVALS: From .32.5 ft. to .35 ft., From ft. to ft., From ft. to ft.								
GRAVEL PACK INTERVALS: From30 ft. to35 ft., From ft. to ft., From ft. to ft.								
9 GROUT MATERIAL: Neat cement ☐ Cement grout ■ Bentonite ☐ Other								
Grout Intervals: From 4 ft. to 50 ft., From ft. to ft., From ft. to ft.								
Nearest source of possib		C Nun t	_					
☐ Septic Tank ☐ Lateral Lines ☐ Pit Privy ☐ Livestock Pens ☐ Insecticide Storage ☐ Sewer Lines ☐ Cess Pool ☐ Sewage Lagoon ☐ Fuel Storage ☐ Abandoned Water Well								
□ Sewer Lines □ Cess Pool □ Sewage Lagoon □ Fuel Storage □ Abandoned Water Well □ Watertight Sewer Lines □ Seepage Pit □ Feedyard □ Fertilizer Storage □ Oil Well/Gas Well								
Other (Specify)								
Direction from well?								
10 FROM TO	LITHOLOG	SIC LOG	FROM	TO LI	THO. LOG (cont.) or	PLUGGING	GINTERVALS	
0 5	Hydroexcavated - No							
5 8	Clay, silty, Dark Brown							
	Clay, silty, Brown to Lt							
	Clay, v. silty, Lt. Brown							
	Clay, silty, Lt. Brown to		1					
	Clay, sl. silty, Brown m	nottled Lt. Gray						
27 35	Clay, Brown		Notes:	_				
KDHE Project: Ub-005-15000								
11 CONTRACTOR'S OR LANDOWNER'S CERTIFICATION: This water well was constructed, preconstructed, or plugged								
under my jurisdiction and was completed on (mo-day-year) .2/4/2020 and this record is true to the best of my knowledge and belief.								
Kansas Water Well Contractor's License No. 527 This Water Well Record was completed on moday-year) 3/3/2020								
under the business nam	e of .GeoCoreLLC	• • • • • • • • • • • • • • • • • • • •	Sig	gnature	in wife			
Mail 1 white copy along with a fee of \$5.00 for each constructed well to: Kansas Department of Health and Environment, Bureau of Water, GWTS Section,								
1000 SW Jackson St., Suite 420, Topeka, Kansas 66612-1367. Mail one to Water Well Owner and retain one for your records. Telephone 785-296-5524.								
Visit us at http://www.kdhek	s.gov/waterwell/index.html		KSA 82a-12	12		Revised	7/10/2015	

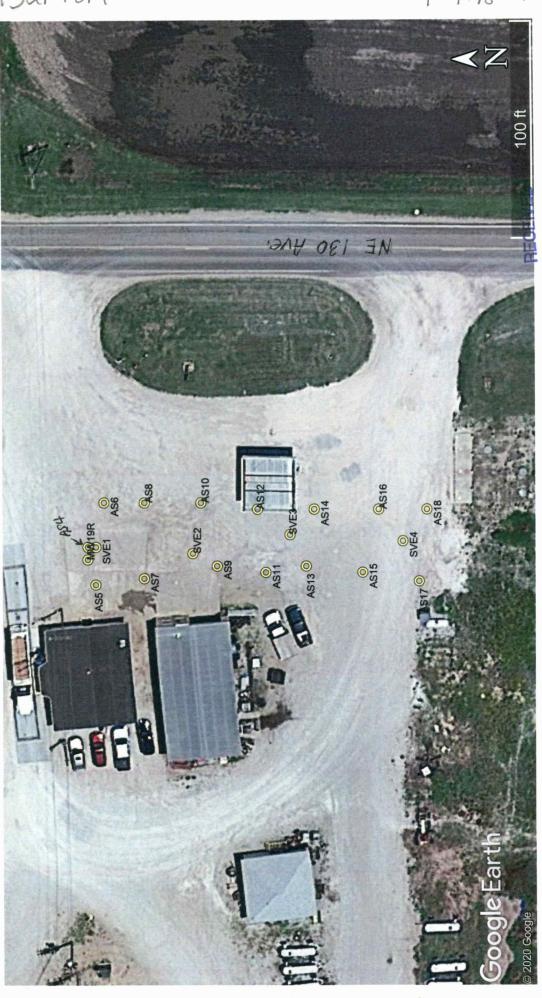

BUREAU OF WATER

MW19R: 38.52148, -98.53622 SVE1: 38.52147, -98.53620 SVE2: 38.52135, -98.53621 38.52123, -98.53618 SVE3: 38.52120, -98.53614 38.52112, -98.53614 38.52107, -98.53624 38.52114, -98.53624

38.52109, -98.53619

SVE4:

38.52106, -98.53614

38.52134, -98.53613 38.52126, -98.53624 38.52127, -98.53614 38.52132, -98.53623 AS10: AS11: AS12: AS9:

AS14: AS15: AS16: AS17: AS18:

38.52121, -98.53623 AS13:

> 38.52146, -98.53613 38.52141, -98.53613 38.52141, -98.53625 AS6: AS7: AS8:

38.52147, -98.53626 AS5:

KDHE Project Code: U6-005-15000

Central Prairie Coop, Claflin

Project Site:

38.52148, -98.53620

AS4:

GPS Coordinates: