
WATER WELL R		WWC-5		ision of Water			AS8	
Original Record		ge in Well Use		ources App. No.		Well ID		
1 LOCATION OF W	ATER WELL:	Fraction		tion Number	Township Number		ge Number	
County: Barton	NE 14 NE 14 NE 14							
2 WELL OWNER: Last Name: First: Street or Rural Address where well is located (if unknown, distance and								
Business: Central P	rairie Coop	direction from nearest town or intersection): If at owner's address, check here:						
Address: PO Box 159								
Address:		1097 NE 13	097 NE 130 Avenue, Claflin					
City: Sterling State: KS ZIP: 67579								
3 LOCATE WELL 4 DEPTH OF COMPLETED WELL:35 ft. 5 Latitude:38.52141								
WITH "X" IN SECTION BOX. Depth(s) Groundwater Encountered: 1)							(decimal degrees)	
SECTION BOX:				Dry Well Horizontal Datum: WGS 84 NAD 83 NAD 27				
WELL'S STATIC WATER LEVEL:								
below land surface, measured on (mo-day-yr				GPS (unit make/model: Spectra Precision Epo.)				
				(WAAS crabbed? [7 Ves No.)				
NW NE	Pump test data: Well water was ft.			(WAAS enabled? ☐ Yes ■ No) ☐ Land Survey ☐ Topographic Map				
w	after hour		Online Mapper:					
W			Offinite Wapper.					
SW SE	4	water was firs pumping f		4004.00				
1 1 1 1 1 1	Estimated Yield:	Phin	6 Elevation: 1804.88ft. Ground Level TOC					
S	Bore Hole Diameter:	ft and	Source: Land Survey GPS Topographic Map					
1 mile		ft.	Other					
7 WELL WATER TO BE USED AS:								
1. Domestic:		ater Supply: well ID		10 🗆 Oil Fi	eld Water Supply: le	ase		
☐ Household		ng: how many wells?						
Lawn & Garden	7. ☐ Aquifer R		11. Test Hole: well ID					
Livestock			12. Geothermal: how many bores?					
2. Irrigation	8. Monitoring: well ID							
3. Feedlot	Air Sparge Soil Vapor Extrac			b) Open Loop Surface Discharge Inj. of Water				
4. Industrial	☐ Recovery		Addenon					
Was a chemical/bacteriological sample submitted to KDHE?   Yes No If yes, date sample was submitted:								
Water well disinfected? ☐ Yes ■ No								
8 TYPE OF CASING USED: ☐ Steel ■ PVC ☐ Other								
Casing diameter								
Casing height above land surface								
TYPE OF SCREEN OR PERFORATION MATERIAL:								
☐ Steel ☐ Stainless Steel ☐ Fiberglass ■ PVC ☐ Other (Specify)								
☐ Brass ☐ Galvanized Steel ☐ Concrete tile ☐ None used (open hole)								
SCREEN OR PERFORATION OPENINGS ARE:								
☐ Continuous Slot ☐ Mill Slot ☐ Gauze Wrapped ☐ Torch Cut ☐ Drilled Holes ☐ Other (Specify)								
□ Louvered Shutter □ Key Punched □ Wire Wrapped □ Saw Cut □ None (Open Hole)								
SCREEN-PERFORATED INTERVALS: From								
GRAVEL PACK INTERVALS: From30 ft. to35 ft., From ft. to ft., From ft. ft.								
9 GROUT MATERIAL: Neat cement Cement grout Bentonite Other								
Grout Intervals: From								
Nearest source of possible contamination:								
Septic Tank Lateral Lines Pit Privy Livestock Pens Insecticide Storage								
☐ Sewer Lines ☐ Cess Pool ☐ Sewage Lagoon ☐ Fuel Storage ☐ Abandoned Water Well								
□ Watertight Sewer Lines □ Seepage Pit □ Feedyard □ Fertilizer Storage □ Oil Well/Gas Well								
Other (Specify)								
Direction from well?					ft.			
10 FROM TO	LITHOLO		FROM		THO. LOG (cont.) or	PLUGGIN	GINTERVALS	
	Hydroexcavated - No		<del> </del>					
	Clay, silty, Dark Brow							
	Clay, silty, Dark Brown Clay, silty, Brown	**	+					
			<del> </del>					
	Silt, clayey stringer, B		<del> </del>					
	Clay, silty, Lt. Brown t		<u> </u>					
	Clay, sl. silty, Brown s							
	<u>Clay, sl. silty, Brown r</u>	Notes:						
27.5 32 Clay, sl. silty, Lt. Gray Brown KNHE Quirest 111 ONE 15 DOLD								
35 Clay, Brown								
11 CONTRACTOR'S OR LANDOWNER'S CERTIFICATION: This water well was constructed. Treconstructed, or plugged								
under my jurisdiction and was completed on (mo-day-year) .2/3/2020 and this record is true to the best of my knowledge and belief.								
Kansas Water Well Contractor's License No. 527 This Water Well Record was completed on (morday-year) 3/3/2020								
under the business name	e of .GeoCore., LLC		Si	gnature	de sall			
Mail 1 white copy along with a fee of \$5.00 for each constructed well to: Kansas Department of Health and Environment, Bureau of Water, GWTS Section, 1000 SW Jackson St., Suite 420, Topeka, Kansas 66612-1367. Mail one to Water Well Owner and retain one for your records. Telephone 785-296-5524.								
1000 SW Jackson St	t., Suite 420, Topeka, Kansas				or your records. Telepho			
Visit us at http://www.kdheks.gov/waterwell/index.html KSA 82a-1212 Revised 7/10/2015								

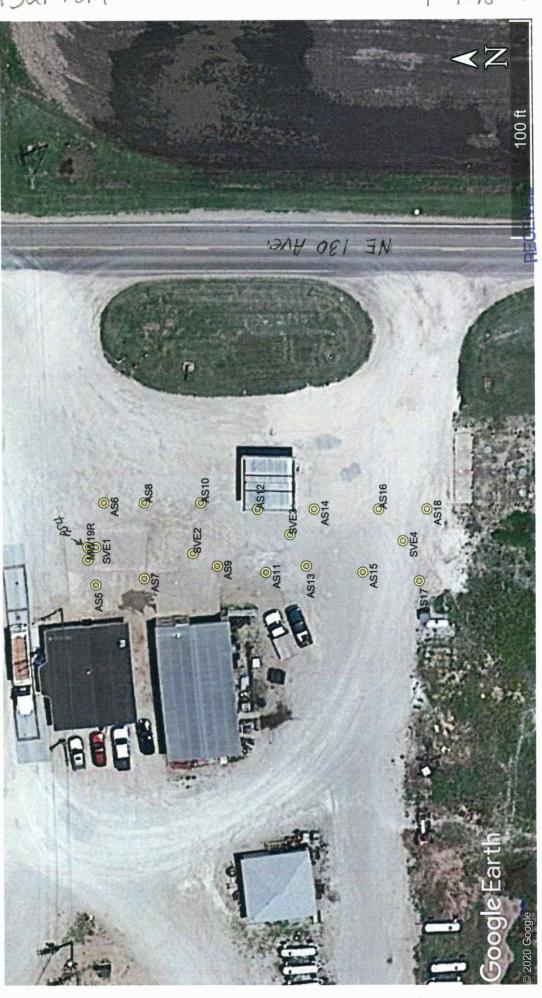

BUREAU OF WATER

MW19R: 38.52148, -98.53622 SVE1: 38.52147, -98.53620 SVE2: 38.52135, -98.53621 38.52123, -98.53618 SVE3: 38.52120, -98.53614 38.52112, -98.53614 38.52107, -98.53624 38.52114, -98.53624

38.52109, -98.53619

SVE4:

38.52106, -98.53614

38.52134, -98.53613 38.52126, -98.53624 38.52127, -98.53614 38.52132, -98.53623 AS10: AS11: AS12: AS9:

AS14: AS15: AS16: AS17: AS18:

38.52121, -98.53623 AS13:

> 38.52146, -98.53613 38.52141, -98.53613 38.52141, -98.53625 AS6: AS7: AS8:

38.52147, -98.53626 AS5:

KDHE Project Code: U6-005-15000

Central Prairie Coop, Claflin

Project Site:

38.52148, -98.53620

AS4:

GPS Coordinates: