
	WELL R		orm W				sion of Water			AS7		
	l Record			n Well Use			irces App. No.		Well ID			
		ATER WELL:	I -	raction		Secti	ion Number	Township Number		ge Number		
	: Barton			NE 4 NE 4 NE 1			4	T 18 S		I □E ■ W		
2 WELL	OWNER: L	ast Name:		First:	Street or Rural Address where well is located (if unknown, distance and							
Business: Central Prairie Coop Address: PO Box 159					direction from nearest town or intersection): If at owner's address, check here:					check here:		
Address	PO Box 1	9 <del>9</del>			1097 NE 130 Avenue, Claflin							
City:	Sterlina	Stat	e: KS	ZIP: 67579			,					
3 LOCAT					25			20 5214	1			
WITH "Y" IN 4 DEPTH OF COMPLETED WELL:87 T. 5 Latitude:									(decimal degrees)			
							Longitude:98.53625(decimal degrees) Horizontal Datum: □ WGS 84 ■ NAD 83 □ NAD 27					
N WELL'S STATIC WA				ft., or 4)		11				83 LI NAD 27		
WELL STATIC WA  □ below land surface							Source for Latitude/Longitude:  GPS (unit make/model:Spectra Precision Epo.)					
above land surface							Grs	(WAAS enabled? ☐ Yes ■ No)				
Pump test data: Well w							☐ Land Survey ☐ Topographic Map					
				umping			Online Mapper:					
Well w			Well wat	ater was ft.								
				pumping gpm			6 Floresti	6 Elevation: 1805.33 ft. Ground Level TOC				
Estimated Yield:			l:	gpm 8in. to35ft. and			Source: Land Survey GPS Topographic Map					
					T Other							
1 mile  in. to ft.   Other												
7 WELL WATER TO BE USED AS: 1. Domestic: 5. □ Public Water Supply: well ID												
1					g: how many wells?			10. ☐ Oil Field Water Supply: lease				
				echarge: well ID			☐ Cased ☐ Uncased ☐ Geotechnical					
				g: well ID			12. Geothermal: how many bores?					
_					Remediation: well ID AS7 a) Closed Loop ☐ Horizontal ☐ Vertica							
3. ☐ Feedlot ■ Air Sparge												
4. 🔲 Industr	rial		covery	☐ Injection				r (specify):				
Was a chemical/bacteriological sample submitted to KDHE?  Yes No If yes, date sample was submitted:												
Water well disinfected? \(\sigma\) Ves \(\sigma\) No												
8 TYPE OF CASING USED:   Steel PVC Other												
Casing diameter 2 in to 32.5 ft. Diameter in to ft. Diameter in to ft.												
Casing height above land surface												
TYPE OF SCREEN OR PERFORATION MATERIAL:												
☐ Steel ☐ Stainless Steel ☐ Fiberglass ■ PVC ☐ Other (Specify)												
☐ Brass ☐ Galvanized Steel ☐ Concrete tile ☐ None used (open hole)												
SCREEN OR PERFORATION OPENINGS ARE:												
☐ Continuous Slot ☐ Mill Slot ☐ Gauze Wrapped ☐ Torch Cut ☐ Drilled Holes ☐ Other (Specify)												
☐ Louvered Shutter ☐ Key Punched ☐ Wire Wrapped ☐ Saw Cut ☐ None (Open Hole)												
SCREEN-PERFORATED INTERVALS: From .32.5 ft. to .35 ft., From ft. to ft. ft. ft. ft. ft. ft. ft. ft.												
GRAVEL PACK INTERVALS: From												
9 GROUT MATERIAL: Neat cement Cement grout Bentonite Other												
Grout Intervals: From 4 ft. to 30 ft., From ft. to ft., From ft. to ft.												
Nearest source of possible contamination:   □ Septic Tank □ Lateral Lines □ Pit Privy □ Livestock Pens □ Insecticide Storage												
☐ Sewer		☐ Cess		☐ Sewage L	agoon	_	uel Storage	_	ned Water			
☐ Watertight Sewer Lines ☐ Seepage Pit ☐ Feedyard ☐ Fertilizer Storage ☐ Oil Well/Gas Well												
☐ Other (Specify)  Direction from well?  Distance from well?  ft.												
		· · · · · · · · · · · · · · · · · · ·										
10 FROM	TO		HOLOGI	C LOG	FROM	1	TO L	THO. LOG (cont.) or	PLUGGIN	G INTERVALS		
0		Concrete										
0.5		-lydroexcavated			<b></b>			·····				
5 9		Clay, silty, Dark		rown								
9		Clay, silty, Brow			$\bot$	$\perp$						
14		Clay, vl. silty w/s		rs, Brown								
17		Clay, silty, Brow										
25		Clay, sl. silty, Lt. Brown w/tr. Lt. Gray mot				:						
27										<b>)</b>		
32 35 Clay, Brown to Gray Brown  11 CONTRACTOR'S OR LANDOWNER'S CERTIFICATION: This water well was constructed, reconstructed, or plugged												
11 CONT	RACTOR'S	OR LANDOW	NER'S	CERTIFICATIO	N: This w	ater	well was 🔳	constructed, 🗌 reco	nstructed,	or 🔲 plugged		
under my j	urisdiction at	nd was completed	on (mo	-day-year) .2/6/20	ZU 8	ind th	his record is t	rue to the best of my	/ knowled	ge and belief.		
								leted on (mo day-ye				
Mail	L white conviole	one with a fee of \$5.0	0 for each o	onstructed well to: Ka	neas Denarti	nent o	of Health and En	vironment Bureau of Wa	ter GWTS	ection		
Mail 1 white copy along with a fee of \$5.00 for each constructed well to: Kansas Department of Health and Environment, Bureau of Water, GWTS Section, 1000 SW Jackson St., Suite 420, Topeka, Kansas 66612-1367. Mail one to Water Well Owner and retain one for your records. Telephone 785-296-5524.												
Visit us at http://www.kdheks.gov/waterwell/index.html  KSA 82a-1212  Revised 7/10/2015												

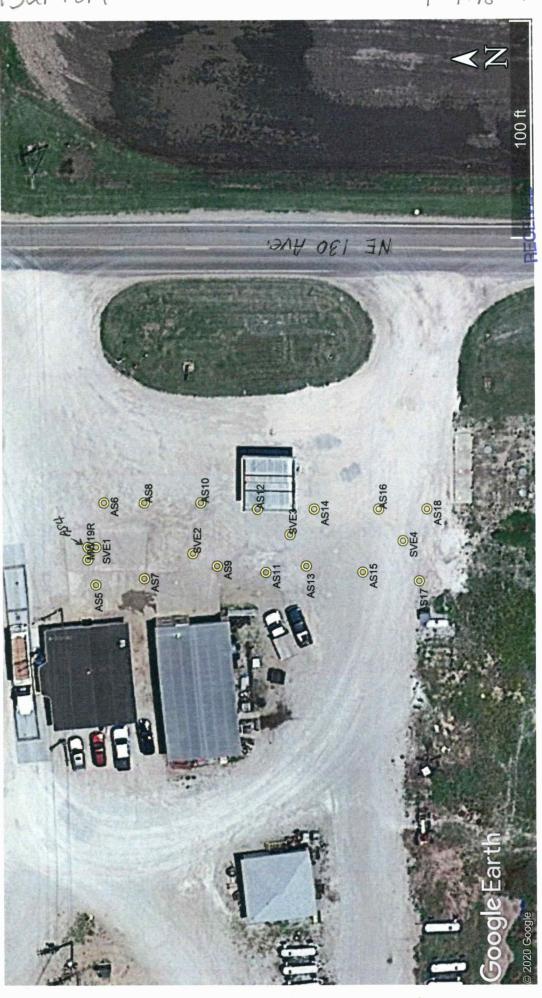

BUREAU OF WATER

MW19R: 38.52148, -98.53622 SVE1: 38.52147, -98.53620 SVE2: 38.52135, -98.53621 38.52123, -98.53618 SVE3: 38.52120, -98.53614 38.52112, -98.53614 38.52107, -98.53624 38.52114, -98.53624

38.52109, -98.53619

SVE4:

38.52106, -98.53614

38.52134, -98.53613 38.52126, -98.53624 38.52127, -98.53614 38.52132, -98.53623 AS10: AS11: AS12: AS9:

AS14: AS15: AS16: AS17: AS18:

38.52121, -98.53623 AS13:

> 38.52146, -98.53613 38.52141, -98.53613 38.52141, -98.53625 AS6: AS7: AS8:

38.52147, -98.53626 AS5:

KDHE Project Code: U6-005-15000

Central Prairie Coop, Claflin

Project Site:

38.52148, -98.53620

AS4:

GPS Coordinates: