
			WWC-5		ivision of Water	1		AS5	
			e in Well Use		sources App. No		Well ID		
1 LOCATION OF WATER WELL:			Fraction	_	ection Number	Township Numb		nge Number	
	y: Barton	. <u> </u>	NE 4 NE 4 NE 4	4 NE 1/4 4 T 18 S R 11 \square E \square W Street or Rural Address where well is located (if unknown, distance and					
	OWNER:								
		Prairie Coop		direction from nearest town or intersection): If at owner's address, check here:					
Address	PO Box	159		1097 NE 130 Avenue, Claflin					
City: Sterling State: KS ZIP: 67579									
2 LOCATE WELL						00.5044	-		
WITH "Y" IN 4 DEPIH OF COMPLETED WELL:					ft. 5 Latitud	le: 38.5214	<u> </u>	(decimal degrees)	
SECTION BOX. Depth(s) Groundwater E						Longitude: -98.53626 (decimal degrees)			
N 2) ft. 3			5) ft., or 4) [☐ Dry Well		Horizontal Datum: ☐ WGS 84 ■ NAD 83 ☐ NAD 27			
WELL'S STATIC WA □ below land surface					Source 1	Source for Latitude/Longitude:			
1 1 1					GPS	GPS (unit make/model: Spectra Precision Epo.)			
					1	(WAAS enabled? ☐ Yes ■ No)			
			pumping			☐ Land Survey ☐ Topographic Map ☐ Online Mapper:			
Well w				er was ft.			Annie Wapper		
I I CW I CE I I			pumping			1905 94			
		Estimated Yield:	Estimated Yield:gpm			6 Elevation: 1805.84ft. ■ Ground Level □ TOC			
1	S	Bore Hole Diameter:	re Hole Diameter:8 in. to35			and Source: Land Survey GPS Topographic Maj			
	mile		in. to	ft.		☐ Other	•••••		
7 WELL WATER TO BE USED AS:									
1. Domestic			ter Supply: well ID			Field Water Supply: le			
				any wells? 11. Test Hole: well ID					
			charge: well ID						
			g: well ID						
2. ☐ Irrigation 9. Environmental Re 3. ☐ Feedlot ■ Air Sparge					, <u> </u>				
4. Indust		Recovery	-	Extraction					
Was a chemical/bacteriological sample submitted to KDHE? Yes No If yes, date sample was submitted:									
Water well disinfected?									
8 TYPE OF CASING USED: ☐ Steel ☐ PVC ☐ Other									
Casing diameter									
Casing height above land surface									
☐ Steel ☐ Stainless Steel ☐ Fiberglass ■ PVC ☐ Other (Specify)									
SCREEN OR PERFORATION OPENINGS ARE:									
☐ Continuous Slot									
□ Louvered Shutter □ Key Punched □ Wire Wranned □ Saw Cut □ None (Open Hole)									
SCREEN-PERFORATED INTERVALS: From32.5 ft. to .35 ft., From ft. to ft. to ft.									
GRAVEL PACK INTERVALS: From 30 ft. to 35 ft., From ft. to ft., From ft. to ft.									
9 GROUT MATERIAL: Neat cement Cement grout Bentonite Other Grout Intervals: From ft. to ft., From ft. to ft.									
Nearest source of possible contamination:									
☐ Septic Tank ☐ Lateral Lines ☐ Pit Privy ☐ Livestock Pens ☐ Insecticide Storage									
☐ Sewer Lines ☐ Cess Pool ☐ Sewage Lagoon ☐ Fuel Storage ☐ Abandoned Water Well									
☐ Watertight Sewer Lines ☐ Seepage Pit ☐ Feedyard ☐ Fertilizer Storage ☐ Oil Well/Gas Well									
☐ Other (Specify) Direction from well? ft.									
								O. D. (2000)	
10 FROM	TO	LITHOLOG	ac Log	FROM	TO L	ITHO. LOG (cont.) or	PLUGGIN	GINTERVALS	
0		Concrete			 				
0.5	9	Clay, silty, Dark Gray	Brown						
9	14	Clay, silty, Brown		+	 				
14		Clay, v. silty, Brown		1	 				
18	24	Clay, silty, Lt. Brown, t							
24	27.5	Clay, Lt. Brown mottle	d Lt. Gray	1	1				
27.5	35	Clay, Brown		Notes:	0	.1			
KD+E Project: U6-005-15000									
11 CONTRACTOR'S OR LANDOWNER'S CERTIFICATION: This water well was constructed, reconstructed, or plugged									
under my jurisdiction and was completed on (mo-day-year) .2/6/2020 and this record is true to the best of my knowledge and belief.									
Kansas Water Well Contractor's License No. 527 This Water Well Record was completed on (morday-year) 3/3/2020 under the business name of GeoCore, LLC									
Mail	1 white convol	one with a fee of \$5.00 for end	constructed well to: Ver	sas Denortmo	nt of Health and En	vironment Rureau of We	ater GWTS	Section	
Mail 1 white copy along with a fee of \$5.00 for each constructed well to: Kansas Department of Health and Environment, Bureau of Water, GWTS Section, 1000 SW Jackson St., Suite 420, Topeka, Kansas 66612-1367. Mail one to Water Well Owner and retain one for your records. Telephone 785-296-5524.									
Visit us at http://www.kdheks.gov/waterwell/index.html KSA 82a-1212 Revised 7/10/2015									

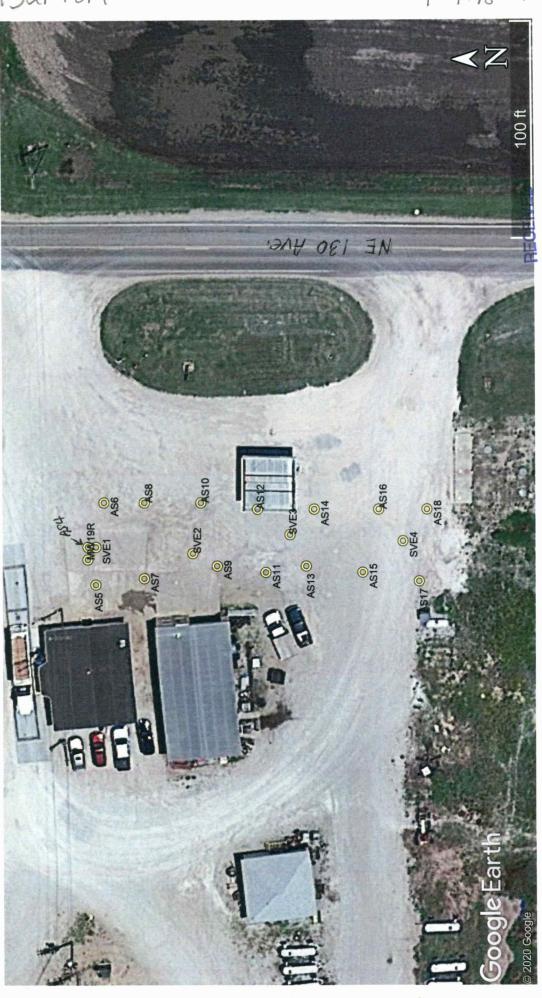

BUREAU OF WATER

MW19R: 38.52148, -98.53622 SVE1: 38.52147, -98.53620 SVE2: 38.52135, -98.53621 38.52123, -98.53618 SVE3: 38.52120, -98.53614 38.52112, -98.53614 38.52107, -98.53624 38.52114, -98.53624

38.52109, -98.53619

SVE4:

38.52106, -98.53614

38.52134, -98.53613 38.52126, -98.53624 38.52127, -98.53614 38.52132, -98.53623 AS10: AS11: AS12: AS9:

AS14: AS15: AS16: AS17: AS18:

38.52121, -98.53623 AS13:

> 38.52146, -98.53613 38.52141, -98.53613 38.52141, -98.53625 AS6: AS7: AS8:

38.52147, -98.53626 AS5:

KDHE Project Code: U6-005-15000

Central Prairie Coop, Claflin

Project Site:

38.52148, -98.53620

AS4:

GPS Coordinates: