
WATER WELL I		WWC-5		vision of Water	1		AS4		
Original Record		ge in Well Use		ources App. No		Well ID			
1 LOCATION OF WATER WELL:		Fraction		ction Number	Township Numb		ige Number		
County: Barton NE ¼ NE ¼ NE ¼ NE ¼ VE ¼ VE ¼ VE ¼ VE ¼									
2 WELL OWNER: Last Name: First: Street or Rural Address where well is located (if unknown, distance and direction from nearest town or intersection): If at owner's address, check here:									
Business: Central Prairie Coop Address: PO Box 159 direction from nearest town or intersection): If at owner's address, check here:									
Address: 1097 NE 130 Avenue, Claffin									
City: Sterling	State: KS	ZIP: 67579							
1	3 LOCATE WELL 4 DEPTH OF COMPLETED WELL:35 ft. 5 Latitude: 38.52148 (decimal degree								
WITH "X" IN	1111 A 111 Double's Commission Emporation of 1) 27.5 A T 1/2 T 00 52620								
SECTION BOX:	SECTION BOX: 2) ft. 3) ft., or 4)				Dry Well Horizontal Datum: □ WGS 84 ■ NAD 83 □ NAD 27				
	WELL'S STATIC WATER LEVEL:				or Latitude/Longitude	•			
below land surface, measured on (mo-day-yi									
NW NE	y r)	•	(
	Pump test data: Well		☐ Land Survey ☐ Topographic Map ☐ Online Mapper:						
W	after hours pumping gpr Well water was ft.				ine Mapper:		•••••		
SW SE		s pumping			4005.00				
	Estimated Yield:			6 Elevation: 1805.69ft. Ground Level TOC					
Bore Hole Diameter:			ft. and	Source: Land Survey GPS Topographic Map					
1 mile in. to									
7 WELL WATER TO BE USED AS:									
1. Domestic:		ater Supply: well ID			Field Water Supply: le				
☐ Household ☐ Lawn & Garden	6. ☐ Dewatering: how many wells? en 7. ☐ Aquifer Recharge: well ID			11. Test Hole: well ID					
Livestock				☐ Cased ☐ Uncased ☐ Geotechnical 12. Geothermal: how many bores?					
2. Irrigation	9. Environment		a) Closed Loop Horizontal Vertical						
3. Feedlot	extraction	b) Open Loop Surface Discharge Inj. of Water							
3. ☐ Feedlot ☐ Air Sparge ☐ Soil Vapor Extraction ☐ Sourface ☐ Industrial ☐ Recovery ☐ Injection ☐ 13. ☐ Other (specify):									
Was a chemical/bacteriological sample submitted to KDHE? Yes No If yes, date sample was submitted:									
Water well disinfected? ☐ Yes ■ No									
8 TYPE OF CASING USED: ☐ Steel ■ PVC ☐ Other									
8 TYPE OF CASING USED: ☐ Steel ☐ PVC ☐ Other									
Casing height above land surface									
TYPE OF SCREEN OR PERFORATION MATERIAL:									
☐ Steel ☐ Stainless Steel ☐ Fiberglass ☐ PVC ☐ Other (Specify)									
☐ Brass ☐ Galvanized Steel ☐ Concrete tile ☐ None used (open hole) SCREEN OR PERFORATION OPENINGS ARE:									
☐ Continuous Slot ☐ Mill Slot ☐ Gauze Wrapped ☐ Torch Cut ☐ Drilled Holes ☐ Other (Specify)									
□ Louvered Shutter □ Key Punched □ Wire Wrapped □ Saw Cut □ None (Open Hole)									
SCREEN-PERFORATED INTERVALS: From32.5 ft. to55 ft., From ft. to ft., From ft. to ft.									
GRAVEL PACK INTERVALS: From30 ft. to35 ft., From ft. to ft., From ft. ft.									
9 GROUT MATERIAL: Neat cement Cement grout Bentonite Other									
Grout Intervals: From									
Nearest source of possib									
☐ Septic Tank ☐ Lateral Lines ☐ Pit Privy ☐ Livestock Pens ☐ Insecticide Storage									
□ Sewer Lines □ Cess Pool □ Sewage Lagoon □ Fuel Storage □ Abandoned Water Well □ Watertight Sewer Lines □ Seepage Pit □ Feedyard □ Fertilizer Storage □ Oil Well/Gas Well									
Other (Specify)									
Direction from well? ft.									
10 FROM TO	LITHOLO		FROM		THO. LOG (cont.) or	PLUGGIN	G INTERVALS		
	Concrete								
	Hydroexcavated - No								
	Clay, silty, Dark Gray	Brown							
	Clay, silty, Brown								
14 17	Clay, v. silty, w/silt str								
	Clay, silty, Lt. Brown		<u> </u>						
	Clay, silty, Lt. Gray Brown Notes:			KDHE Pr	oject Ub-C	205-15	000 2		
27 35 Clay, Gray Brown									
11 CONTRACTORIS OR LANDOWNIPPIS CERTIFICATION OF THE STATE OF THE STAT									
11 CONTRACTOR'S OR LANDOWNER'S CERTIFICATION: This water well was constructed, reconstructed, or plugged									
under my jurisdiction and was completed on (mo-day-year) .2/7/2020 and this record is true to the best of my knowledge and belief. Kansas Water Well Contractor's License No. 527 This Water Well Record was completed on day-year) .3/3/2020									
under the business name of GeoCore, LLC. Signature									
Mail I white copy ale	ong with a fee of \$5.00 for each	ch constructed well to: Kans	sas Department	of Health and En	vironment, Bureau of Wa	iter, GWTS S	ection,		
1000 SW Jackson St., Suite 420, Topeka, Kansas 66612-1367. Mail one to Water Well Owner and retain one for your records. Telephone 785-296-5524.									
Visit us at http://www.kdheks.gov/waterwell/index.html KSA 82a-1212 Revised 7/10/2015									

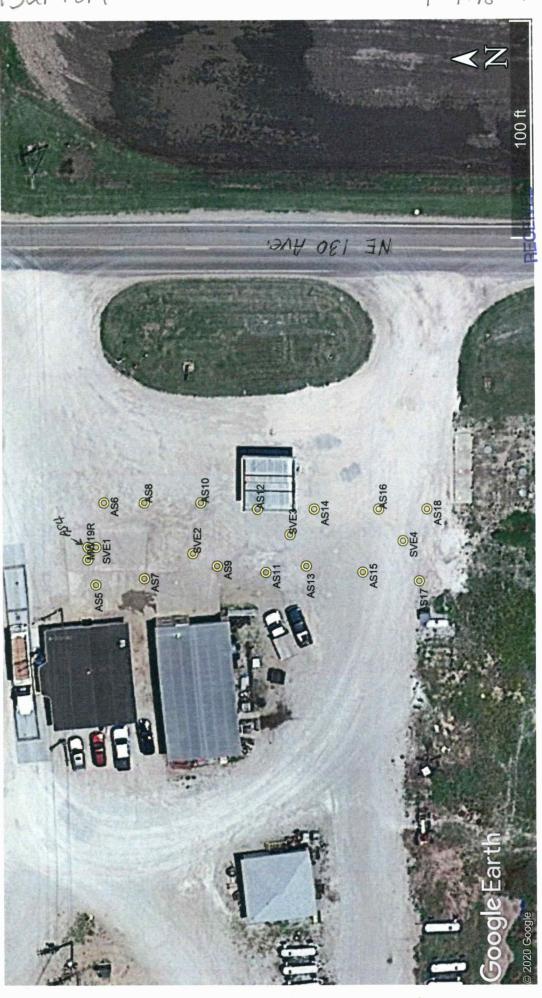

BUREAU OF WATER

MW19R: 38.52148, -98.53622 SVE1: 38.52147, -98.53620 SVE2: 38.52135, -98.53621 38.52123, -98.53618 SVE3: 38.52120, -98.53614 38.52112, -98.53614 38.52107, -98.53624 38.52114, -98.53624

38.52109, -98.53619

SVE4:

38.52106, -98.53614

38.52134, -98.53613 38.52126, -98.53624 38.52127, -98.53614 38.52132, -98.53623 AS10: AS11: AS12: AS9:

AS14: AS15: AS16: AS17: AS18:

38.52121, -98.53623 AS13:

> 38.52146, -98.53613 38.52141, -98.53613 38.52141, -98.53625 AS6: AS7: AS8:

38.52147, -98.53626 AS5:

KDHE Project Code: U6-005-15000

Central Prairie Coop, Claflin

Project Site:

38.52148, -98.53620

AS4:

GPS Coordinates: