
WATER WEL	L RECORD	Form WWC	C- 5	Div	ision of Water			SVE4	
Original Record	Correction [Change in We	ll Use	Res	ources App. No	_{).} L	Well ID		
1 LOCATION OF WATER WELL:		: Fracti	ion	Sec	ction Number	Township Numb		ige Number	
County: Barton			NE 1/4 NE 1/4						
2 WELL OWNE		First:		Street or Rural Address where well is located (if unknown, distance and					
Business: Centra				direction from nearest town or intersection): If at owner's address, check here:					
Address: PO Box 159 Address:					1097 NE 130 Avenue, Claflin				
City: Sterlin	o s	tate: KS ZIP:	67579	,					
3 LOCATE WELL				20.5046	·				
WITH "X" IN	4 DEPTH 0	OF COMPLET							
SECTION BOX:	tered: 1)								
N	2) ft. 3) ft., or 4) WELL'S STATIC WATER LEVEL:							83 LI NAD 27	
below land surface, measured on (mo									
NWNE	red on (mo-day-			(WAAS enabled?					
	Pump test dat	a: Well water wa	ater was ft.			☐ Land Survey ☐ Topographic Map			
w	E after		mping gpm						
SW SE	ıs f								
			imping gpm 6 Elevation			ion: 1803.35 ft	. Ground	l Level TOC	
Estimated Yield: Bore Hole Diameter:			gpm .11 in. to26 ft. and			Source: Land Survey GPS Topographic Map			
1 mile in. to ft.					Other				
7 WELL WATER TO BE USED AS:									
1. Domestic:	5. 🗀 I	Public Water Supp			10. 🔲 Oil	Field Water Supply: 1	ease		
☐ Household 6. ☐ Dewatering: how many wells				11. Test Hole: well ID			• • • • • • • • • • • • • • • • • • • •		
Lawn & Garden	Aquifer Recharge				☐ Cased ☐ Uncased ☐ Geotechnical				
Livestock 8. Monitoring: well ID									
2. ☐ Irrigation 9. Environmental Remediati 3. ☐ Feedlot ☐ Air Sparge ■ S									
4. ☐ Industrial ☐ Recovery									
Was a chemical/bacteriological sample submitted to KDHE? ☐ Yes ■ No If yes, date sample was submitted:									
8 TYPE OF CASING USED: ☐ Steel ■ PVC ☐ Other									
Casing diameter									
Casing height above land surface									
TYPE OF SCREEN OR PERFORATION MATERIAL:									
☐ Steel ☐ Stainless Steel ☐ Fiberglass ☐ PVC ☐ Other (Specify)									
☐ Brass ☐ Galvanized Steel ☐ Concrete tile ☐ None used (open hole)									
SCREEN OR PERFORATION OPENINGS ARE:									
☐ Continuous Slot									
Louvered Shutter									
SCREEN-PERFORATED INTERVALS: From16 ft. to26 ft., From ft. to ft.									
9 GROUT MATERIAL: Neat cement Cement grout Bentonite Other									
Grout Intervals: From									
Nearest source of pos	sible contamination	1:	JIII	11. 10	16., 1 10111		11.		
☐ Septic Tank ☐ Lateral Lines ☐ Pit Privy ☐ Livestock Pens ☐ Insecticide Storage									
☐ Sewer Lines ☐ Cess Pool ☐ Sewage Lagoon ☐ Fuel Storage ☐ Abandoned Water Well									
☐ Other (Specify)									
10 FROM TO	T T	THOLOGIC LO	G	FROM		π. LITHO. LOG (cont.) or		GINTERVALS	
0 5	Hydroexcavate			I KOW	10 1	ATTIO. LOG (COIR.) OF	LUUUIN	GINTERVALS	
5 6	Clay, silty, Da		<u> </u>						
6 13	Clay, silty, Lt.		w Brown	-					
13 17		ilt, sl. clayey, Lt. Red Brown							
17 22		Clay, silty, Lt. Red Brown				<u> </u>			
22 26	Clay, Lt. Red I			1					
		Notes:							
KDHE Project! U6-005-15000									
11 CONTRACTOR'S OR LANDOWNER'S CERTIFICATION: This water well was constructed, reconstructed, or plugged									
under my jurisdiction and was completed on (mo-day-year) .2/4/2020 and this record is true to the best of my knowledge and belief.									
Kansas Water Well Contractor's License No. 527 This Water Well Record was completed on (mo-day-year) 3/3/2020 under the business name of GeoCore, LLC									
Mail 1 white cor	v along with a fee of \$5	00 for each constru	cted well to: Kan	sas Denartment	of Health and E	nvironment Rureau of W	ater GWTS	Section	
Mail 1 white copy along with a fee of \$5.00 for each constructed well to: Kansas Department of Health and Environment, Bureau of Water, GWTS Section, 1000 SW Jackson St., Suite 420, Topeka, Kansas 66612-1367. Mail one to Water Well Owner and retain one for your records. Telephone 785-296-5524.									
Visit us at http://www.kc	•			KSA 82a-12		,		7/10/2015	

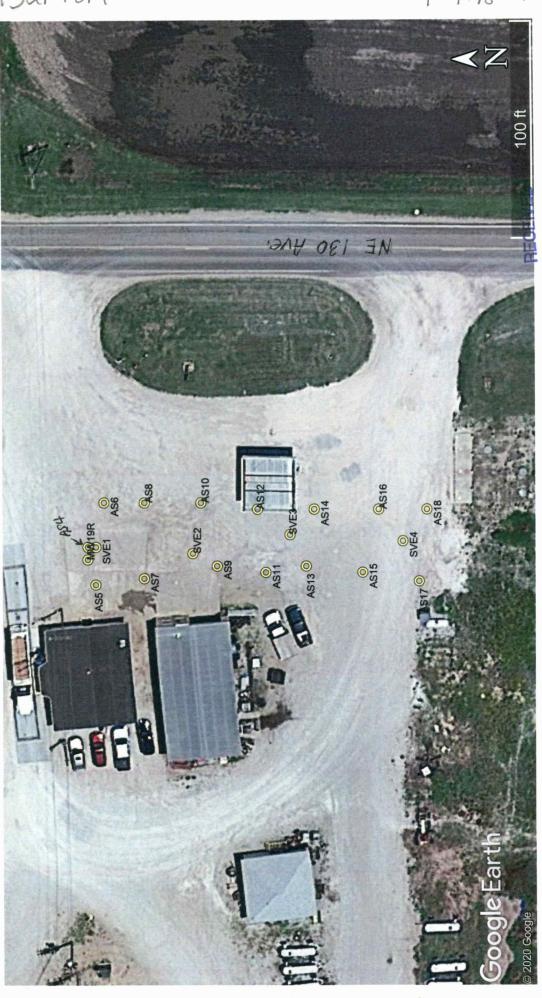

BUREAU OF WATER

MW19R: 38.52148, -98.53622 SVE1: 38.52147, -98.53620 SVE2: 38.52135, -98.53621 38.52123, -98.53618 SVE3: 38.52120, -98.53614 38.52112, -98.53614 38.52107, -98.53624 38.52114, -98.53624

38.52109, -98.53619

SVE4:

38.52106, -98.53614

38.52134, -98.53613 38.52126, -98.53624 38.52127, -98.53614 38.52132, -98.53623 AS10: AS11: AS12: AS9:

AS14: AS15: AS16: AS17: AS18:

38.52121, -98.53623 AS13:

> 38.52146, -98.53613 38.52141, -98.53613 38.52141, -98.53625 AS6: AS7: AS8:

38.52147, -98.53626 AS5:

KDHE Project Code: U6-005-15000

Central Prairie Coop, Claflin

Project Site:

38.52148, -98.53620

AS4:

GPS Coordinates: