
	WELL F			WWC-5	Division of Water					MW15	
		Correction		e in Well Use		sources App.		T 1: N 1	Well ID	Number	
		ATER WEL	L:	Fraction	Section Number 4			Township Number Range Number T 18 S R 13 □ E ■ W			
	: Barton			SW 1/4 NW 1/4 NW 1/4		reet or Rural Address where well is located (if unknown, distance and					
2 WELL OWNER: Last Name: First: Street or Rural Address where well is located (if unknown direction from nearest town or intersection): If at owner's address,										check here:	
Address:	164 Sout		п.	1	direction from nearest town of intersections. If at owner's address, one-						
Address:											
City:	Hoisingto	n	State: KS	ZIP: 67544							
3 LOCAT		A DEPTH	OF COM	PIETED WELL.	LETED WELL:19 ft. 5 Latitude:				7	(decimal degrees)	
WITH "				Encountered: 1)	Lan	Longitude: -98.77466 (decimal degrees)					
				3) ft., or 4) [Horis	Horizontal Datum: WGS 84 NAD 83 NAD 27					
P			WELL'S STATIC WATER LEVEL:				ce for	Latitude/Longitude:	•		
			below land surface, measured on (mo-day-yr)				GPS (unit make/model: Spectra Precision Epo.)				
				, measured on (mo-day-		(WAAS enabled? ☐ Yes ■ No)					
Pump test data: Well v						☐ Land Survey ☐ Topographic Map					
WX	E	arter		s pumpingvater was		Online Mapper:					
sw	SE	after									
Estimate			after hours pumpinggp nated Yield:gpm			6 Elevation: 1828.32ft. Ground Level TOC					
	S Bore Hole Diameter			8 in. to 19	ft. and	Sour	Source: Land Survey GPS Topographic Map				
├1 r	nile			in. to ft.				☐ Other			
7 WELL WATER TO BE USED AS:											
1. Domestic		5. 🗖	Public Wa	ter Supply: well ID		10. Oil Field Water Supply: lease					
☐ House		6. 🗖	Dewaterin	g: how many wells?		11. Test Hole: well ID					
☐ Lawn		7. 🔲	echarge: well ID g: well ID	C	☐ Cased ☐ Uncased ☐ Geotechnical						
Livesto					12. Geothermal: how many bores?						
2. Irrigati			al Remediation: well II		 a) Closed Loop ☐ Horizontal ☐ Vertical b) Open Loop ☐ Surface Discharge ☐ Inj. of Water 						
3. ☐ Feedlot ☐ Air Sparge 4. ☐ Industrial ☐ Recovery						13. Other (specify):					
Was a chemical/bacteriological sample submitted to KDHE? Yes No If yes, date sample was submitted:											
Water well disinfected? Yes No CASING HORES, The Charlest Threeded											
8 TYPE OF CASING USED: Steel PVC Other											
Casing diameter 2 in. to 9 ft., Diameter in. to ft., Diameter in. to ft. Casing height above land surface 6 in. Weight 1bs/ft. Wall thickness or gauge No. Sch. 40 in.											
TYPE OF SCREEN OR PERFORATION MATERIAL:											
☐ Steel ☐ Stainless Steel ☐ Fiberglass ■ PVC ☐ Other (Specify)											
☐ Brass ☐ Galvanized Steel ☐ Concrete tile ☐ None used (open hole)											
SCREEN OR PERFORATION OPENINGS ARE:											
☐ Continuous Slot ■ Mill Slot ☐ Gauze Wrapped ☐ Torch Cut ☐ Drilled Holes ☐ Other (Specify)											
☐ Louvered Shutter ☐ Key Punched ☐ Wire Wrapped ☐ Saw Cut ☐ None (Open Hole)											
SCREEN-PERFORATED INTERVALS: From .9 ft. to .19 ft., From ft. to ft., From ft. to ft.											
GRAVEL PACK INTERVALS: From											
9 GROUT MATERIAL: ☐ Neat cement ☐ Cement grout ☐ Bentonite ☐ Other Concrete Grout Intervals: From											
Grout Intervals: From											
Nearest source of possible contamination: □ Septic Tank □ Lateral Lines □ Pit Privy □ Livestock Pens □ Insecticide Storage											
☐ Septic		_	Laterai Line Cess Pool	es		☐ Livestock P			oned Water		
				☐ Sewage La					ll/Gas Well		
□ Watertight Sewer Lines □ Seepage Pit □ Feedyard □ Fertilizer Storage □ Oil Well/Gas Well □ Other (Specify) □ Other (Specify)											
				Distance from w				ft.			
10 FROM	TO		ITHOLO		FROM	ТО		THO. LOG (cont.) or		IG INTERVALS	
0	2	Clay, sl. silty									
2		Clay, silty, B									
13	19	Clay, Brown									
-											
					Notes:						
11 CONTRACTOR'S OR LANDOWNER'S CERTIFICATION: This water well was constructed, reconstructed, or plugged											
under my jurisdiction and was completed on (mo-day-year) .1/14/2019 and this record is true to the best of my knowledge and belief.											
Kansas Water Well Contractor's License No. 527 This Water Well Record was completed on (nor-day-year) .1/23/2019											
under the business name of GeoCore Inc. Signature Signature Mail I white copy along with a fee of \$5.00 for each constructed well to: Kansas Department of Health and Environment, Bureau of Water, GWTS Section,											
1000 SW Jackson St., Suite 420, Topeka, Kansas 66612-1367. Mail one to Water Well Owner and retain one for your records. Telephone 785-296-5524.											
Visit us at http://www.kdheks.gov/waterwell/index.html KSA 82a-1212 Revised 7/10/2015										d 7/10/2015	

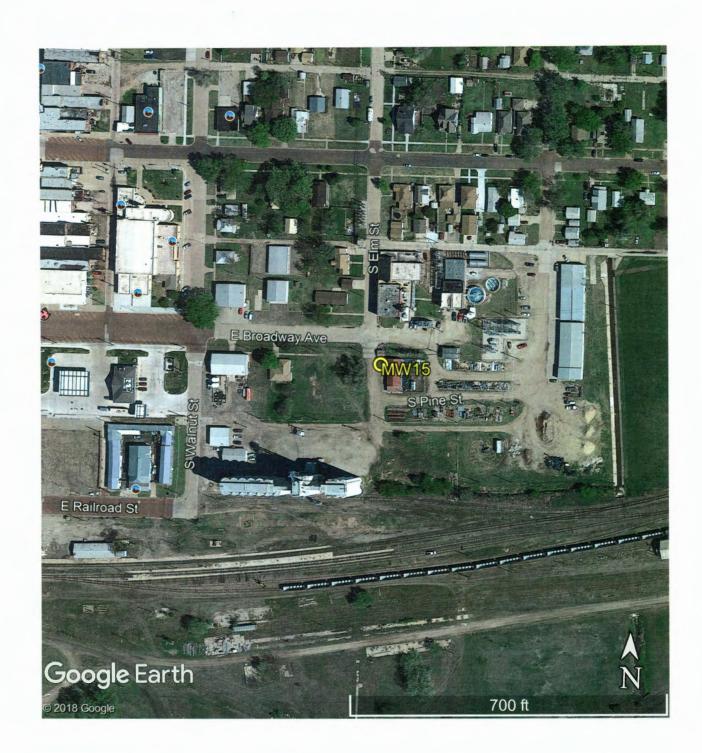

Hoisington Power Plant 164 South Elm, Hoisington KDHE #A6 005 40049

GPS Coordinates:

MW15: 38.51257, -98.77466

FEB 2 1 2019 BUREAU OF WATER