

WATER WELL RECORD Form WWC-5

Division of Water Resources App. No.

[]


MW-2

Well ID

Original Record Correction Change in Well Use

1 LOCATION OF WATER WELL: County: Ness Fraction NW 1/4 SW 1/4 NE 1/4 SW 1/4 Section Number 31 Township Number T 18 S Range Number R 21 E W

2 WELL OWNER: Last Name: Business: KDHE Address: 1000 SW Jackson St., Suite 410 City: Topeka State: KS ZIP: 66612 Street or Rural Address where well is located: 119 Lawrence Street

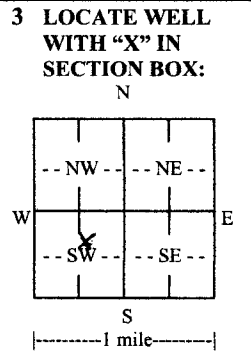

3 LOCATE WELL WITH 'X' IN SECTION BOX: 4 DEPTH OF COMPLETED WELL: 45.1 ft. Depth(s) Groundwater Encountered: 1) 25.5 ft. 2) ... ft. 3) ... ft., or 4) Dry Well

5 Latitude: 38.445866 (decimal degrees) Longitude: -99.690866 (decimal degrees) Horizontal Datum: WGS 84 NAD 83 NAD 27 Source for Latitude/Longitude: GPS (unit make/model: (WAAS enabled? Yes No) Land Survey Topographic Map Online Mapper: 6 Elevation: 2122.78 ft. Ground Level TOC Source: Land Survey GPS Topographic Map Other

7 WELL WATER TO BE USED AS: 1. Domestic: Household Lawn & Garden Livestock Irrigation Feedlot Industrial 2. Public Water Supply: well ID 3. Dewatering: how many wells? 4. Aquifer Recharge: well ID 5. Monitoring: well ID MW-2 6. Environmental Remediation: well ID 7. Air Sparge 8. Soil Vapor Extraction 9. Recovery 10. Injection 10. Oil Field Water Supply: lease 11. Test Hole: well ID Cased Uncased Geotechnical 12. Geothermal: how many bores? a) Closed Loop Horizontal Vertical b) Open Loop Surface Discharge Inj. of Water 13. Other (specify):

Was a chemical/bacteriological sample submitted to KDHE? Yes No If yes, date sample was submitted: Water well disinfected? Yes No

8 TYPE OF CASING USED: Steel PVC Other CASING JOINTS: Glued Clamped Welded Threaded Casing diameter 2 in. to 35.1 ft., Diameter in. to ft., Diameter in. to ft. Casing height above land surface 0 in. Weight lbs./ft. Wall thickness or gauge No. sch 40 TYPE OF SCREEN OR PERFORATION MATERIAL: Steel Stainless Steel Fiberglass PVC Brass Galvanized Steel Concrete tile None used (open hole) SCREEN OR PERFORATION OPENINGS ARE: Continuous Slot Mill Slot Gauze Wrapped Torch Cut Drilled Holes Other (Specify) Louvered Shutter Key Punched Wire Wrapped Saw Cut None (Open Hole) SCREEN-PERFORATED INTERVALS: From 35.1 ft. to 45.1 ft., From ft. to ft., From ft. to ft. GRAVEL PACK INTERVALS: From 33.1 ft. to 45.1 ft., From ft. to ft., From ft. to ft.


9 GROUT MATERIAL: Neat cement Cement grout Bentonite Other Grout Intervals: From ft. to ft., From ft. to ft., From ft. to ft. Nearest source of possible contamination: Septic Tank Lateral Lines Pit Privy Livestock Pens Insecticide Storage Sewer Lines Cess Pool Sewage Lagoon Fuel Storage Abandoned Water Well Watertight Sewer Lines Seepage Pit Feedyard Fertilizer Storage Oil Well/Gas Well Other (Specify) Direction from well? Distance from well? ft.

Table with columns: FROM, TO, LITHOLOGIC LOG, FROM, TO, LITHO. LOG (cont.) or PLUGGING INTERVALS. Rows: 0-5 Silt, brown, damp; 5-18.4 Clay, brown, stiff, damp, silty; 18.4-24.8 Clay, light brown, stiff, moist, sandy; 24.8-45.1 Sand, light brown, fine, wet.

11 CONTRACTOR'S OR LANDOWNER'S CERTIFICATION: This water well was constructed, reconstructed, or plugged under my jurisdiction and was completed on (mo-day-year) 1-21-2020 and this record is true to the best of my knowledge and belief. Kansas Water Well Contractor's License No. 604 This Water Well Record was completed on (mo-day-year) 2/24/20 under the business name of Environmental Priority Service, Inc. Signature [Signature]

Mail 1 white copy along with a fee of \$5.00 for each constructed well to: Kansas Department of Health and Environment, Bureau of Water, GWTS Section, 1000 SW Jackson St., Suite 420, Topeka, Kansas 66612-1367. Mail one to Water Well Owner and retain one for your records. Telephone 785-296-5524. Visit us at http://www.kdheks.gov/waterwell/index.html KSA 82a-1212 Revised 7/10/2015

Draft

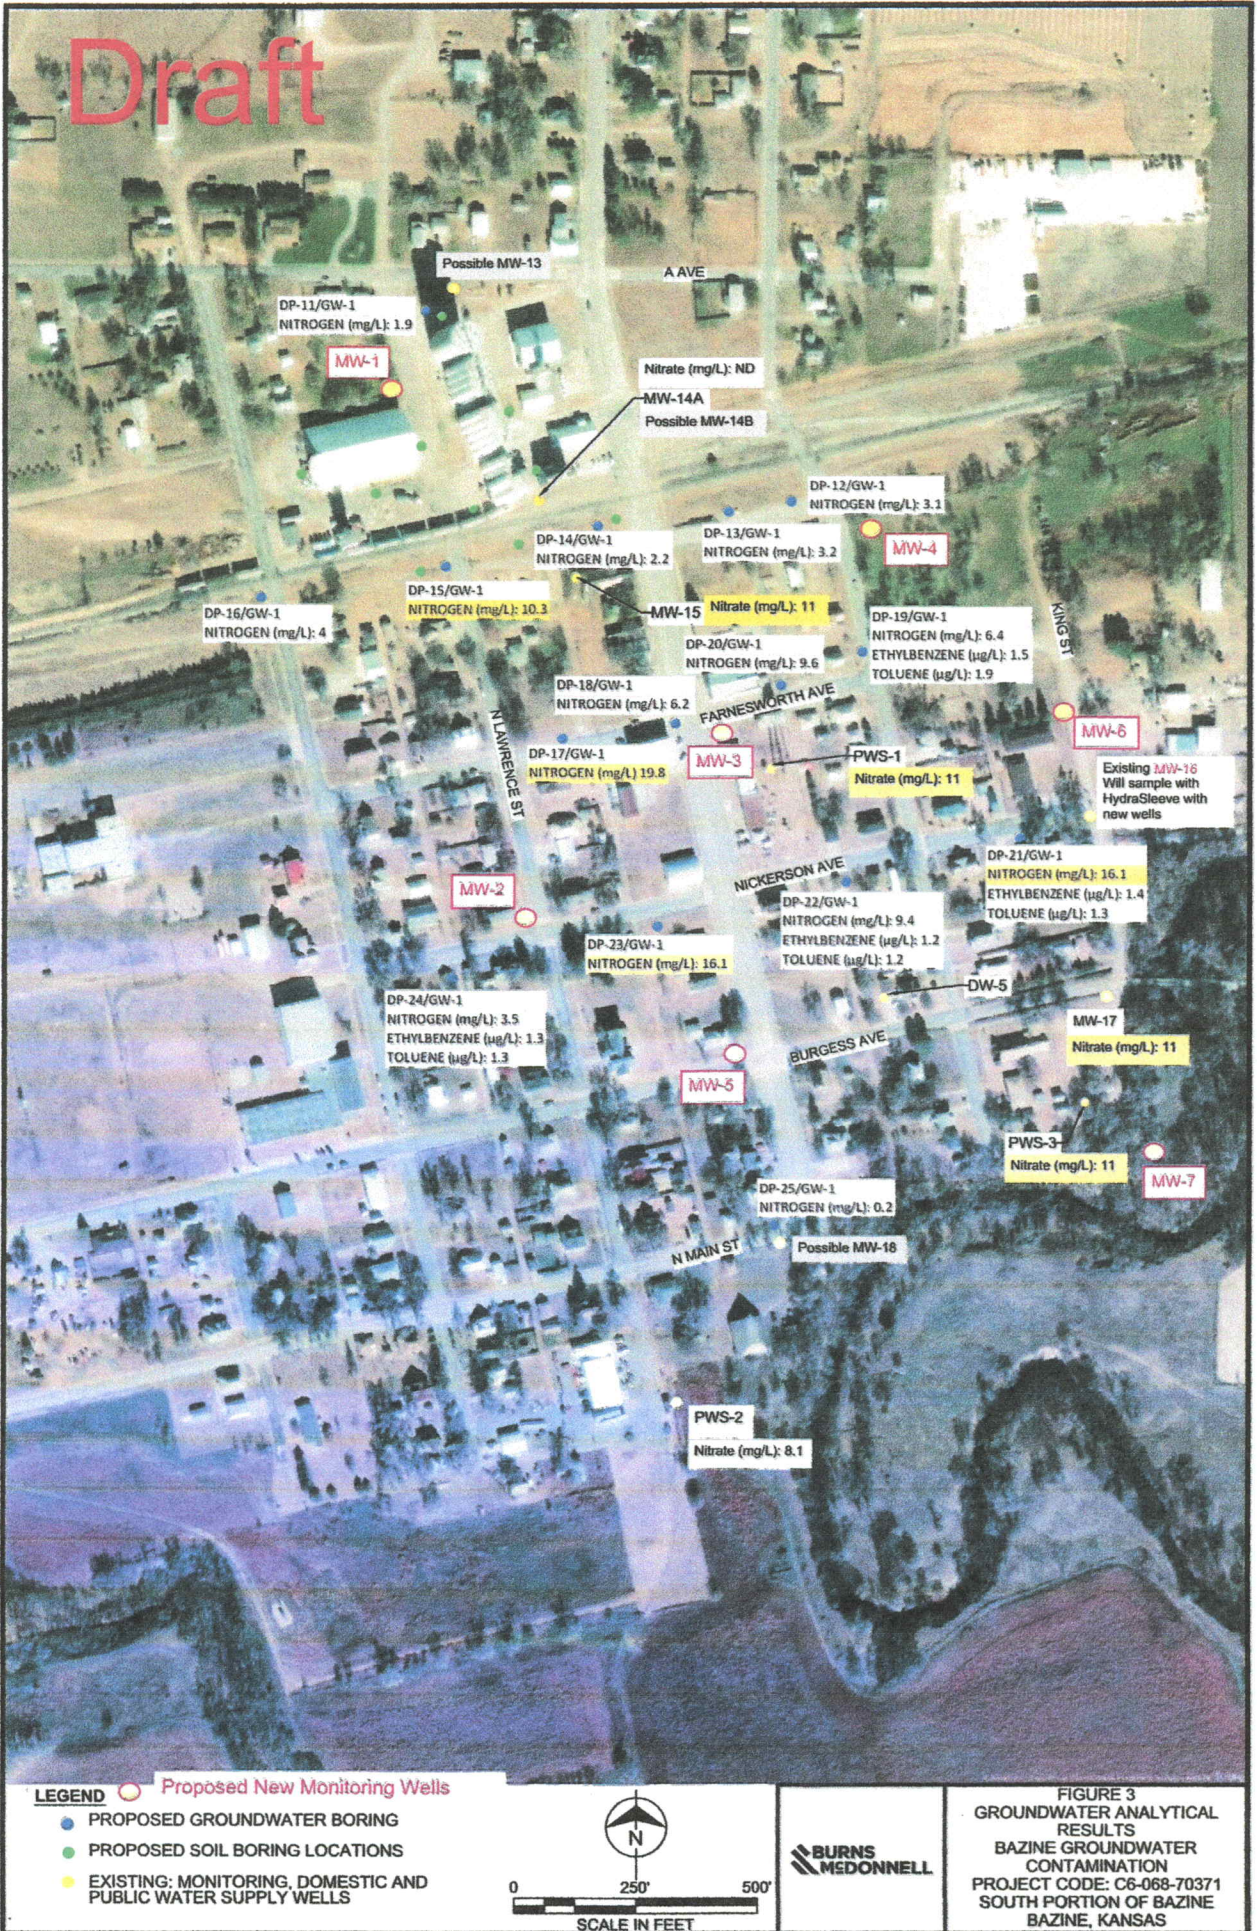

COPYRIGHT © 2019 BURNS & MCDONNELL ENGINEERING COMPANY, INC.

Z:\Clients\EN\KSDHE\115232_Bazine\GW\Design\CADD\DWG\115232_Bazine\FG2 - Locations.dwg 1/16/2019 TMO\JLLS