
				VWC-5			ion of Water			MW13R		
				e in Well Use			rces App. No.	T- 1: N-1	Well ID	27.1		
		WATER WELL	. :	Fraction NE 1/4 NW 1/4 SW 1	1/4 SW 1/4	Secti	on Number 30	Township Numb		ge Number B □ E ■ W		
County: Ness NE ½ NW ½ SW ½ SW ½ 30 T 18 S R 23 T 18 S T 18												
Business: Kansas Dept. of Health & Environment direction from nearest to												
Address	ess: 1000 SW Jackson St., Suite 410											
Address: 918 W. Sycamore, Ness City City: Topeka State: KS ZIP: 66612												
City:	Topeka			ZIP: 66612	L							
	"X" IN	4 DEPTH C	F COM	PLETED WELL:	48	ft.	5 Latitude	38.4534	2	(decimal degrees)		
	SECTION BOX: Depth(s) Groundwater Encountered: 1)											
	WELL'S STATIC WATER LEVEL:											
	below land surface, measured on (mo-day-y											
NW -	above land surface, measured on (mo-day-y						(WAAS enabled? ☐ Yes ■ No)					
	Pump test data: Well water was ft.						☐ Land Survey ☐ Topographic Map					
W	Well water was fi						Online Mapper:					
- SW -	afterhours pumping							0040.75				
	Estimated Yield:			ld:gpm			6 Elevation: 2243.75ft. ☐ Ground Level ☐ TOC Source: ☐ Land Survey ☐ GPS ☐ Topographic Map					
S Bore Hole Diameter:8 in								•				
1 mile in. to ft.												
1. Domestic				er Supply: well ID			10 □ Oil Fi	eld Water Supply: le	256			
	omestic: 5. ☐ Public Water Supply: well ID Household 6. ☐ Dewatering: how many wells?						10. Oil Field Water Supply: lease					
	☐ Lawn & Garden 7. ☐ Aquifer Recharge: well ID						☐ Cased	☐ Uncased ☐ C	Geotechnical			
	☐ Livestock 8. ■ Monitoring: well IDMW							al: how many bores				
2. ☐ Irrigat 3. ☐ Feedle	. ☐ Irrigation 9. Environmental Remediation: well ID . ☐ Feedlot ☐ Air Sparge ☐ Soil Vapor E					••••	a) Closed Loop ☐ Horizontal ☐ Vertical b) Open Loop ☐ Surface Discharge ☐ Inj. of Water					
4. Indust			ecovery	☐ Injection	Extraction							
4. ☐ Industrial ☐ Recovery ☐ Injection 13. ☐ Other (specify):												
Was a chemical bacteriological sample submitted to KDHE? 1 4es No 11 yes, date sample was submitted: Water well disinfected? Yes No												
8 TYPE OF CASING USED: ☐ Steel ■ PVC ☐ Other												
Casing diameter												
Casing height above land surface												
TYPE OF SCREEN OR PERFORATION MATERIAL:												
☐ Steel ☐ Stainless Steel ☐ Fiberglass ☐ PVC ☐ Other (Specify)												
SCREEN OR PERFORATION OPENINGS ARE:												
☐ Continuous Slot Mill Slot ☐ Gauze Wrapped ☐ Torch Cut ☐ Drilled Holes ☐ Other (Specify)												
☐ Louvered Shutter ☐ Key Punched ☐ Wire Wrapped ☐ Saw Cut ☐ None (Open Hole)												
SCREEN-PERFORATED INTERVALS: From .28 ft. to .48 ft., From ft. to ft., From ft. ft.												
GRAVEL PACK INTERVALS: From												
9 GROUT MATERIAL: Neat cement Cement grout Bentonite Other Concrete												
Grout Intervals: From												
Septic Tank												
☐ Sewer Lines ☐ Cess Pool ☐ Sewage Lagoon ☐ Fuel Storage ☐ Abandoned Water Well												
□ Watertight Sewer Lines □ Seepage Pit □ Feedyard □ Fertilizer Storage □ Oil Well/Gas Well ■ Other (Specify) .Contaminated Site												
Direction from well? ft.												
10 FROM	TO		HOLOGI		FROM			HO. LOG (cont.) or I	PLUGGING	INTERVALS		
0	2	Silt, clayey, Bro										
2	7	Silt, clayey, Lt. I										
7	14	Clay, silty, Brow										
14		Clay, silty, Lt. B										
27		Clay, silty, Brown										
31		Clay, AA w/1"-4" stringers			Notes:							
35	48	Clay, silty, sandy stringers, Gray										
					-							
11 CONTRACTOR'S OR LANDOWNER'S CERTIFICATION: This water well was constructed, reconstructed, or plugged												
under my ju	under my jurisdiction and was completed on (mo-day-year) .6/.12/201.7 and this record is true to the best of my knowledge and belief. Kansas Water Well Contractor's License No527 This Water Well Record was completed on (pro-day-year) .6/.14/201.7											
Kansas Wa	ter Well Co	ntractor's License	No527	7 This Wa	ter Well R	ecord	was complet	ed on (pgo-day-yea	ar) .6/.14/20)1.7		
under the b	usiness nam	e of GeoCore II	for each	onstructed well to: Ken	ene Dana	Signa	ture	4 Mary	or Clure e	**************************************		
Mail 1 white copy along with a fee of \$5.00 for each constructed well to: Kansas Department of Health and Environment, Bureau of Water, GWTS Section, 1000 SW Jackson St., Suite 420, Topeka, Kansas 66612-1367. Mail one to Water Well Owner and retain one for your records. Telephone 785-296-5524.												
	Visit us at http://www.kdheks.gov/waterwell/index.html KSA 82a-1212 Revised 7/10/2015											





feet 200 meters 60

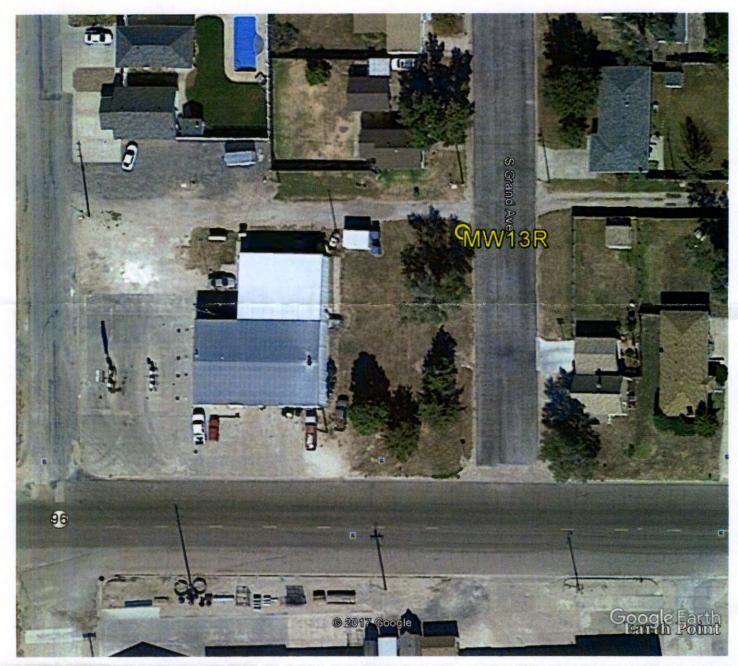

West Side Service, Inc. 918 W. Sycamore, Ness City

GPS Coordinates:

MW13:

38.453413, -99.916136 (not shown)

MW13R:

38.45342, -99.91619

RECEIVED

JUL 27 2017

BUREAU OF WATER