

-revised-

WATER WELL RECORD Form WWC-5

Division of Water Resources App. No.

[]

Well ID MW4

Original Record Correction Change in Well Use

1 LOCATION OF WATER WELL: County: NESS Fraction SW 1/4 NE 1/4 SW 1/4 SE 1/4 Section Number 30 Township Number T 18 S Range Number R 23 E W

2 WELL OWNER: Last Name: DEINES First: E. JAY Street or Rural Address where well is located: 211 WEST SYCAMORE STREET, NESS CITY, KS

3 LOCATE WELL WITH 'X' IN SECTION BOX: N W E S 1 mile

4 DEPTH OF COMPLETED WELL: 40 ft. Depth(s) Groundwater Encountered: 1) ... ft. 2) ... ft. 3) ... ft., or 4) Dry Well

5 Latitude: 38.45297 Longitude: 99.90606 Horizontal Datum: WGS 84

6 Elevation: 2251.30 ft. Ground Level TOC Source: Land Survey GPS Topographic Map Other

7 WELL WATER TO BE USED AS: 1. Domestic: Household Lawn & Garden Livestock Irrigation Feedlot Industrial

Was a chemical/bacteriological sample submitted to KDHE? Yes No If yes, date sample was submitted:

8 TYPE OF CASING USED: Steel PVC Other CASING JOINTS: Glued Clamped Welded Threaded

TYPE OF SCREEN OR PERFORATION MATERIAL: Steel Stainless Steel Fiberglass PVC Other

SCREEN OR PERFORATION OPENINGS ARE: Continuous Slot Mill Slot Gauze Wrapped Torch Cut Drilled Holes Other


SCREEN-PERFORATED INTERVALS: From 25 ft. to 40 ft. GRAVEL PACK INTERVALS: From 23 ft. to 40 ft.

9 GROUT MATERIAL: Neat cement Cement grout Bentonite Other Concrete Surface Completion 0-1

Nearest source of possible contamination: Septic Tank Lateral Lines Pit Privy Livestock Pens Insecticide Storage

Table with columns: 10 FROM, TO, LITHOLOGIC LOG, FROM, TO, LITHO. LOG (cont.) or PLUGGING INTERVALS. Rows: 0-5 CONCRETE, 5-22 SILTY CLAY, 22-30 SANDY CLAY, 30-36 SAND, 36-40 SHALE.

11 CONTRACTOR'S OR LANDOWNER'S CERTIFICATION: This water well was constructed, reconstructed, or plugged under my jurisdiction and was completed on (mo-day-year) 4/17/19

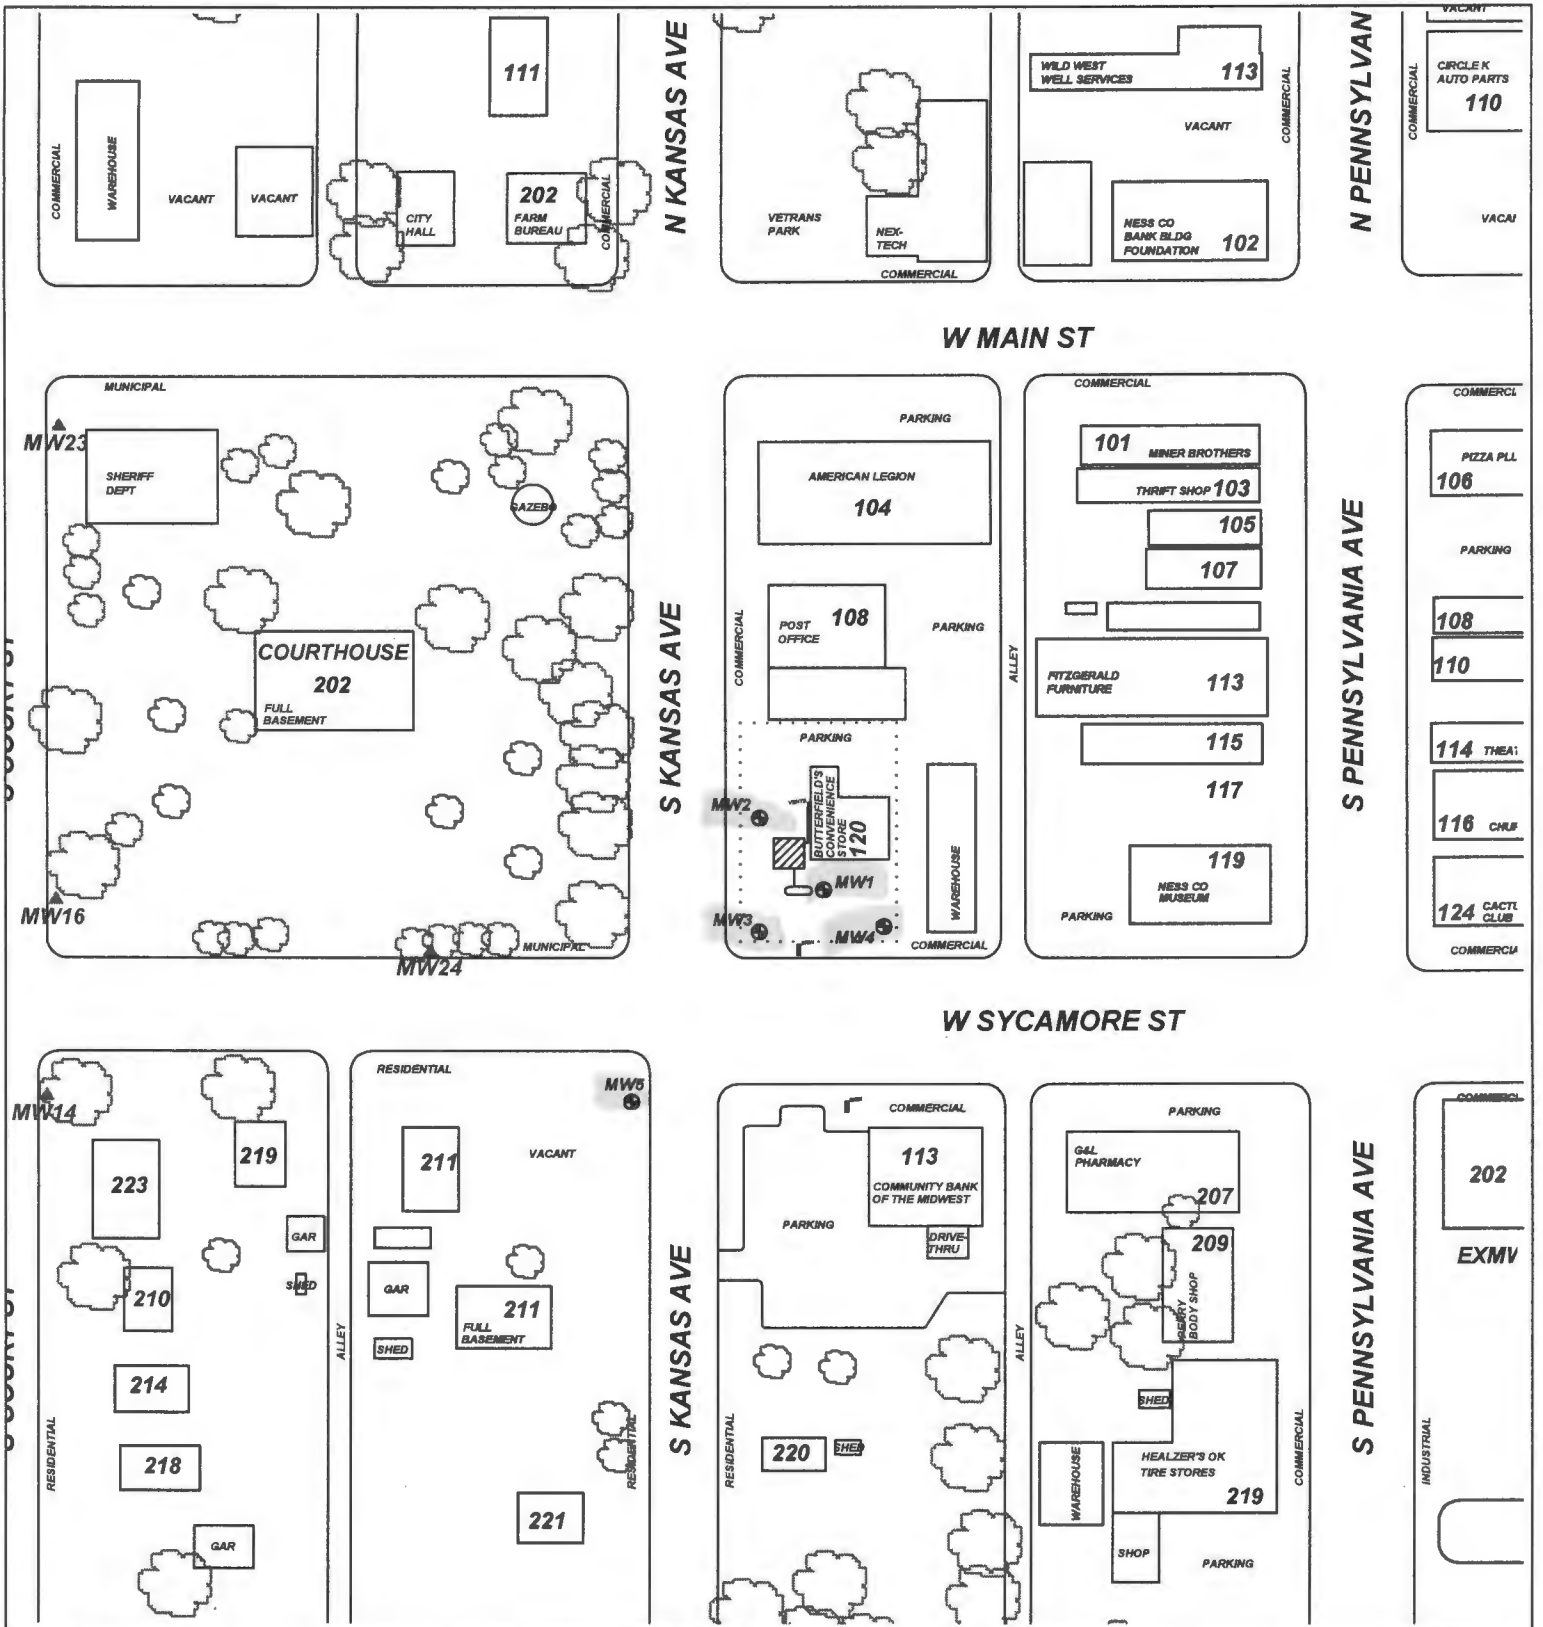

PROJECT: **BUTTERFIELD, INC.**

ADDRESS: **120 WEST SYCAMORE STREET**

LOCATION: **NESS CITY, KANSAS**

DRAWN BY: **B. JOHNSON** DATE: **1/9/19**

REVISED BY: **B. STALNAKER** DATE: **5/8/19**


AEI JOB #: **TF516** KDHE JOB #: **U6-068-15094**

TITLE:

ASSOCIATED ENVIRONMENTAL INC.

LEGEND:

- = CURRENT UST BASIN; 2-6,000 GAL. GAS, PRODUCT LINES AND PUMP ISLAND
- = MONITORING WELL
- = PLUGGED/DESTROYED WELL
- = SUBJECT PROPERTY

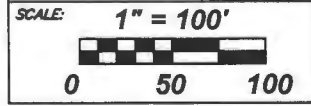

NOTES: