
	R WELL I		orm WWC-5	_	ivision of Water			MW-3	
	al Record		Change in Well Use		sources App. No		Well ID		
		VATER WELL:	Fraction	_	ection Number	Township Numb		nge Number	
County: Scott NW 1/4 SE 1/4 SE 1/4									
2 WELL OWNER: Last Name: First: Street or Rural Address where well is located (if unknown, distance and									
Business: Kansas Dept of Health & Environment direction from nearest town or intersection): If at owner's address, check here:									
Address: Address:	OLAL O OF NI OF NIA OF								
City: Topeka State: KS ZIP: 66612									
3 LOCAT				200		20 40264	15		
WITH			COMPLETED WELL:		ft. 5 Latitud	e: 38.48364	2040	(decimal degrees)	
SECTION BOX: Depth(s) Groundwater Encountered: 1)									
2) ft. 3) ft., or 4) \(\subseteq WELL'S STATIC WATER LEVEL:									
1	below land surface, measured on (mo-day-)								
l NRV	above land surface, measured on (mo day-					S (unit make/model: (WAAS enabled?			
Pump test data: Well water was						☐ Land Survey ☐ Topographic Map			
w -	w after hours pumping				■ Onl	Online Mapper: Google Earth			
1 1	1 ' 1		Well water was	ft.					
sw	SE		after hours pumping gpm			6 Elevation:ft. Ground Level TOC			
	X	Estimated Yield:	gpm						
S Bore Hole Di			ter: 9 in to 226		Other				
1 mile 11 mile 11 mile 12 mile									
7 WELL WATER TO BE USED AS: 1. Domestic: 5. □ Public Water Supply: well ID									
1. Domestic						10. Oil Field Water Supply: lease			
_	☐ Household 6. ☐ Dewatering: how many wells? ☐ Lawn & Garden 7. ☐ Aquifer Recharge: well ID				. II. Iest Ho	☐ Cased ☐ Uncased ☐ Geotechnical			
ı =	☐ Lawn & Garden 7. ☐ Aquifer Recharge: well ID				12. Geother	12. Geothermal: how many bores?			
_	2. Irrigation 9. Environmental Remediation: well ID					a) Closed Loop Horizontal Vertical			
3. ☐ Feedlot ☐ Air Sparge ☐ Soil Vapor E					b) Open Loop Surface Discharge Inj. of Water				
4. 🔲 Indust	rial	☐ Rec	overy Injection		13. 🔲 Othe	r (specify):			
Was a chemical/bacteriological sample submitted to KDHE? ☐ Yes ■ No If yes, date sample was submitted:									
Water well disinfected? Yes No									
8 TYPE OF CASING USED: ☐ Steel ■ PVC ☐ Other									
Casing diameter									
Casing height above land surface									
TYPE OF SCREEN OR PERFORATION MATERIAL:									
☐ Steel ☐ Stainless Steel ☐ Fiberglass ■ PVC ☐ Other (Specify)									
☐ Brass ☐ Galvanized Steel ☐ Concrete tile ☐ None used (open hole)									
SCREEN OR PERFORATION OPENINGS ARE:									
☐ Continuous Slot ☐ Mill Slot ☐ Gauze Wrapped ☐ Torch Cut ☐ Drilled Holes ☐ Other (Specify)									
□ Louvered Shutter □ Key Punched □ Wire Wrapped □ Saw Cut □ None (Open Hole)									
SCREEN-PERFORATED INTERVALS: From									
GRAVEL PACK INTERVALS: From 187 ft. to 226 ft., From ft. to ft., From ft. to ft.									
9 GROUT MATERIAL: ■ Neat cement									
Nearest source of possible contamination:									
Septic Tank Lateral Lines Pit Privy Livestock Pens Insecticide Storage									
Sewer Lines Cess Pool Sewage Lagoon Fuel Storage Abandoned Water Well									
☐ Watertight Sewer Lines ☐ Seepage Pit ☐ Feedyard ☐ Fertilizer Storage ☐ Oil Well/Gas Well									
Other (Specify)									
Direction from well?									
10 FROM	TO		DLOGIC LOG	FROM	TO LI	THO. LOG (cont.) or	PLUGGING	JINTERVALS	
0		Clay							
39		Sand, m-c, Brow	n						
49		Clay, Brown		_					
83		Sand, f-c, Brown		ļ					
94		Clay, Brown							
141		Sand, f-c, Brown							
214		Clay, Brown to Y	Notes:						
220 226 Shale, Dark Gray									
11 CONTRACTOR'S OR LANDOWNER'S CERTIFICATION: This water well was constructed, reconstructed, or plugged									
under my jurisdiction and was completed on (mo-day-year) .10/1/2018 and this record is true to the best of my knowledge and belief. Kansas Water Well Contractor's License No527 This Water Well Record was completed on (mq-day-year) .10/3.1/2018									
Kansas Wa	iter Well Coi	ntractor's License	No. 741 This Wa	ater Well Re	cord was comp	leted on tma-my-ye	ar) .144.5.17	Αν.ΙΩ	
under the business name of GeoCore Inc. Signature									
1000 SW Jackson St., Suite 420, Topeka, Kansas 66612-1367. Mail one to Water Well Owner and retain one for your records. Telephone 785-296-5524.									
Visit us at http://www.kdheks.gov/waterwell/index.html KSA 82a-1212 Revised 7/10/2015									

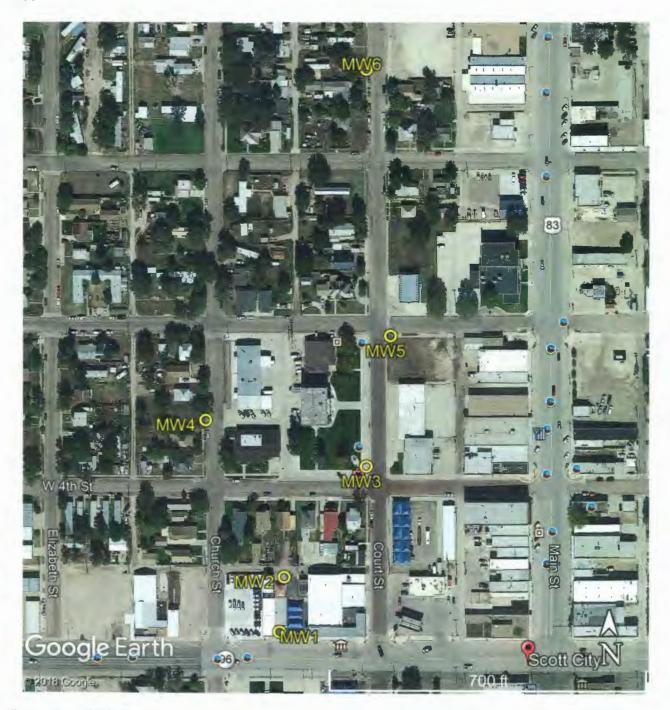

Former Donna's Cleaners 216 W. 5th Street, Scott City

GPS Coordinates:

MW-1: 38.482637, -100.909008 MW-2: 38.482973, -100.908972 MW-3: 38.483645, -100.908342 MW-4: 38.483923, -100.909577 MW-5: 38.484436, -100.908156 MW-6: 38.486048, -100.908340 RECEIVED

JAN 1 1 2019

BUREAU OF WATER