
			Form V			ivision of Wa			Well ID	MW-1		
Original Record Correction Change in Well Use I LOCATION OF WATER WELL: Fraction					Resources App. No.			Township Numbe		ge Number		
County: Scott SW 4 SE 4 SE 4												
2 WELL OWNER: Last Name: First: Street or Rural Address where well is located (if unknown, distance and												
Business: Kansas Dept of Health & Environment direction from nearest town or intersection): If at owner's address, check										heck here: 🔲		
	Address: 1000 SW Jackson St. Address:						216 W. 5th Street, Scott City					
	City: Topeka State: KS ZIP: 66612											
3 LOCAT					047			20 40262	7			
WITH				PLETED WELL:								
SECTION BOX: N Depth(s) Groundwater Encountered: 1) 2) ft. 3) ft., or 4)						Dry Well Horizontal Datum: WGS 84 I NAD 83 NAD 27						
	N			TER LEVEL:				Latitude/Longitude:		$3 \square \text{NAD} 21$		
	below land surface, measured on (mo-day-					GPS (unit make/model:)						
NW -	NWNE above land surface, measured on (mo-day-					••	(WAAS enabled? \Box Yes \Box No)					
	W E Pump test data: Well water was fi after hours pumping						□ Land Survey □ Topographic Map					
W	Well water was					Online Mapper: Google Earth						
SW	after hours pumping											
	Estimated Yield:					6 Elevation:ft. Ground Level TOC						
	S Bore Hole Diameter:					Sour	Source: Land Survey GPS Topographic Map					
1 mile												
7 WELL WATER TO BE USED AS: 1. Domestic: 5. □ Public Water Supply: well ID 10. □ Oil Field Water Supply: lease												
	□ Household 6. □ Dewatering: how many wells?					10. 🗖 C	11. Test Hole: well ID					
🗌 Lawn	Lawn & Garden 7. Aquifer Recharge: well ID							Uncased G				
. —	□ Lawn & Garden 7. □ Aquifer Recharge: well ID □ Livestock 8. ■ Monitoring: well IDMV					12. Geo		il: how many bores?				
2. Irrigation 9. Environmental Remediation: well ID								Loop 🔲 Horizonta				
3. Feedlot Soil Vapor E Soil Vapor E					Extraction		b) Open Loop 🗋 Surface Discharge 📋 Inj. of Water					
4. Industrial Recovery Injection 13. Other (specify):												
Was a chemical/bacteriological sample submitted to KDHE? ☐ Yes No If yes, date sample was submitted:												
8 TYPE OF CASING USED: Steel PVC Other CASING JOINTS: Glued Clamped Welded Threaded												
Casing diameter												
Casing height above land surface in. Weight lbs./ft. Wall thickness or gauge No. SCD. 4.0												
TYPE OF SCREEN OR PERFORATION MATERIAL:												
□ Steel □ Stainless Steel □ Fiberglass ■ PVC □ Other (Specify)												
Brass Galvanized Steel Concrete tile None used (open hole) SCREEN OR PERFORATION OPENINGS ARE:												
Continuous Slot ■ Mill Slot □ Gauze Wrapped □ Torch Cut □ Drilled Holes □ Other (Specify)												
□ Louvered Shutter □ Key Punched □ Wire Wrapped □ Saw Cut □ None (Open Hole)												
SCREEN-PERFORATED INTERVALS: From												
GRAVEL PACK INTERVALS: From												
9 GROUT MATERIAL: Neat cement Cement grout Bentonite Other												
Grout Intervals: From												
Nearest source of possible contamination: Septic Tank Lateral Lines Pit Privy Livestock Pens Insecticide Storage												
Sever Lines Cess Pool Sewage Lagoon Fuel Storage Abandoned Water Well												
	□ Watertight Sewer Lines □ Seepage Pit □ Feedyard □ Fertilizer Storage □ Oil Well/Gas Well											
□ Other (Specify) Direction from well? ft.												
10 FROM	TO TO								LICONIC	DITEDUALC		
0	10	Li Clay, Dark Br	THOLOGI		FROM 135	то 154	Sanc	IO. LOG (cont.) or F	LUGGING	INTERVALS		
14	15	Sand lens, f-r		DIOWII	155			clayey, Lt. Tan				
15	22		ay, some silt, Brown		157			and, f-m cemented				
22	40		ilt, clayey, Lt. Brown					, Lt. Tan				
40	68	Clay						nd, f-c				
68	99	Sand, f-c			176 180		Silt, clayey, Lt. Tan					
99	122	Clay, Brown to Lt. Tan			Notes: 1	A	3-186 Clay, Red Brown 217-222 Shale, Gray Blue					
122	22 132 Caliche					186-195 Sand						
132 135 Sand, clayey, Red Brown 195-217 Clay, Tan and Brown 1 11 CONTRACTOR'S OR LANDOWNER'S CERTIFICATION: This water well was constructed, reconstructed, or reconstructed, or plugged 1												
11 CONT	KACTOR'	S OR LANDO	WNER'S	CERTIFICATION	: This wate	r well was	con	structed, \Box recon	structed, or			
Kansas Wa	ter Well Co	ind was comple	nse No 52	-day-year) .9/27/20 7 This Wa	ter Well Re	inis record	is true	ed on (man-day-yea	knowledge (r) 10/31/2	2018		
under the b	usiness nan	ne of GeoCor	e Inc		Si	gnature	l. ks	Le Marl				
Mail	1 white copy a	long with a fee of \$	5.00 for each	constructed well to: Kan	sas Departmen	t of Health and	Enviro	nment, Bureau of Wate	er, GWTS Se	ction,		
1000 SW Jackson St., Suite 420, Topeka, Kansas 66612-1367. Mail one to Water Well Owner and retain one for your records. Telephone 785-296-5524. Visit us at http://www.kdheks.gov/waterwell/index.html KSA 82a-1212 Revised 7/10/2015												
Visit us at http	://www.kdhel	s.gov/waterwell/in	aex.ntml		<u>KSA 82a-12</u>	<u>_12</u>			REVISED /	110/2013		

Scott SW SESESE 13-18-33W

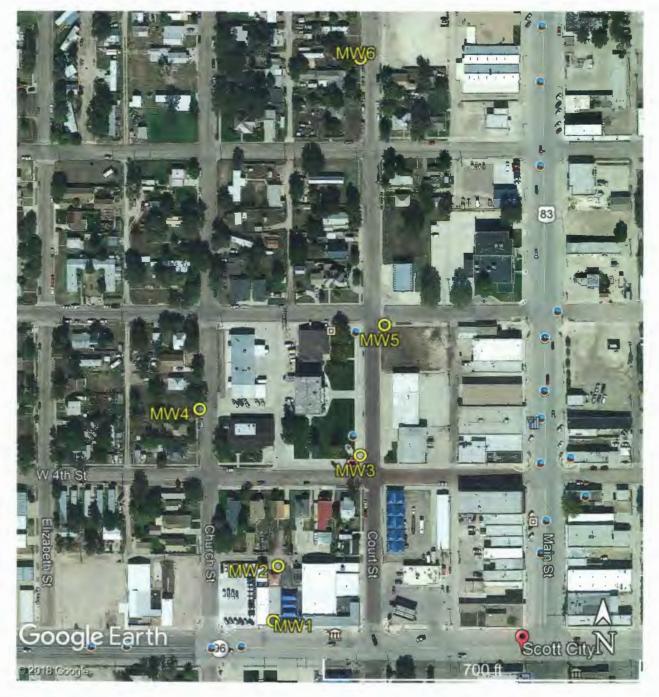

Former Donna's Cleaners 216 W. 5th Street, Scott City

GPS Coordinates:

 MW-1:
 38.482637, -100.909008

 MW-2:
 38.482973, -100.908972

 MW-3:
 38.483645, -100.908342

 MW-4:
 38.483923, -100.909577

 MW-5:
 38.484436, -100.908156

 MW-6:
 38.486048, -100.908340

RECEIVED JAN 1 1 2019 BUREAU OF WATER