
		KECOKD		WWC-5				ion of Wate	- 1		*** ** **	MVV-2		
		Correction		ge in Well Use				rces App. N			Well ID	Normalian		
		VATER WEI	L:	Fraction	CE I	(05.1/	Section	on Numbe	r T	ownship Number T 18 S		nge Number 3 □ E ■ W		
	y: Scott			SW ¼ SE ¼ First:	3E 7		D							
	OWNER:	Street or	Street or Rural Address where well is located (if unknown, distance and direction from nearest town or intersection): If at owner's address, check here:											
	Business: Kansas Dept of Health & Environment Address: 1000 SW Jackson St.													
Address	Address: 216 W								N. 5th Street, Scott City					
City:	Topeka		State: KS	ZIP: 66612										
3 LOCAT	3 LOCATE WELL 4 DEPTH OF COMPLETED WELL:													
WITH "			ncountered: 1) ft.				Longitude: -100.908972 (decimal degrees)							
SECTIO	3) ft., or 4) ☐ Dry Well				Horizo	ntal Da	atum: WGS 84	□NAD	83 NAD 27					
1	TER LEVEL: ft.				Source	e for La	titude/Longitude:							
	, measured on (mo-day-yr)				GPS (unit make/model:)									
				, measured on (mo-day-yr)						AAS enabled? 🔲 Y		lo)		
1 1	E	vater was ft.				Land Survey Topographic Map								
W	s pumping gpm vater was ft.				■ Online Mapper: Google Earth									
sw	s pumping gpm													
X Estimated Yield:				gnm				6 Elevation:ft. Ground Level TOC						
	S Bore Hole Diameter:				9 in. to225 ft. and			Source: Land Survey GPS Topographic Map						
1 1	mile		in. to	in. to ft.					ther		·····			
7 WELL WATER TO BE USED AS:														
1. Domestic				ater Supply: well						Water Supply: leas				
	☐ Household 6. ☐ Dewatering:					: how many wells?				11. Test Hole: well ID				
	& Garden	charge: well ID				☐ Cased ☐ Uncased ☐ Geotechnical 12. Geothermal: how many bores?								
Livest								oop Horizontal						
3. Feedlo	2. ☐ Irrigation 9. Environmental Remediation: well ID 3. ☐ Feedlot ☐ Air Sparge ☐ Soil Vapor E						••••			p Surface Discl				
4. Indust			Recovery			DAG GOLOLO								
	Was a chemical/bacteriological sample submitted to KDHE? ☐ Yes ■ No If yes, date sample was submitted:													
Water well disinfected? Yes No CASDIG IODITS: Check Cleaned Wolded Threeded														
8 TYPE OF CASING USED: Steel PVC Other														
Casing heigh	Casing height above land surface in. Weight lbs/ft. Wall thickness or gauge No. Sch. 40.													
TYPE OF SCREEN OR PERFORATION MATERIAL:														
Steel Stainless Steel Fiberglass ■ PVC Other (Specify)														
	☐ Brass ☐ Galvanized Steel ☐ Concrete tile ☐ None used (open hole)													
SCREEN (OR PERFOI	RATION OPE												
	nuous Slot	Mill Slot		auze Wrapped						her (Specify)	• • • • • • • • • • • • • • • • • • • •			
Louve	ered Shutter	☐ Key Punch	ned □ W	ire Wrapped	☐ Sa	w Cut	Nor	ne (Open H	ole)	A F	٥.			
SCREEN-I	PERFORAI	ED INTERVA	ALS: From	1.13V ft. to	.440.	ft., Fro	m	It. to		ft., From	It. to	π.		
										ft., From				
9 GROUI	MATERI	AL: Neat o	ement 62	Cement grout	Be	entonite	∐ Oth	ner	143	3 _{ft. to} 182	Δ			
Nearest son	als: From	π. το de contaminati		π., From ೪ 4	• • • • • • • • • • • • • • • • • • • •	π. το		п., From .		2 II. 10	IL.			
Septic			on: Lateral Line	s 🗆 Pit P	rivv		ПБ	ivestock Per	ns	☐ Insecticid	e Storage			
Sewer		_	Cess Pool	Sewa		goon	_	uel Storage		☐ Abandone				
	ight Sewer L		Seepage Pit			B		ertilizer Stor		Oil Well/				
Other (Specify)														
	Direction from well?													
10 FROM	ТО		ITHOLOG	GIC LOG		FROM				. LOG (cont.) or Pl	LUGGIN	G INTERVALS		
0		Clay				147				ayey, Lt. Tan				
26		Silt, Lt. Brow	n			150	_			f-m, Lt. Tan				
40	70	Clay				161				ayey, Lt. Tan				
70		Sand, f-c				177			Sand,					
105		Sand lens, co		(caliche)		198				t. Tan				
106	121	Clay, Lt. Brow		14		205		25	Shale,	Yellow Brn to D	k Blue	Gray		
121		Sand, clayey, Red Brown					Notes:							
129 133 Caliche														
133 147 Sand f-m														
11 CONTRACTOR'S OR LANDOWNER'S CERTIFICATION: This water well was constructed, reconstructed, or plugged														
under my jurisdiction and was completed on (mo-day-year) .9/26/2018 and this record is true to the best of my knowledge and belief. Kansas Water Well Contractor's License No. 527 This Water Well Record was completed on (mo-day-year) .10/3.1/2018														
under the business name of GeoCore Inc.														
Mail 1 white copy along with a fee of \$5.00 for each constructed well to: Kansas Department of Health and Environment, Bureau of Water, GWTS Section,														
1000	SW Jackson S	St., Suite 420. Ton	eka, Kansas	66612-1367. Mail	one to	Water Well	Owner	and retain or	ne for yo	ur records. Telephon	e 785-296-	5524.		
1000 SW Jackson St., Suite 420, Topeka, Kansas 66612-1367. Mail one to Water Well Owner and retain one for your records. Telephone 785-296-5524. Visit us at http://www.kdheks.gov/waterwell/index.html KSA 82a-1212 Revised 7/10/2015												7/10/2015		

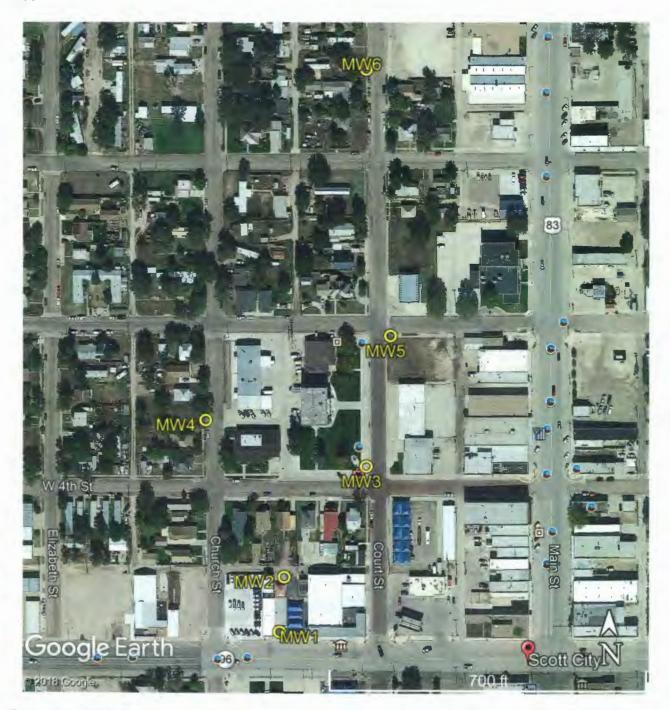

Former Donna's Cleaners 216 W. 5th Street, Scott City

GPS Coordinates:

MW-1: 38.482637, -100.909008 MW-2: 38.482973, -100.908972 MW-3: 38.483645, -100.908342 MW-4: 38.483923, -100.909577 MW-5: 38.484436, -100.908156 MW-6: 38.486048, -100.908340 RECEIVED

JAN 1 1 2019

BUREAU OF WATER