

County: Barton Fraction: SE SE SE SE Sec. 20 T. 19 S R. 13 W

CORRECTION(S) to WATER WELL COMPLETION RECORD Form WWC-5 (to rectify lacking or incorrect information)

Owner: Presto 18 MW 16

If location corrected, was listed as:

Section-Township-Range: 21-19-13W

Fraction (1/4 calls): SE SE SE

Location changed to:

20-19-13W

SE SE SE SE

Other changes: Initial statements: Anspaugh Rentals

1123 Washington, Great Bend

Changed to: Presto 18

2401 Washington St, Great Bend Elevation 1851.67

Comments: _____

Verification method: Per Carlson's Surveying Mapping survey & memorandum from KDHE 12-01-2019

Initials: SH Date: 04-22-2020

Submitted by: ☒ Kansas Geological Survey, Data Resources Library, 1930 Constant Ave., Lawrence, KS 66047-3724


☐ Kansas Dept. of Health & Environment, Bureau of Water, 1000 SW Jackson, Suite 420, Topeka, KS 66612-1367

1	LOCATION OF WATER WELL:	Fraction	Section Number	Township Number	Range Number
	County: Barton	SE ¼ SE ¼ SE ¼	21	19 S	13 

Distance and direction from nearest town or city street address of well if located within city?

Vacant lot at NW corner of 24th and Washington, Great Bend

2	WATER WELL OWNER: Anspaugh Rentals 1123 Washington RR #, St. Address, Box #: Great Bend, KS 67530 City, State, ZIP Code :	Board of Agriculture, Division of Water Resources Application Number:
---	---	--

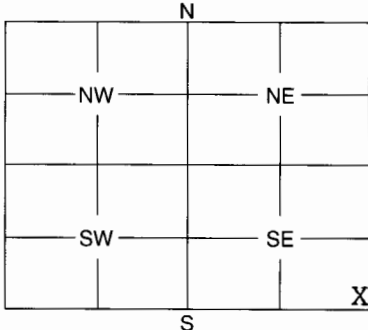3	MARK WELL'S LOCATION WITH AN "X" IN SECTION BOX: 	4	DEPTH OF WELL 16.28 ft. WELL'S STATIC WATER LEVEL 16.04 ft. WELL WAS USED AS: <table border="0"> <tr> <td>1 Domestic</td> <td>5 Public Water Supply</td> <td>9 Dewatering</td> </tr> <tr> <td>2 Irrigation</td> <td>6 Oil Field Water Supply</td> <td>☒ 10 Monitoring Well</td> </tr> <tr> <td>3 Feedlot</td> <td>7 Domestic (Lawn & Garden)</td> <td>11 Injection Well</td> </tr> <tr> <td>4 Industrial</td> <td>8 Air Conditioning</td> <td>12 Other</td> </tr> </table>	1 Domestic	5 Public Water Supply	9 Dewatering	2 Irrigation	6 Oil Field Water Supply	☒ 10 Monitoring Well	3 Feedlot	7 Domestic (Lawn & Garden)	11 Injection Well	4 Industrial	8 Air Conditioning	12 Other
1 Domestic	5 Public Water Supply	9 Dewatering													
2 Irrigation	6 Oil Field Water Supply	☒ 10 Monitoring Well													
3 Feedlot	7 Domestic (Lawn & Garden)	11 Injection Well													
4 Industrial	8 Air Conditioning	12 Other													

Was a chemical / bacteriological sample submitted to Department? Yes No **X**.....
If yes, mo/day/yr sample was submitted

Water Well Disinfected: Yes No **X**.....

5	TYPE OF BLANK CASING USED: <table border="0"> <tr> <td>1 Steel</td> <td>3 RMP (SR)</td> <td>5 Wrought</td> <td>7 Fiberglass</td> <td>9 Other (Specify below)</td> </tr> <tr> <td>☒ 2 PVC</td> <td>4 ABS</td> <td>6 Asbestos-Cement</td> <td>8 Concrete Tile</td> <td></td> </tr> </table>	1 Steel	3 RMP (SR)	5 Wrought	7 Fiberglass	9 Other (Specify below)	☒ 2 PVC	4 ABS	6 Asbestos-Cement	8 Concrete Tile	
1 Steel	3 RMP (SR)	5 Wrought	7 Fiberglass	9 Other (Specify below)							
☒ 2 PVC	4 ABS	6 Asbestos-Cement	8 Concrete Tile								

Blank casing diameter **2** in. Was casing pulled? Yes **X**..... No If yes, how much **16.4** in.
Casing height above or **below** land surface **6** in.

6	GROUT PLUG MATERIAL: 1 Neat cement 2 Cement grout ☒ 3 Bentonite 4 Other
---	--

Grout Plug Intervals: From **1.7** ft. to **1** ft., From ft. to ft., From to ft.


What is the nearest source of possible contamination:

1 Septic tank	6 Seepage pit	11 Fuel storage	16 Other (specify below)
2 Sewer lines	7 Pit privy	12 Fertilizer storage	
☒ 3 Watertight sewer lines	8 Sewage lagoon	13 Insecticide storage	
4 Lateral lines	9 Feedyard	14 Abandoned water well	
5 Cess pool	10 Livestock pens	15 Oil well/Gas well	


Direction from well? **South**..... How many feet? **7.5**.....

FROM	TO	PLUGGING MATERIALS
17	1	3/8 Bentonite Chips
1	0	Clay and top soil

MW16

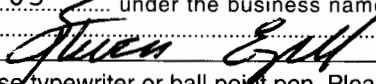7	CONTRACTOR'S OF LANDOWNER'S CERTIFICATION: This water well was plugged under my jurisdiction and was completed on (mo/day/year) 10-25-05 and this record is true to the best of my knowledge and belief. Kansas Water Well Contractor's License No. 665 This Water Well Record was completed on (mo/day/year) 10-26-05 under the business name of Pratt Well Environmental by (signature) 
---	--

INSTRUCTIONS: Use typewriter or ball point pen. Please press firmly and print clearly. Please fill in blanks, underline or circle the correct answers. Send top three copies to Kansas Department of Health and Environment, Bureau of Water, Geology Section, 1000 SW Jackson St., Ste. 420, Topeka, Kansas 66612-1367. Telephone: 785/296-5522. Send one to Water Well Owner and retain one for your records.

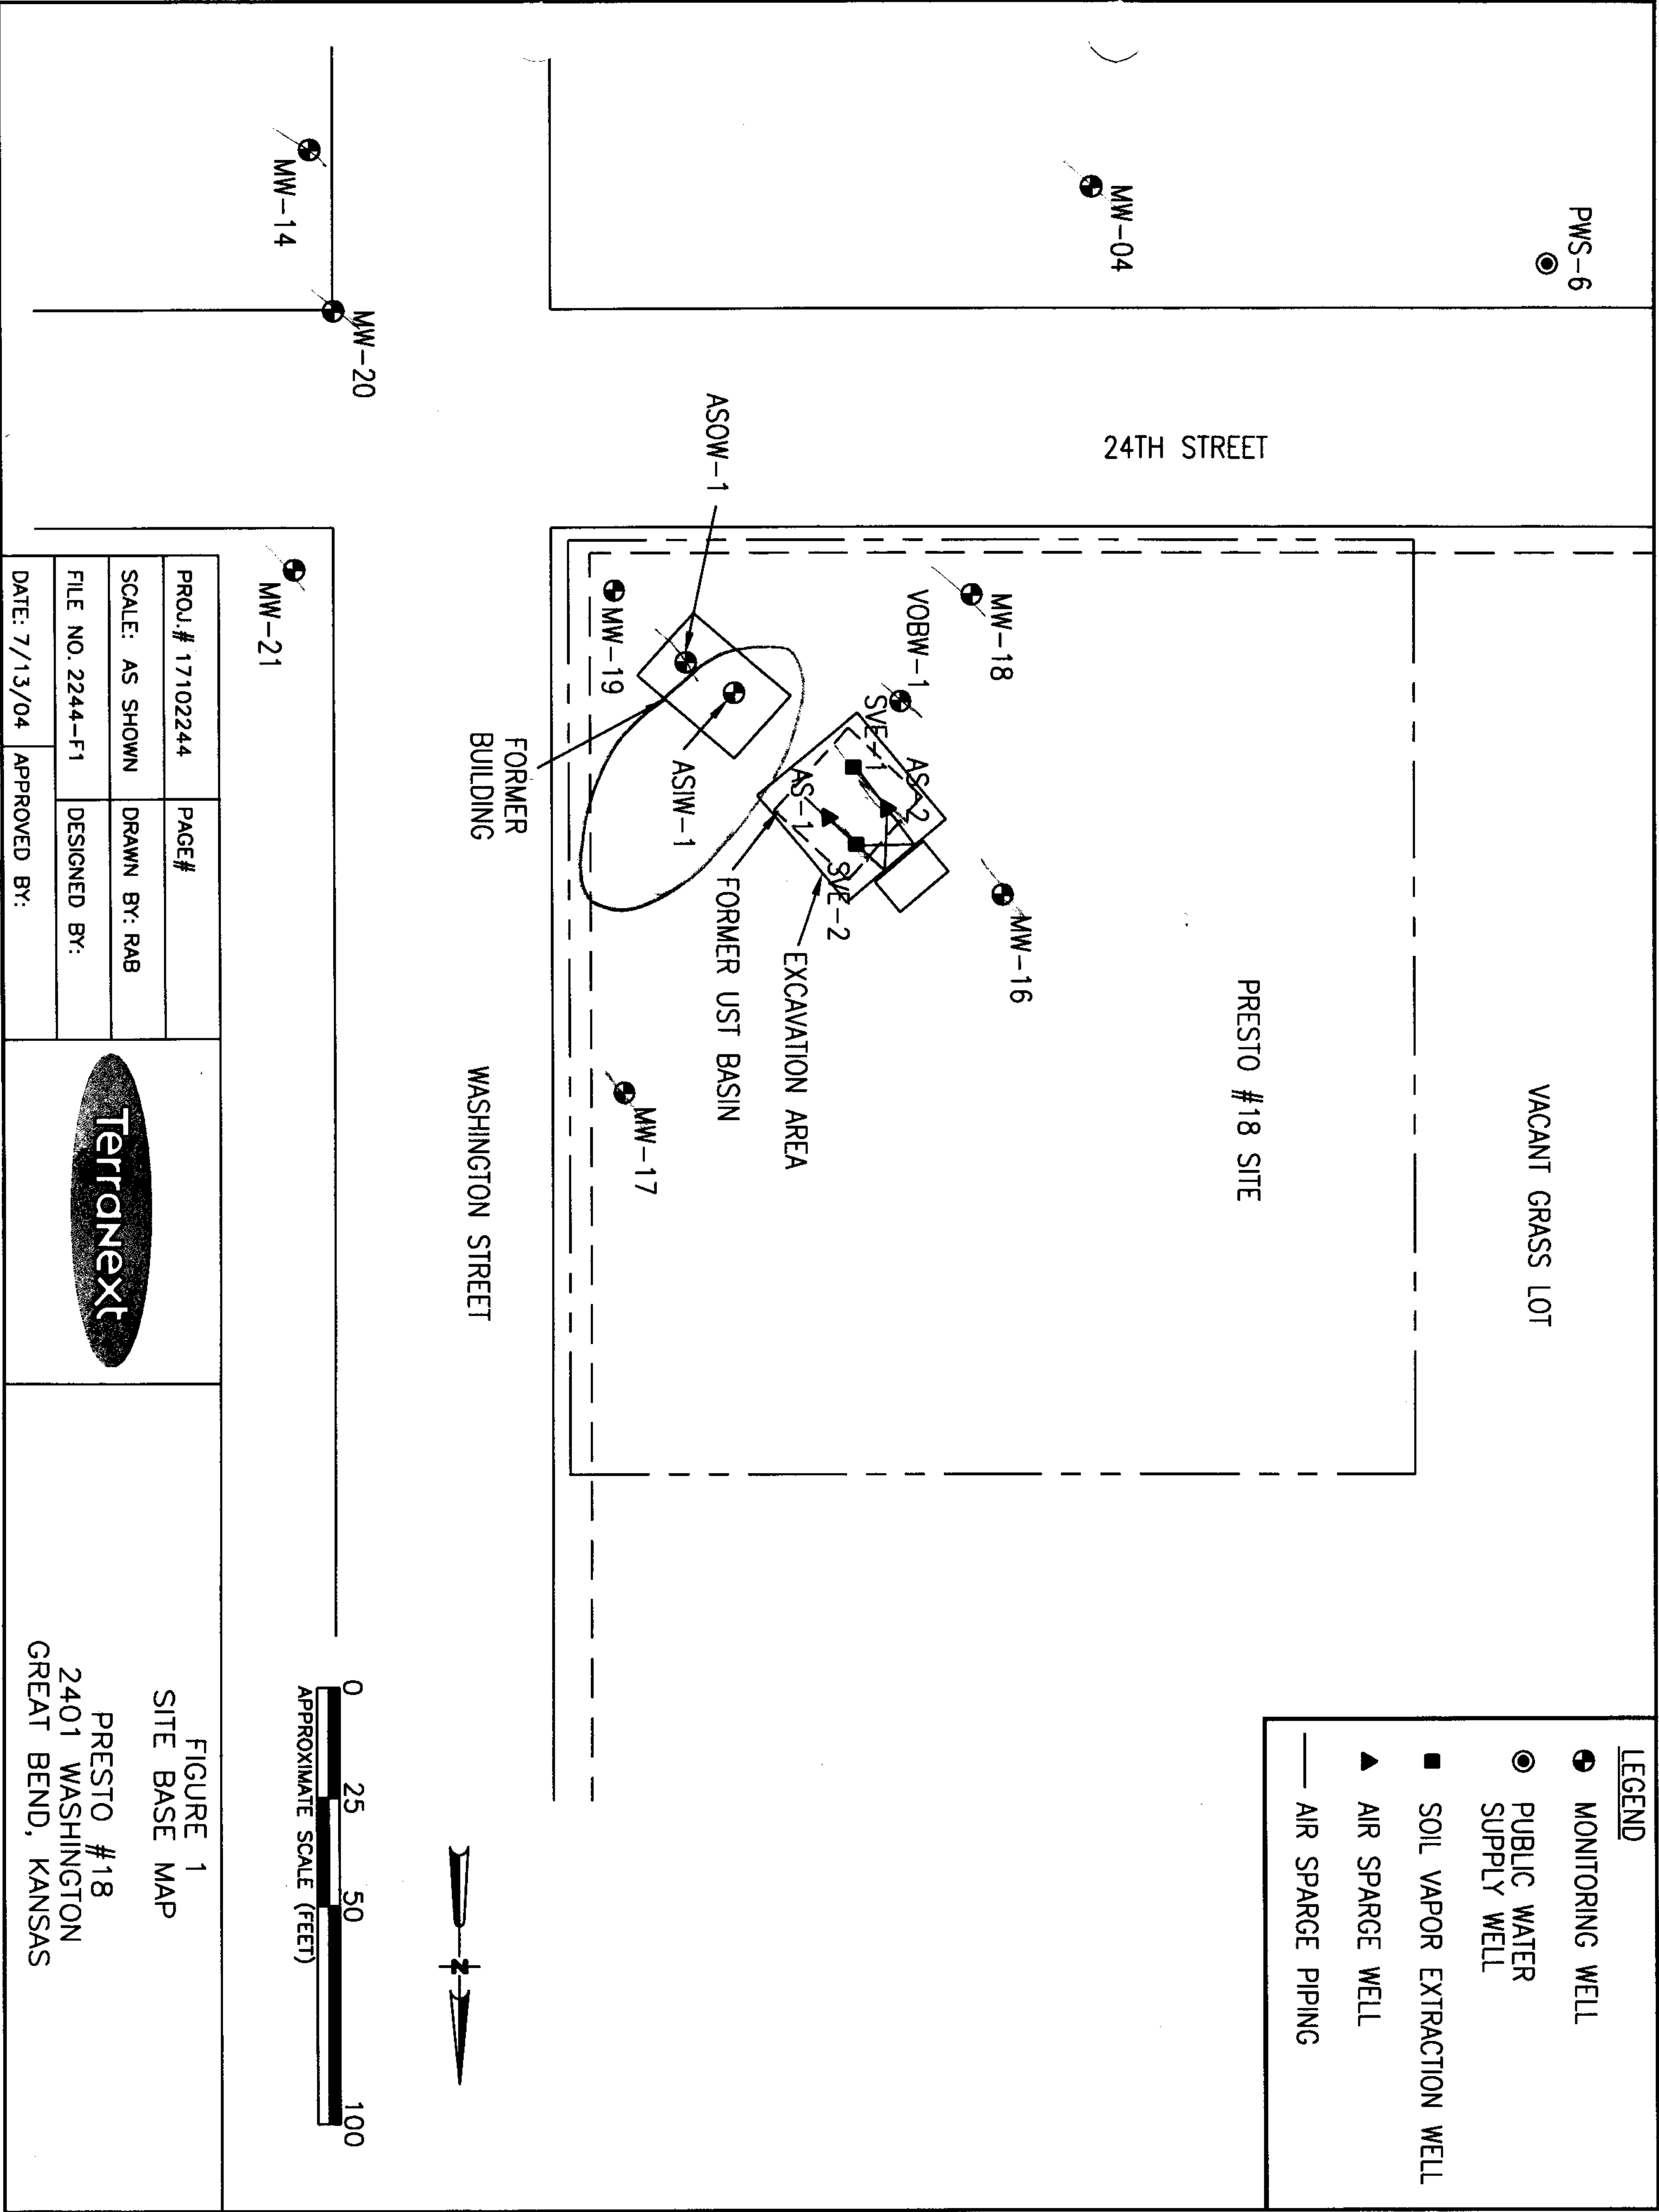

1631 200th Ave.
P.O. Box 1393
Hays, Kansas 67601
(785) 628-3219
(785) 628-2132 Fax
(785) 623-1555 Mobile
E-mail carlson@odsys.net

EVERGREEN ENVIRONMENTAL SERVICES, INC.
10553 Rene
Lenexa, Kansas 66215

March 4, 1998
#8822
page 1 of 1

SURVEYING FOR MONITORING WELLS PRESTO #18, GREAT BEND, BARTON COUNTY, KANSAS

Surveys

Land

Environmental

ALTA

Topography

Architectural

Platting

Construction

Preliminary

Staking

As-builts

Mapping

Site Plans

Utilities


Contours

Wells were surveyed using the existing control point on site.

ADDITIONAL WELLS

#	NORTH	WEST	LATITUDE D M S	LONGITUDE D M S	ELEVATION
MW 15	5405.99	105.91	38-22-37	98-46-27	1852.34 BOLT
SE-SE-SE-SE	103.85				1851.18 TOC
MW 16	5431.39	164.35	38-22-37	98-46-28	1851.67 BOLT
SE-SE-SE-SE	129.25				1851.44 TOC
MW 17	5460.84	43.22	38-22-37	98-46-27	1852.27 BOLT
SE-SE-SE-SE	158.70				1851.77 TOC
MW 18	5356.44	121.21	38-22-36	98-46-28	1851.92 BOLT
SE-SE-SE-SE	54.30				1851.67 TOC
MW 19	5360.95	52.18	38-22-36	98-46-27	1852.16 BOLT
SE-SE-SE-SE	58.81				1851.30 TOC

NOTE: Wells are in Sec 20 T19S R13W.

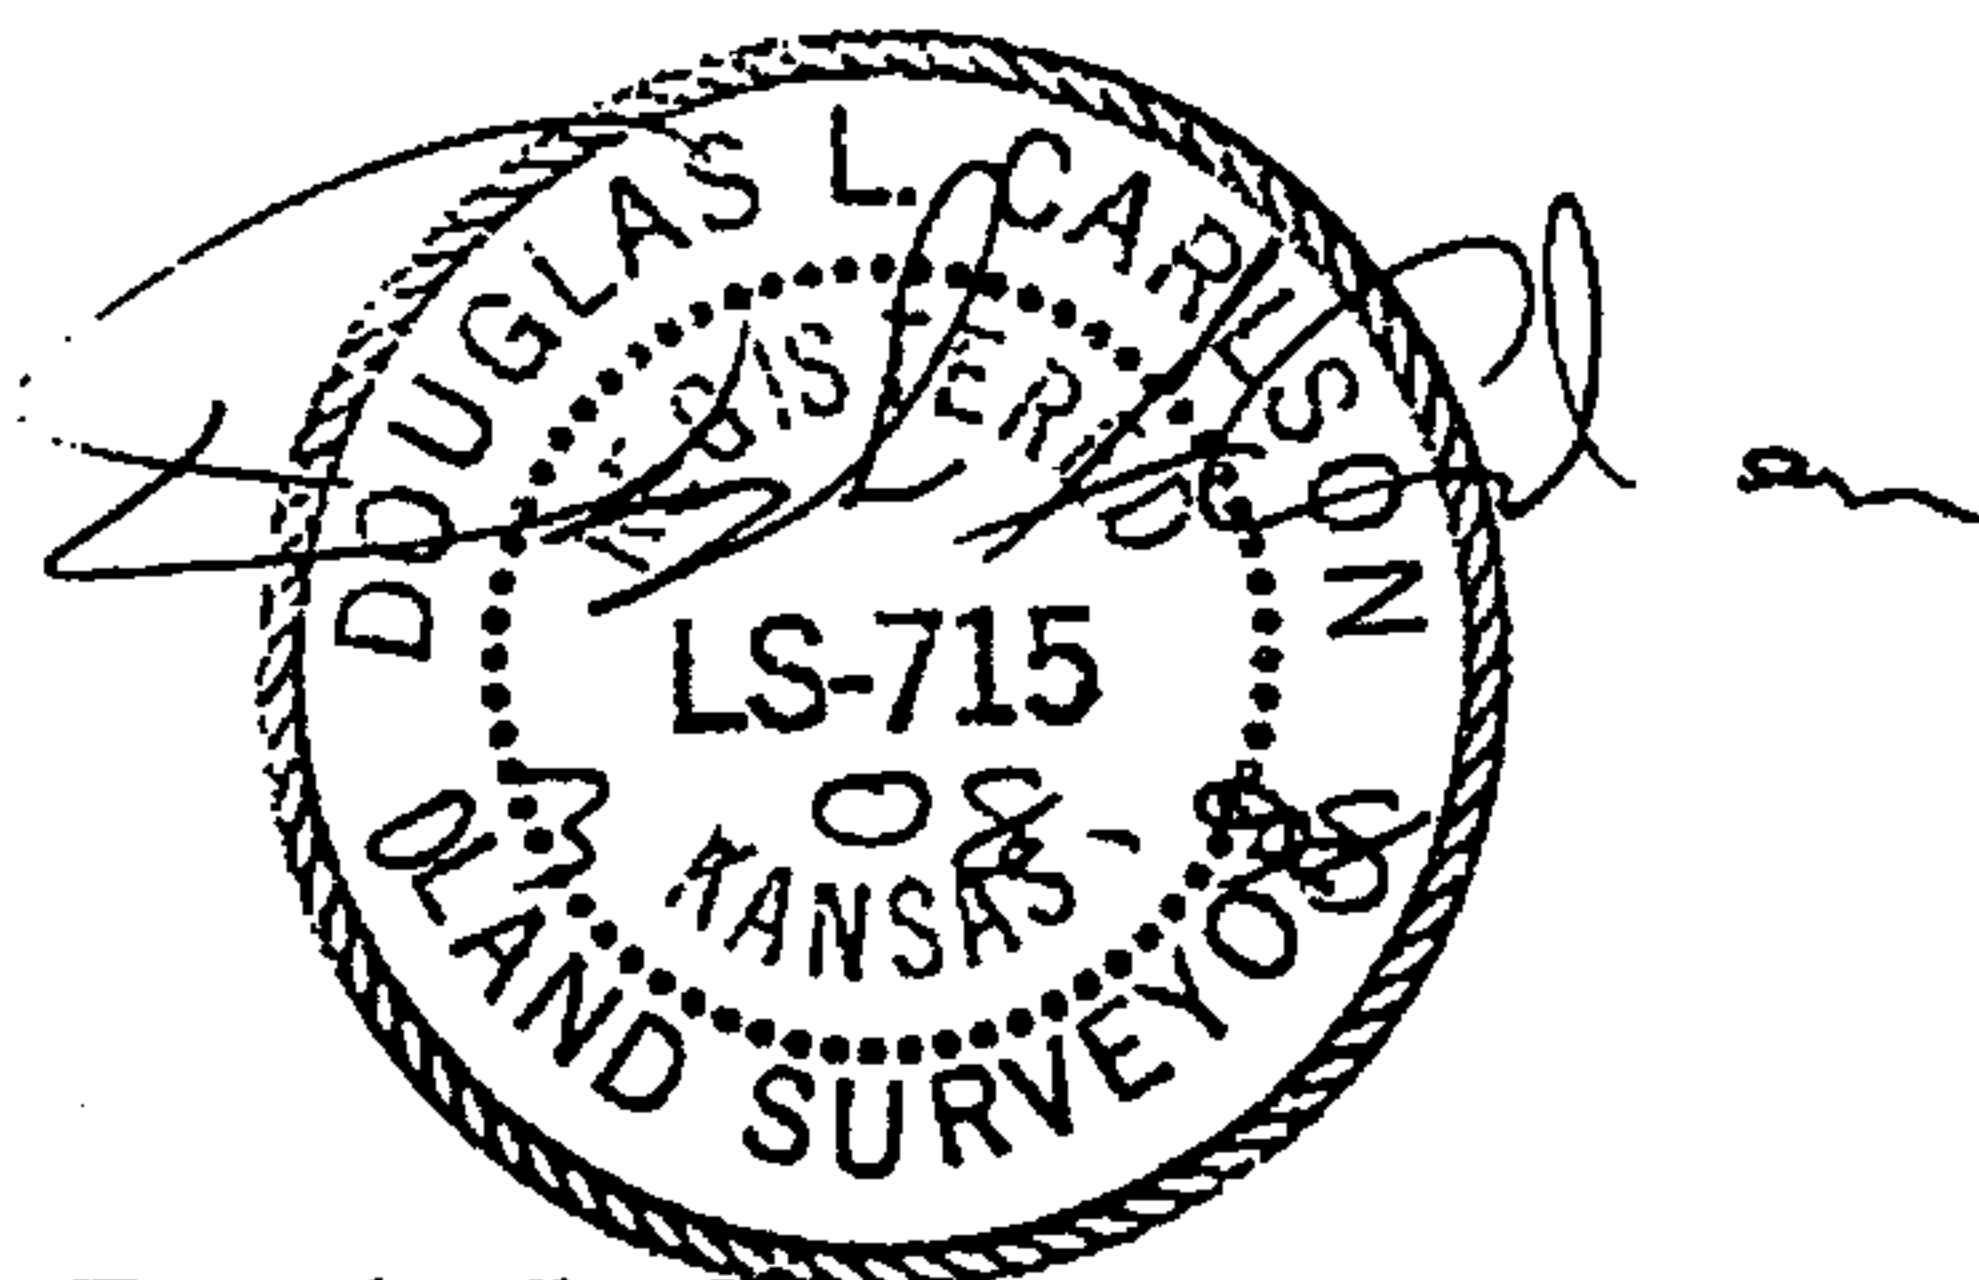

Douglas L. Carlson
Kansas Reg. No. 715