

County: Barton Fraction: SE SE SE SE Sec. 20 T. 19 S R. 13 W

CORRECTION(S) to WATER WELL COMPLETION RECORD Form WWC-5 (to rectify lacking or incorrect information)

Owner: Presto 18 MW 17

If location corrected, was listed as:

Section-Township-Range: 29-19-13W

Fraction (1/4 calls): SE SE NE

Location changed to:

20-19-13W

SE SE SE SE

Other changes: Initial statements: _____

Changed to: Elevation 1851.77

Comments: _____

Verification method: Per Carlson's Surveying Mapping survey & memorandum from KDHE 12-01-2019

Initials: SH Date: 04-22-2020

Submitted by: ☒ Kansas Geological Survey, Data Resources Library, 1930 Constant Ave., Lawrence, KS 66047-3724
☐ Kansas Dept. of Health & Environment, Bureau of Water, 1000 SW Jackson, Suite 420, Topeka, KS 66612-1367

1 LOCATION OF WATER WELL: County: Barton Fraction: SE 1/4 SE 1/4 NE 1/4 Section Number: 29 Township Number: T 19 S Range Number: R 13 EW Distance and direction from nearest town or city street address of well if located within city?

2 WATER WELL OWNER: Presto #18 NW 17 2401 Washington Board of Agriculture, Division of Water Resources City, State, ZIP Code: Great Bend, KS Application Number:

3 LOCATE WELL'S LOCATION WITH AN "X" IN SECTION BOX: [Section Box Diagram] 4 DEPTH OF COMPLETED WELL: 16.90 ft. ELEVATION: 1851.77 ft. WELL'S STATIC WATER LEVEL: 12.66 ft. below land surface measured on mo/day/yr: 2/24/98

5 TYPE OF BLANK CASING USED: 1 Steel 2 PVC 3 RMP (SR) 4 ABS 5 Wrought iron 6 Asbestos-Cement 7 Fiberglass 8 Concrete tile 9 Other (specify below) CASING JOINTS: Glued Clamped Welded Threaded

Blank casing diameter: 2 in. Dia. Casing height above land surface: 0.5 in. weight lbs./ft. Wall thickness or gauge No. 40

TYPE OF SCREEN OR PERFORATION MATERIAL: 1 Steel 2 Brass 3 Stainless steel 4 Galvanized steel 5 Fiberglass 6 Concrete tile 7 PVC 8 RMP (SR) 9 ABS 10 Asbestos-cement 11 Other (specify) 12 None used (open hole)

SCREEN OR PERFORATION OPENINGS ARE: 1 Continuous slot 2 Louvered shutter 3 Mill slot 4 Key punched 5 Gauzed wrapped 6 Wire wrapped 7 Torch cut 8 Saw cut 9 Drilled holes 10 Other (specify) 11 None (open hole)

SCREEN-PERFORATED INTERVALS: From 17' ft. to 7' ft. GRAVEL PACK INTERVALS: From 17' ft. to 7' ft.

GROUT MATERIAL: 1 Neat cement 2 Cement grout 3 Bentonite 4 Other

Grout intervals: From 7' ft. to 5' ft. From 5' ft. to 0' ft.

What is the nearest source of possible contamination: 1 Septic tank 2 Sewer lines 3 Watertight sewer lines 4 Lateral lines 5 Cess pool 6 Seepage pit 7 Pit privy 8 Sewage lagoon 9 Feedyard 10 Livestock pens 11 Fuel storage 12 Fertilizer storage 13 Insecticide storage 14 Abandoned water well 15 Oil well/Gas well 16 Other (specify below)

Direction from well? FROM TO LITHOLOGIC LOG FROM TO PLUGGING INTERVALS

0 5 Clay, Silty, gray-brown, to moist

5 17 Sand, fine to coarse grained unconsolidated, wet

7 CONTRACTOR'S OR LANDOWNER'S CERTIFICATION: This water well was (1) constructed, (2) reconstructed, or (3) plugged under my jurisdiction and was completed on (mo/day/year) 2/17/98 and this record is true to the best of my knowledge and belief. Kansas Water Well Contractor's License No. 585 This Water Well Record was completed on (mo/day/yr) 2/20/98 under the business name of AEI by (signature) [Signature]

INSTRUCTIONS: Use typewriter or ball point pen. PLEASE PRESS FIRMLY and PRINT clearly. Please fill in blanks, underline or circle the correct answers. Send top three copies to Kansas Department of Health and Environment, Bureau of Water, Topeka, Kansas 66620-0001. Telephone: 913-296-5545. Send one to WATER WELL OWNER and retain one for your records. PAGE 46

24TH STREET

VACANT GRASS LOT

PRESTO #18 SITE

5

30

4

1

4

1

/

:

100

1



FORMER
BUILDING

WASHINGTON STREET

PROJ.# 17102244

PAGE#

SCALE: AS SHOWN

DRAWN BY: RAB

FILE NO. 2244-F1

DESIGNED BY:

DATE: 7/13/04

APPROVED BY:


Terranext

FIGURE 1
SITE BASE MAP

PRESTO #18
2401 WASHINGTON
GREAT BEND, KANSAS

LEGEND

- MONITORING WELL
- ◎ PUBLIC WATER SUPPLY WELL
- SOIL VAPOR EXTRACTION WELL
- ▲ AIR SPARGE WELL
- AIR SPARGE PIPING

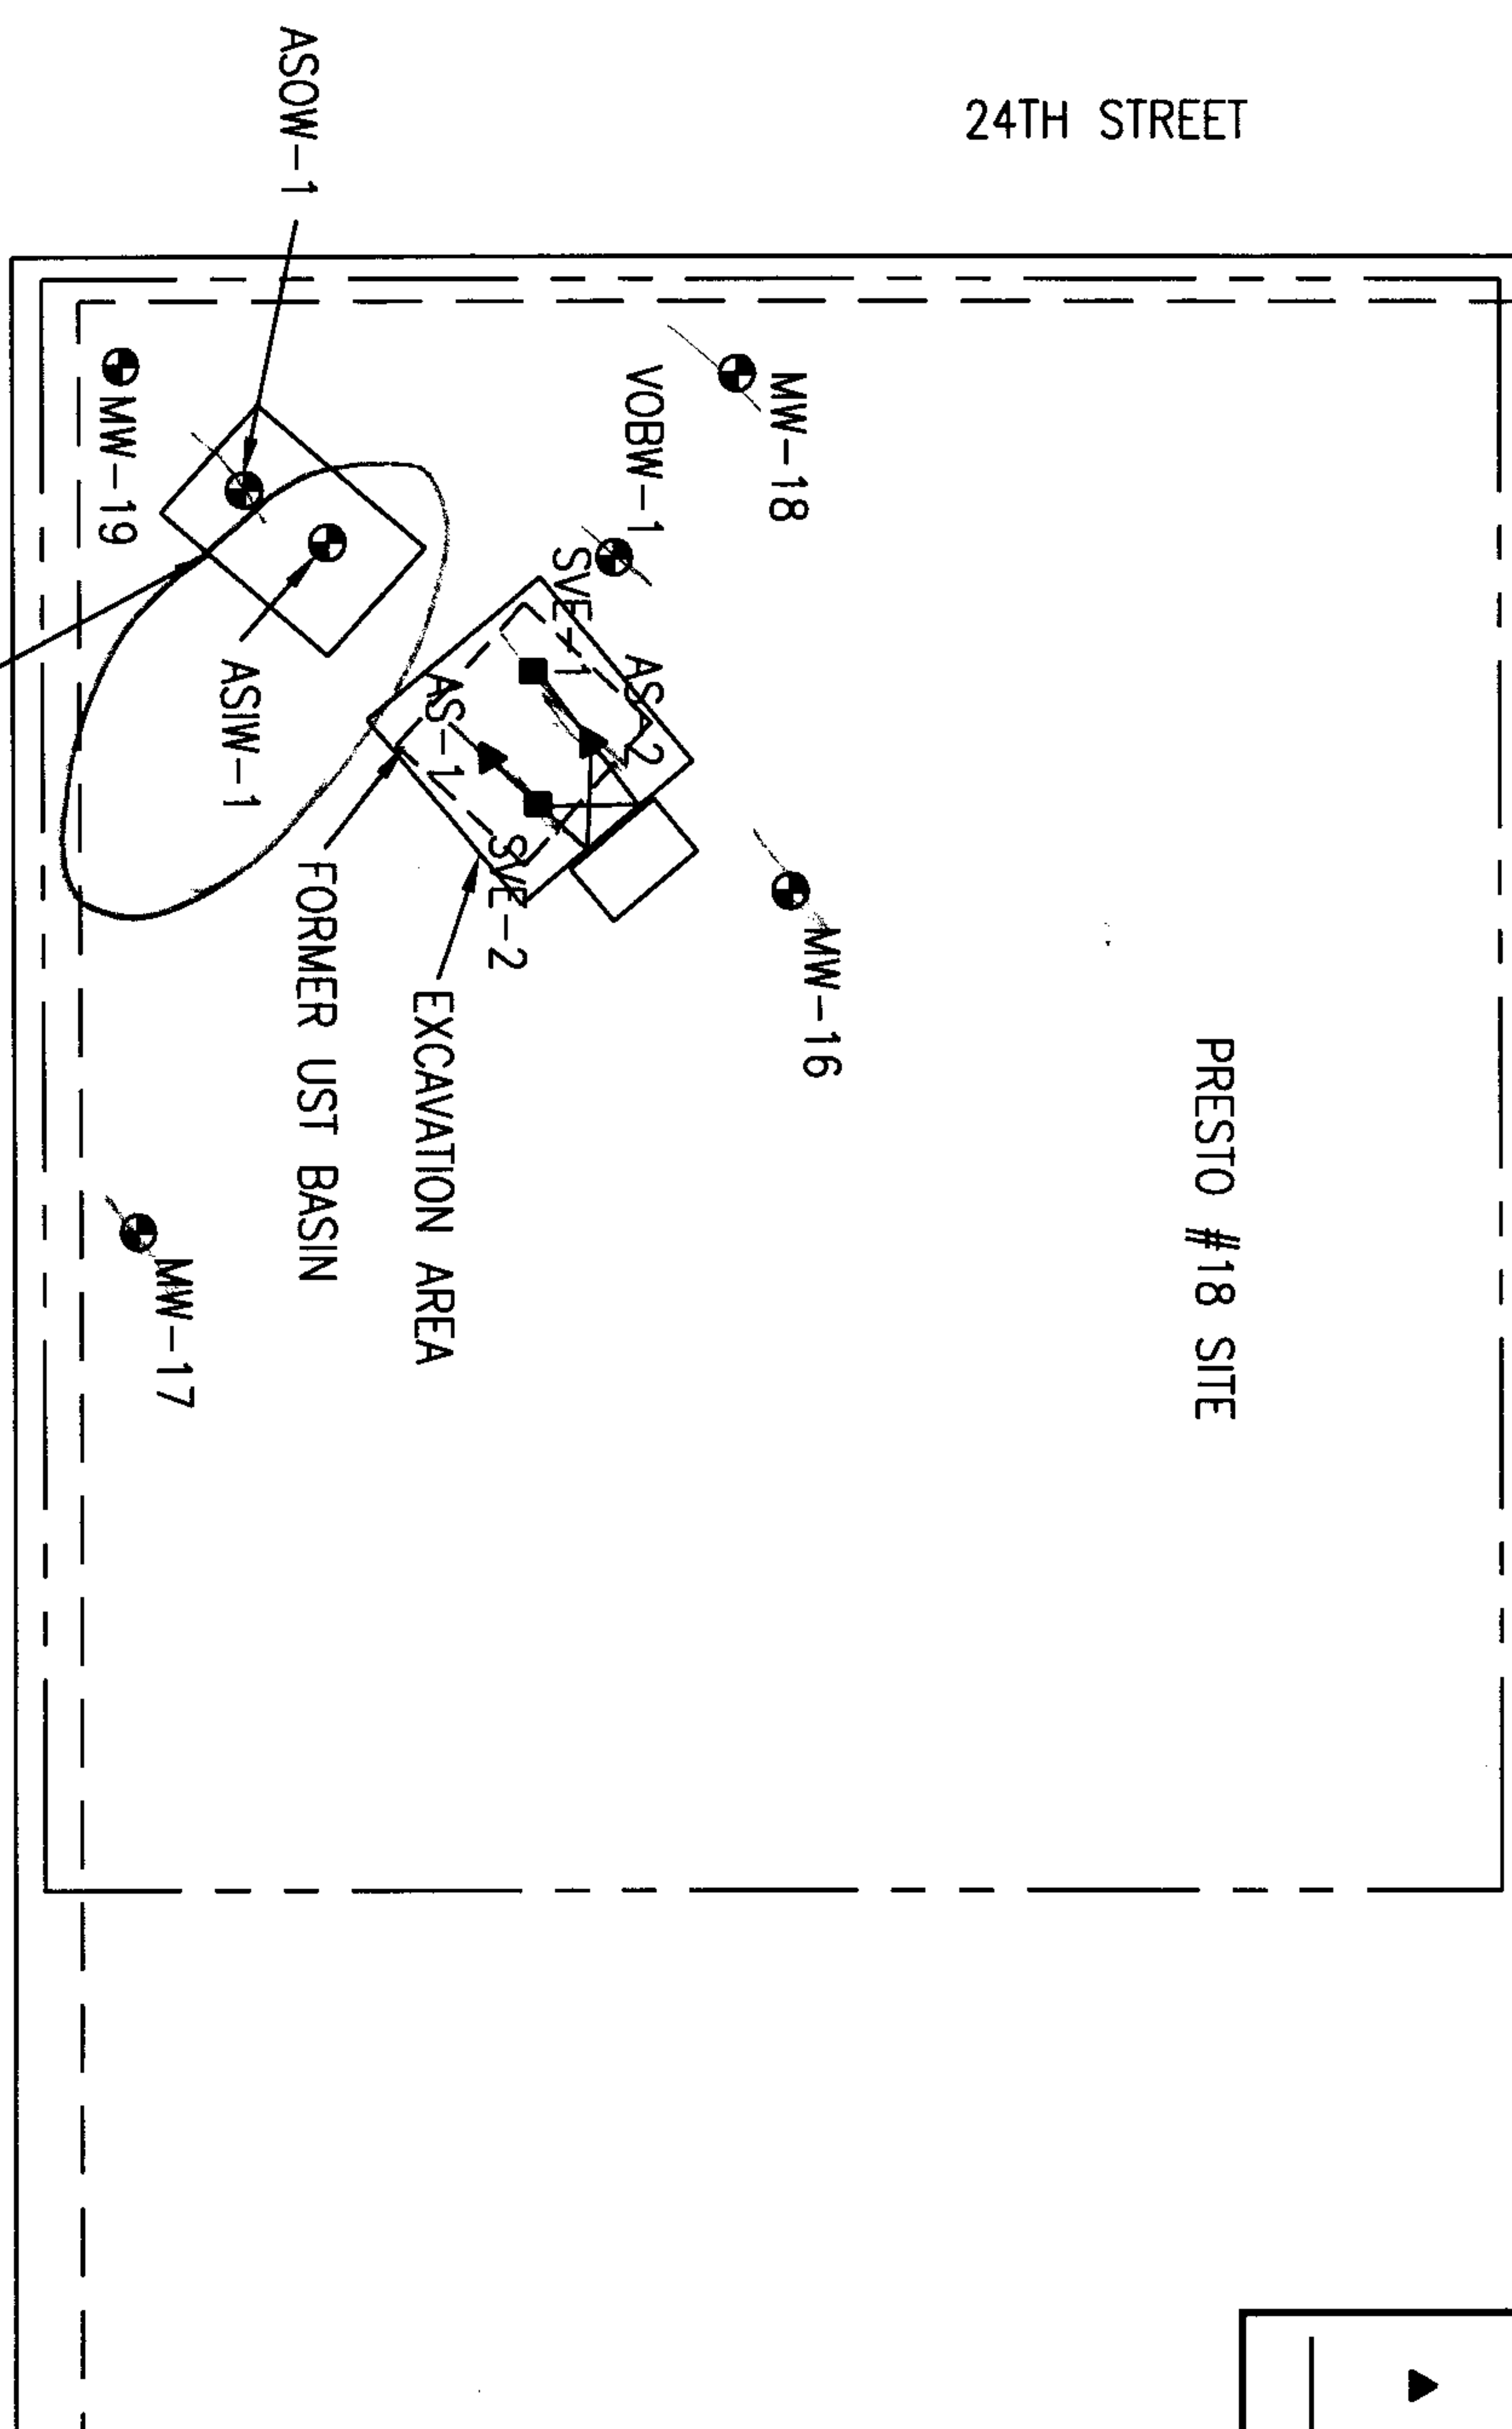

1631 200th Ave.
P.O. Box 1393
Hays, Kansas 67601
(785) 628-3219
(785) 628-2132 Fax
(785) 623-1555 Mobile
E-mail carlson@odsys.net

EVERGREEN ENVIRONMENTAL SERVICES, INC.
10553 Rene
Lenexa, Kansas 66215

March 4, 1998
#8822
page 1 of 1

SURVEYING FOR MONITORING WELLS PRESTO #18, GREAT BEND, BARTON COUNTY, KANSAS

Surveys

Land

Wells were surveyed using the existing control point on site.

Environmental

ALTA

Topography

Architectural

Platting

Construction

Preliminary

Staking

As-builts

Mapping

Site Plans


Utilities

Contours

ADDITIONAL WELLS

#	NORTH	WEST	LATITUDE D M S	LONGITUDE D M S	ELEVATION
MW 15	5405.99	105.91	38-22-37	98-46-27	1852.34 BOLT
SE-SE-SE-SE	103.85				1851.18 TOC
MW 16	5431.39	164.35	38-22-37	98-46-28	1851.67 BOLT
SE-SE-SE-SE	129.25				1851.44 TOC
MW 17	5460.84	43.22	38-22-37	98-46-27	1852.27 BOLT
SE-SE-SE-SE	158.70				1851.77 TOC
MW 18	5356.44	121.21	38-22-36	98-46-28	1851.92 BOLT
SE-SE-SE-SE	54.30				1851.67 TOC
MW 19	5360.95	52.18	38-22-36	98-46-27	1852.16 BOLT
SE-SE-SE-SE	58.81				1851.30 TOC

NOTE: Wells are in Sec 20 T19S R13W.

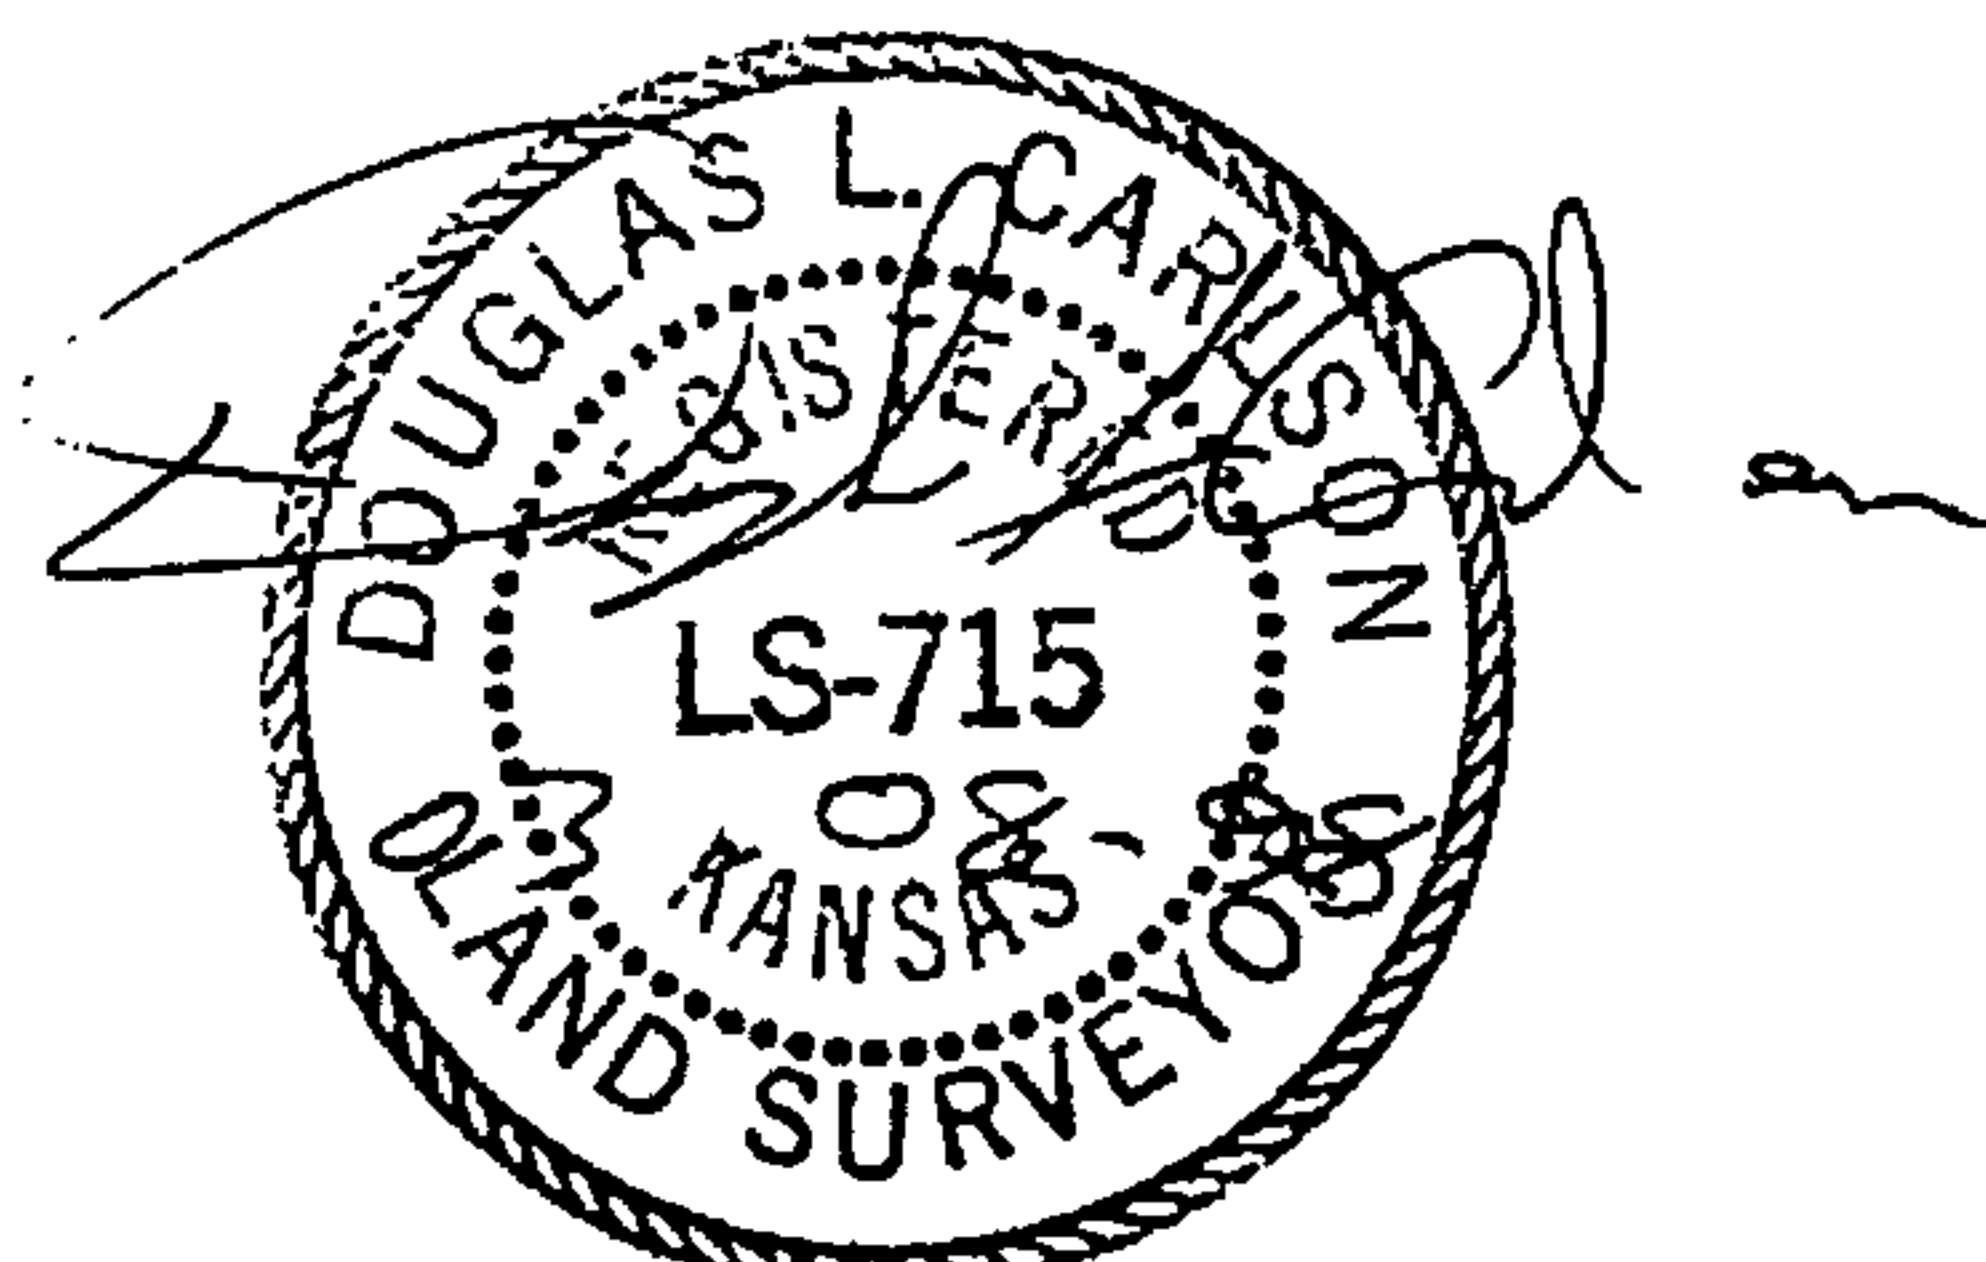

Douglas L. Carlson
Kansas Reg. No. 715