


WATER WELL R ☐ Original Record ☐		** ** C-3	0002			on of Water	1		Well ID		
	<u> </u>	ge in Well Use Fraction				rces App. No		arrachia Manah		n an Mumban	
1 LOCATION OF WATER WELL: County:		1/4 1/4	1/4	Section Number		10	Township Number T S		Range Number R □ E □ W		
2 WELL OWNER: La	First:	1/4		Duro1	al Address where well is located (if unknown, distance and						
Business:											
Address:	direction from nearest to will of intersection). If at a willer is address, effect from										
Address:											
City:	State:	ZIP:				Т					
3 LOCATE WELL	4 DEPTH OF COM		ft. 5 Latitude:(decimal degrees					(decimal degrees)			
WITH "X" IN	Depth(s) Groundwater Encountered: 1)				ft. Longitude:(decimal degrees)						
SECTION BOX:	2) ft. 3) ft., or 4) 🗆 I										
11	WELL'S STATIC WATER LEVEL:				ft. Source for Latitude/Longitude:						
	below land surface, measured on (mo-day-yr					GPS (unit make/model:)					
NW NE	above land surface, measured on (mo-day-yr)				(No)	
	Pump test data: Well w		☐ Land Survey ☐ Topographic Map								
W E	after hours Well w			☐ Online Mapper:							
SW SE	after hours										
	Estimated Yield:		81			6 Elevation:ft. ☐ Ground Level ☐ TOC					
S	Bore Hole Diameter:	. ft. and	and Source: Land Survey GPS								
mile	in. to ft.					☐ Other					
7 WELL WATER TO BE USED AS:											
1. Domestic:		ter Supply: well I						Water Supply: 16			
Household	6. Dewaterin										
☐ Lawn & Garden ☐ Livestock	7. Aquifer Re										
2. Irrigation	8. Monitoring										
3. ☐ Feedlot	9. Environmental Remediation: well ID ☐ Air Sparge ☐ Soil Vapor Extra ☐ Soil Vapor ☐ Soil ☐ Soi				•••	a) Closed Loop ☐ Horizontal ☐ Vertical b) Open Loop ☐ Surface Discharge ☐ Inj. of Water					
4. ☐ Industrial	☐ Recovery		_					cify):			
Was a chemical/bacteriological sample submitted to KDHE? ☐ Yes ☐ No If yes, date sample was submitted:											
Water well disinfected? Yes No											
8 TYPE OF CASING USED: Steel PVC Other											
Casing diameter in. to											
Casing height above land surface											
TYPE OF SCREEN OR PERFORATION MATERIAL:											
☐ Steel ☐ Stainless Steel ☐ Fiberglass ☐ PVC ☐ Other (Specify)											
☐ Brass ☐ Galvanized Steel ☐ Concrete tile ☐ None used (open hole)											
SCREEN OR PERFORATION OPENINGS ARE:											
☐ Continuous Slot ☐ Mill Slot ☐ Gauze Wrapped ☐ Torch Cut ☐ Drilled Holes ☐ Other (Specify)											
□ Louvered Shutter □ Key Punched □ Wire Wrapped □ Saw Cut □ None (Open Hole)											
SCREEN-PERFORATED INTERVALS: From											
9 GROUT MATERIAL: Neat cement Cement grout Bentonite Other											
Nearest source of possible		10., 1 10111				10., 1 10111 .		11. 10			
☐ Septic Tank	☐ Lateral Line	es 🔲 Pit Pri	ivy		☐ Li	ivestock Pen	S	☐ Insection	cide Storage	2	
☐ Sewer Lines	☐ Cess Pool	☐ Sewag				uel Storage		☐ Abando	oned Water	Well	
☐ Watertight Sewer Lin					☐ Fe	ertilizer Stor	age	☐ Oil We	ll/Gas Well		
	• • • • • • • • • • • • • • • • • • • •										
Direction from well?			om we							IC INTERMALC	
10 FROM TO	LITHOLOG	JIC LUG		FROM	L	TO 1	LITHU	. LOG (cont.) of	PLUGGIN	IG INTERVALS	
				Notes:							
				1							
11 CONTRACTOR'S OR LANDOWNER'S CERTIFICATION: This water well was constructed, reconstructed, or plugged											
under my jurisdiction and was completed on (mo-day-year)											
Kansas Water Well Con	tractor's License No	Thi	s Wat	er Well I	Recor	rd was com	pleted	on (mo-day-y	ear)		
under the business name of Send one copy to WATER WELL OWNER and retain one for your records. Fee of \$5.00 for each constructed well.											
	Send one copy to WATER WELL OWNER and retain one for your records. Fee of \$5.00 for each constructed well. KS Department of Health and Environment, Bureau of Water, Geology Section, 1000 SW Jackson St., Suite 420, Topeka, Kansas 66612-1367. Telephone 785-296-3565.										

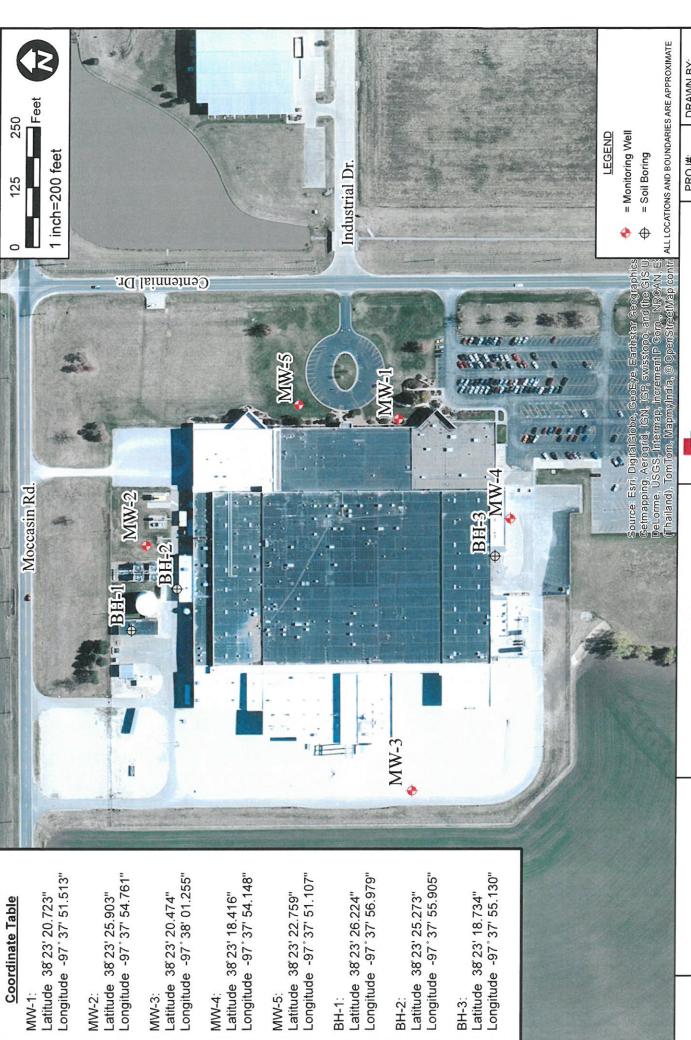

FIGURE

SAMPLE LOCATION MAP

1776 Industrial Drive McPherson, KS

Wichita, KS 67210 316-554-0725

4503 East 47th Street South

PROJ.MANGR: D. ROY DRAWN BY: C.DREYER DATE: 04/25/2016 PROJ#: 167064