


WATER WELI	RECORD Form	WWC-5	Div	vision of Water	r '	MW20		
Original Record	Correction	nge in Well Use	Res	ources App. N	o.	Well ID		
1 LOCATION OF	WATER WELL:	Fraction	Sec	tion Numbe	r Township Numl	per Range Number		
County: McPhe		NE 1/4 SW 1/4 NE 1/4	SE 1/4	29	T 19 S	R 3 DE W		
2 WELL OWNER: Last Name: First: Street or Rural Address where well is located (if unknown, distance and								
Business: Mid Ka	nsas Coop	T tist.				er's address, check here:		
Address: PO Bo								
Address: ~65' N & 7' E of NE corner of Walnut & Sutherland, McPhers								
City: Moundridge State: KS ZIP: 67107								
3 LOCATE WELL			120 0		38 367	13		
WITH "X" IN		MPLETED WELL:						
SECTION BOX:	SECTION BOX: Depth(s) Groundwater Encountered: 1)							
2)								
		ce, measured on (mo-day						
NW NE	above land surface, measured on (mo-day-yz			A DE A BERNESE DESIGNATION OF THE PARTY OF T				
				■ Land Survey ☐ Topographic Map				
Well content one				om Online Mapper:				
after hours pumping						t. Ground Level X TOC		
S Bore Hole Diameter: 9 in. to 120			ft and	Source: Land Survey GPS Topographic Map				
1 mile  Solve Hole Diameter:								
7 WELL WATER TO BE USED AS:								
1. Domestic:		Votor Cumples well ID		10 🗆 🗠	Field Water Cumples 1	Pace		
1. Domestic: 5. ☐ Public Water Supply: well ID								
☐ Lawn & Garden ☐ Livestock  7. ☐ Aquifer Recharge: well ID				12. Geothermal: how many bores?				
2.   Irrigation   9. Environmental Remediation: well ID								
3. Feedlot Soil Vapor Extraction Soil Vapor								
					13. Other (specify):			
Was a chemical/bacteriological sample submitted to KDHE?  Yes No If yes, date sample was submitted:								
Water well disinfected?  Yes No								
8 TYPE OF CASING USED: ☐ Steel ■ PVC ☐ Other								
Casing diameter								
Casing diameter 4 in to 90 ft., Diameter in to ft., Diameter in to ft., Diameter in to ft. Casing height above land surface -6.24 in Weight lbs./ft. Wall thickness or gauge No. Sch. 80								
TYPE OF SCREEN OR PERFORATION MATERIAL:								
☐ Steel ☐ Stainless Steel ☐ Fiberglass ☐ PVC ☐ Other (Specify)								
☐ Brass ☐ Galvanized Steel ☐ Concrete tile ☐ None used (open hole)								
SCREEN OR PERFORATION OPENINGS ARE:								
☐ Continuous Slot								
☐ Louvered Shutter ☐ Key Punched ☐ Wire Wrapped ☐ Saw Cut ☐ None (Open Hole)								
SCREEN-PERFORATED INTERVALS: From .90 ft. to .120 ft., From ft. to ft. to ft.								
GRAVEL PACK INTERVALS: From								
9 GROUT MATERIAL:  Neat cement  Cement grout  Bentonite  Other Concrete								
Grout Intervals: From 0 ft. to 0.5 ft., From 0.5 ft. to 85 ft., From ft. to ft.								
Nearest source of possible contamination:								
☐ Septic Tank ☐ Lateral Lines ☐ Pit Privy ☐ Livestock Pens ☐ Insecticide Storage								
☐ Sewer Lines ☐ Cess Pool ☐ Sewage Lagoon ☐ Fuel Storage ☐ Abandoned Water Well								
☐ Watertight Sewer Lines ☐ Seepage Pit ☐ Feedyard ☐ Fertilizer Storage ☐ Oil Well/Gas Well								
Other (Specify)								
Direction from well?								
10 FROM TO		OGIC LOG	FROM			r PLUGGING INTERVALS		
0 2	Clay, silty, Dark Bro		100		Sand, f-m, few Gra			
2 10	Clay, silty, Lt. Brown		110		Sand, m-c, some g			
10 22	Clay, Sitty, Et. Brown to T		110	,	Julia, III of Sollie A			
	Silt, clayey, some f		-			· · · · · · · · · · · · · · · · · · ·		
42 50	Sand, f-c, some Brn							
50 55		Silt, clayey, Gray, some f sand						
55 62	Clay, alternating Gray & Med. Brn layers Notes:							
62 75 Silt, clayey, Gray, some sand layers								
75 100 Sand, m-c								
11 CONTRACTOR'S OR LANDOWNER'S CERTIFICATION: This water well was constructed, reconstructed, or plugged								
under my jurisdiction and was completed on (mo-day-year) .1/13/2020 and this record is true to the best of my knowledge and belief.								
Kansas Water Well Contractor's License No. 527 This Water Well Record was completed on (mg-day-year) 2/5/2020								
under the business name of GeoCore, LLC Signature								
Mail I white copy along with a fee of \$5.00 for each constructed well to: Kansas Department of Health and Environment, Bureau of Water, GWTS Section,								
Mail I white cop	y along with a fee of \$5.00 for	each constructed well to: Ka	nsas Departmen	t of Health and	Environment, Bureau of V	Vater, GWTS Section,		
Mail I white cop	y along with a fee of \$5.00 for on St., Suite 420, Topeka, Kans	each constructed well to: Ka	nsas Departmen	t of Health and incr and retain or	Environment, Bureau of V	Vater, GWTS Section,		

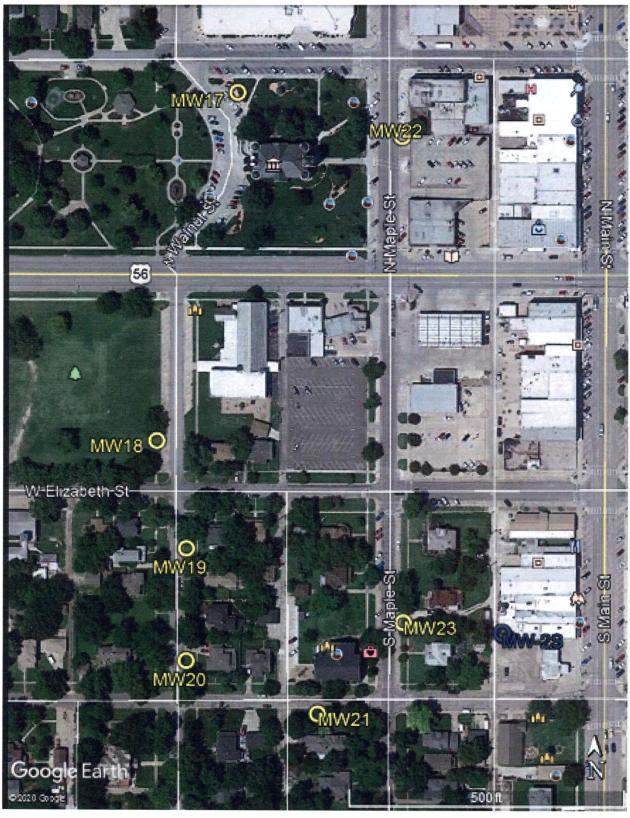

Mid Kansas Coop, McPherson 100 S. Maple, McPherson

## **GPS Coordinates**:

MW17: 38.37023, -97.66921 MW18: 38.36852, -97.66972 MW19: 38.36798, -97.66953 MW20: 38.36743, -97.66954 MW21: 38.36716, -97.66870 MW22: 38.37005, -97.66819 MW23: 38.36761, -97.66818