
Revision

		RECORD		WWC-5	1	Division of Wa	ter			MW21	
Original Record Correction Change in We					Resources App. No.				Well ID		
1 LOCAT	TON OF V	VATER WE	LL:	Fraction	1 1	Section Numb	per 1	Township Numb		ige Number	
	: McPhers		NW 1/4 SE 1/4 NE 1/4		29		T 19 S		□ E B W		
2 WELL OWNER: Last Name: First:						Street or Rural Address where well is located (if unknown, distance and					
Business: Mid Kansas Coop Address: PO Box D						direction from nearest town or intersection): If at owner's address, check here:					
Address:						~110' W & 12' S of SW corner of Maple & Sutherland, McPherson					
City: Moundridge State: KS ZIP: 67107										-,	
3 LOCATI	E WELL				420			20 2074	<u> </u>		
WITH "X" IN SECTION BOX. 4 DEPTH OF COMPLETED WELL: Depth(s) Groundwater Encountered: 1)											
1	2)										
WELL'S STATIC WATER LEVEL:9.2.;								Datum: WGS 84		83 ⊔ NAD 27	
below land surface, m								atitude/Longitude		,	
above land sur			land surface,	measured on (mo-day-		☐ GPS (unit make/model:) (WAAS enabled? ☐ Yes ☐ No)					
Pump test of			test data: Well water was ft.			i 📵	■ Land Survey ☐ Topographic Map				
W	W E afterhou			pumping		Online Mapper:					
sw	SWSE Well v			ater was							
alter			hours	pumping	gpm	6 Elev	6 Elevation: 14.98,22.ft. Ground Level X TOC				
	Estimated Yield			gpm 9in. to 120	ft and	and Source: Land Survey GP			TO CIOUNO	phographic Man	
							Other				
7 WELL WATER TO BE USED AS:											
1. Domestic:				ter Supply: well ID		10. 🗆 0)il Field	Water Supply: Je	ase		
☐ Housel	☐ Household 6. ☐ Dewaterin				g: how many wells?			10. Oil Field Water Supply: lease			
	☐ Lawn & Garden 7. ☐ Aquifer R			echarge: well IDg: well ID	□ 0		Uncased (
	☐ Livestock 8. ■ Monitoring				V21	12. Geot		how many bores			
	2. Irrigation 9. Environmental Remediation: well							oop 🗌 Horizont			
				□ Soil Vapor I	oil Vapor Extraction b) Open Loop Surface Disch				scharge 🗌	Inj. of Water	
			Recovery					ecify):			
Was a chemical/bacteriological sample submitted to KDHE? Yes No If yes, date sample was submitted:											
Water well disinfected? ☐ Yes ■ No											
8 TYPE OF CASING USED: Steel PVC Other CASING JOINTS: Glued Clamped Welded Threaded											
Casing diameter 4 in to 90 ft., Diameter in to ft., Diameter in to ft. Casing height above land surface 6 in. Weight 15s./ft. Wall thickness or gauge No. Sch 80											
TVPF OF S	CPEEN O	R PERFORA	TION MA	. weight	IDS./I	t. Wall thic	kness of	r gauge NoQUI	.Ο.V		
☐ Steel		inless Steel				П.О.	har (Cna	no:Gu)			
☐ Steel ☐ Stainless Steel ☐ Fiberglass ☐ PVC ☐ Other (Specify)											
SCREEN OR PERFORATION OPENINGS ARE:											
☐ Continuous Slot											
☐ Louve	red Shutter	☐ Key Pund	ched W	ire Wrapped Sa	w Cut	None (Open I	Hole)				
SCREEN-P	ERFORAT	ED INTERV	ALS: From	. 90 ft. to 120	ft. Fron	n ft. t	0	ft., From	ft. to	ft.	
SCREEN-PERFORATED INTERVALS: From90											
19 GROUT	MATERI	AL: Neat	cement	Cement grout Fig. Be	ntonite 🖺	Other Conc	rete				
Grout Interva	als: From	ft. t	oU.5	. ft., From . 0.5.	ft. to8	7 fl., From	١	ft. to	ft.		
Nearest sour	rce of possib	le contaminat	ion:								
☐ Septic 7			Lateral Line			Livestock Po			ide Storage	i	
-			Cess Pool	Sewage La	-	Fuel Storage			ned Water V	Nell	
	☐ Watertight Sewer Lines ☐ Seepage Pit ☐ Feedyard ☐ Fertilizer Storage ☐ Oil Well/Gas Well ☐ Other (Specify)										
Direction from well? Distance from well? ft.											
10 FROM	TO		LITHOLOC	SIC LOG	FROM		LITH). LOG (cont.) or	PLUGGING	INTERVALS	
0	2	Silt, clayey,			82			f-c, gray clay			
2		Clay, some					Janu,	. o, gray clay s	Sa Cars Ju	100	
4		Sand and S			1						
10		Silt, clayey.			1						
12				t. Brn clay layers	 			······································			
23		Silt, clayey,		Dili olay layers							
28		Clay, silty, L			Notes:	1	Les er e				
32 45 Clay, Lt. Brown, gray clay layer											
		Clay, Gray			1						
11 CONTRACTOR'S OR LANDOWNER'S CERTIFICATION: This water well was constructed, reconstructed, or plugged											
under my jurisdiction and was completed on (mo-day-year) 1/11/2020 and this record is true to the best of my knowledge and belief.											
Kansas Water Well Contractor's License No. 527 This Water Well Record was completed on (mo-day-year) 2/5/2020 under the business name of GeoCore, LLC											
under the b	usiness nam	e of GeoCo	oreLLC			Signature	1.14.1	2 MD			
				h constructed well to: Kar							
		st., Suite 420, To s.gov/waterwell/		56612-1367. Mail one to			one for yo	our records. Telepho			
- visit us at ntth	nn www.kanek	a. gov/ waterwell/	mucx.nml		KSA 82a-	1414			Revised	7/10/2015	

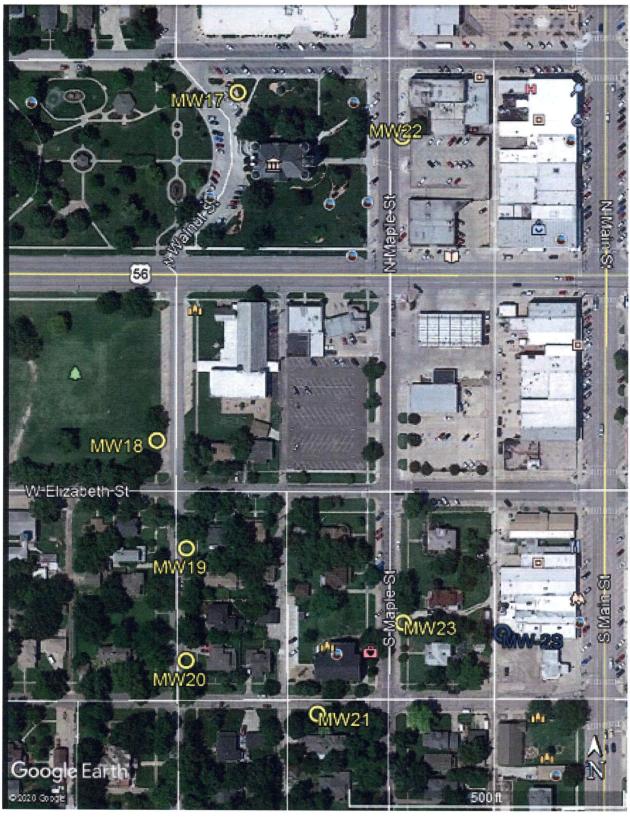

Mid Kansas Coop, McPherson 100 S. Maple, McPherson

GPS Coordinates:

MW17: 38.37023, -97.66921 MW18: 38.36852, -97.66972 MW19: 38.36798, -97.66953 MW20: 38.36743, -97.66954 MW21: 38.36716, -97.66870 MW22: 38.37005, -97.66819 MW23: 38.36761, -97.66818