
Revision

WATER WELL	RECORD	Form V	WC-5	Di	vision of Wat	ter			MW22		
Original Record (ources App.			Well ID	111122		
1 LOCATION OF	WATER WEI	LL:	Fraction		ction Numb		ownship Numb	er Rar	ge Number		
County: McPher	NE ¼ 29 T 19 S R 3 □ E ■ W										
2 WELL OWNER:	Last Name:		First:	treet or Rural Address where well is located (if unknown, distance and							
Business: Mid Kar	direction from nearest town or intersection): If at owner's address, check here:										
Address: PO Box	~110' S & 5' W of SE corner of Maple & Marlin, McPherson										
Address: City: Moundri	daa	State: KS	i i	-110 0 0 0	VVOISE	COMIC	OI Maple & M	armi, wich	11613011		
3 LOCATE WELL											
WITH "X" IN			PLETED WELL:								
SECTION BOX:			ncountered: 1)								
N	2)	H. 3)	ER LEVEL:	Dry Well					83 📙 NAD 27		
			measured on (mo-day-		2 1/2 1						
NWNE			neasured on (mo-day-)								
11 11 11			ter was ft		Ma Land Survey ☐ Topographic Map						
W X	E after hours pumping				Online Mapper:						
SW SE	Well water was ft.										
	after hours pumping					ation:	1499.88 A	C Ground	I aval MTOC		
S	Bore Hole	Δ3									
1 mile											
7 WELL WATER TO BE USED AS:											
1. Domestic:			er Supply: well ID		10. 🗀 0	il Field	Water Supply: le	ase			
☐ Household	☐ Household 6. ☐ Dewatering: how many wells?										
Lawn & Garden	☐ Lawn & Garden 7. ☐ Aquifer Recharge: well ID					ased [☐ Uncased ☐ C	Scotechnica	1		
TOO IN COMMON MARKET	☐ Livestock 8. Monitoring: well ID					thermal:	how many bores	?			
	2. ☐ Irrigation 9. Environmental Remediation: well ID 3. ☐ Feedlot ☐ Air Sparge ☐ Soil Vapor E						oop Horizont				
3. ☐ Feedlot 4. ☐ Industrial	xtraction	b) Open Loop Surface Discharge Inj. of Water									
Was a chemical/bacteriological sample submitted to KDHE? Yes No If yes, date sample was submitted:											
Water well disinfected? Yes No											
8 TYPE OF CASING USED: Steel PVC Other CASING JOINTS: Glucd Clamped Welded Threaded											
Casing diameter 4 in. to 90 ft., Diameter in. to ft., Diameter in. to ft. Casing height above land surface 4.92 in. Weight lbs./ft. Wall thickness or gauge No. Sch 80											
Casing height above land surface											
☐ Steel ☐ Stainless Steel ☐ Fiberglass ☐ PVC ☐ Other (Specify)											
☐ Brass ☐ Galvanized Steel ☐ Concrete tile ☐ None used (open hole)											
SCREEN OR PERFORATION OPENINGS ARE:											
☐ Continuous Slot ■ Mill Slot ☐ Gauze Wrapped ☐ Torch Cut ☐ Drilled Holes ☐ Other (Specify)											
Louvered Shutter											
SCREEN-PERFORATED INTERVALS: From .90 ft. to .120 ft., From											
GRAVEL PACK INTERVALS: From											
9 GROUT MATERIAL: Neat cement Coment grout Bentonite Concrete											
Grout Intervals: From 0 ft. to 0.5 ft., From 0.5 ft. to 87 ft., From ft. to ft.											
Nearcst source of possible contamination: Septic Tank											
Sewer Lines		Cess Pool	☐ Sewage Lag		Fuel Storage		☐ Abando		Well		
☐ Watertight Sewer Lines ☐ Seepage Pit ☐ Feedyard ☐ Fertilizer Storage ☐ Oil Well/Gas Well											
☐ Other (Specify) Direction from well? Distance from well? ft.											
Direction from well?											
10 FROM TO		LITHOLOG		FROM	TO). LOG (cont.) or				
0 1	Clay, silty, D		· · · · · · · · · · · · · · · · · · ·	100			f-m, some Gra		y		
1 3	Clay, Grayis			108	120	Sand,	c, w/some f-m				
3 4	Clay, Lt. Bro										
4 10		Clay, Med. Brown, few thin f sand streaks									
10 14		Clay, Lt. Brown, few thin f sand streaks									
14 22		Clay, intbd Gray & Lt. Brown layers			L	l					
22 62		Clay, Tan, few sand streaks, some silt							1		
62 85 Clay, intbd Gray & Lt. Brown layers									ļ		
85 100 Sand, c, some Gray clay streaks											
11 CONTRACTOR'S OR LANDOWNER'S CERTIFICATION: This water well was constructed, reconstructed, or plugged under my jurisdiction and was completed on (mo-day-year) .1/10/2020 and this record is true to the best of my knowledge and belief.											
Kansas Water Well Contractor's License No. 527 This Water Well Record was completed on (mozdag-year) 2/5/2020											
under the business name of GeoCore, LLC Signature											
under the business name of GeoCore. LLC Mail I white copy along with a fee of \$5.00 for each constructed well to: Kansas Department of Health and Environment, Bureau of Water, GWTS Section,											
1000 SW Jackson	St., Suite 420, To	peka, Kansas 6	5612-1367. Mail one to W	Vater Well Own	ner and retain o	one for yo	our records. Telepho	one 785-296-	5524.		
Visit us at http://www.kdheks.gov/waterwell/index.html KSA 82a-1212 Revised 7/10/2015											

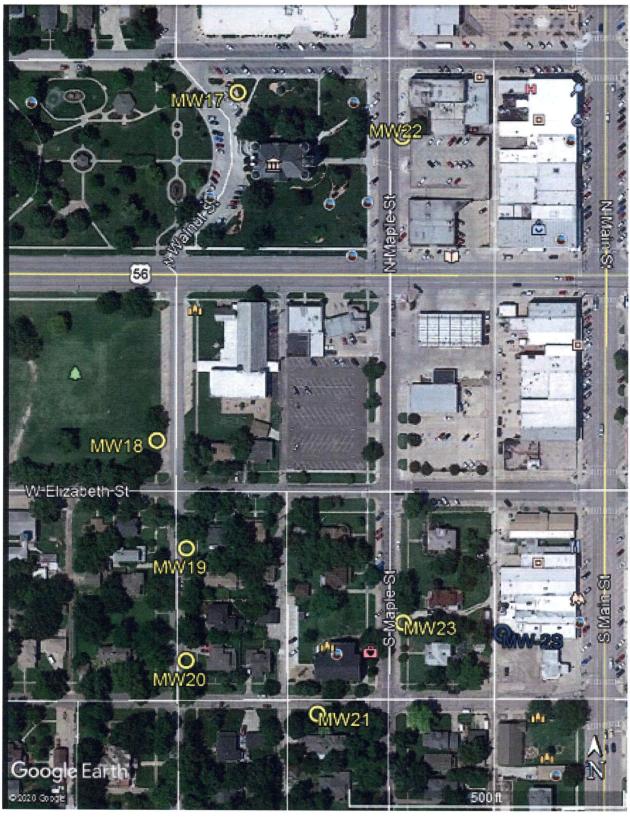

Mid Kansas Coop, McPherson 100 S. Maple, McPherson

GPS Coordinates:

MW17: 38.37023, -97.66921 MW18: 38.36852, -97.66972 MW19: 38.36798, -97.66953 MW20: 38.36743, -97.66954 MW21: 38.36716, -97.66870 MW22: 38.37005, -97.66819 MW23: 38.36761, -97.66818