
Revision

WATER WEI		Form W			ision of Water		MW18	
	d K. Correction				ources App. No		Well ID	
1 LOCATION (			raction		tion Number 29	Township Numb	per Range Number R 3 □ E ■ W	
2 WELL OWNER: Last Name: First: Street or Rural Address where well is located (if unknown, distance and direction from nearest town or intersection): If at owner's address, check here:								
Address: PO								
Address:	JOX D		,	~75' N & 25	75' N & 25' W of NW corner Walnut & Elizabeth Sts.,			
City: Moundridge State: KS ZIP: 67107 McPherson								
3 LOCATE WELL 4 DEPTH OF COMPLETED WELL: 120 ft. 5 Latitude: 38.36852 (decimal degrees)								
WITH "X" IN	Donth(a) C		countered: 1)		Langit	-97 669	972(decimal degrees)	
SECTION BOX			ft., or 4) [					
N	WELL'S S	STATIC WATE	R LEVEL:9.4.1.	Q ft. ,	\$ Source for Latitude/Longitude:			
	below	land surface, m	casured on (mo-day	-yr). 2.15-19	). 245			
NW NE	above land surface, measured on (mo-day-yr					(WAAS enabled?		
	Pump test data: Well water was ft.					d Survey   Topogr		
W T					☐ Onl	line Mapper:		
Well water was								
	Estimated Yield:gpm						. 🗌 Ground Level 🛭 TOC	
S					. fl. and Source: Land Survey GPS Topographic Map			
1 mile			in. to	ft.		☐ Other		
7 WELL WATER TO BE USED AS:								
1. Domestic:	5. [	☐ Public Water	Supply: well ID				ease	
Household	how many wells?		11. Test Hole: well ID					
☐ Lawn & Garden ☐ Livestock  7. ☐ Aquifer Recharge: well ID				N/18				
☐ Livestock 8. Monitoring: well ID					12. Geothermal: how many bores?			
2. ☐ Irrigation  9. Environmental Remediation: well ID  3. ☐ Feedlot ☐ Air Sparge ☐ Soil Vapor Ext								
4. Industrial		Recovery	☐ Injection	Lxtraction				
Was a chemical/bacteriological sample submitted to KDHE? ☐ Yes No If yes, date sample was submitted:								
8 TYPE OF CASING USED: Steel PVC Other CASING JOINTS: Glued Clamped Welded Threaded								
Casing diameter								
Casing height above land surface								
TYPE OF SCREEN OR PERFORATION MATERIAL:								
. ☐ Steel ☐ Stainless Steel ☐ Fiberglass ☐ PVC ☐ Other (Specify)								
☐ Brass ☐ Galvanized Steel ☐ Concrete tile ☐ None used (open hole)								
SCREEN OR PERFORATION OPENINGS ARE:								
☐ Continuous Slot								
Louvered Shutter								
GRAVEL PACK INTERVALS: From85 ft. to20 ft., From ft., From ft., From ft. to ft.								
9 GROUT MATERIAL: Neat cement Cement grout Bentonite Other Concrete								
Grout Intervals: From 0 ft. to 0.5 ft., From 0.5 ft. to 85 ft., From ft. to ft.								
Nearest source of possible contamination:								
Septic Tank		Lateral Lines	☐ Pit Privy		Livestock Pens	s 🔲 Insecti	cide Storage	
☐ Sewer Lines ☐ Cess Pool ☐ Sewage Lagoon ☐ Fuel Storage ☐ Abandoned Water Well								
☐ Watertight Sewer Lines ☐ Seepage Pit ☐ Feedyard ☐ Fertilizer Storage ☐ Oil Well/Gas Well								
☐ Other (Specify)								
10 FROM TO		LITHOLOGI	ULUG	FROM	TO I	LIHU, LUG (cont.) o	r PLUGGING INTERVALS	
3 20		Dark Brown						
3 20 20 55	Clay, Brow		Crov	+				
		rown w/some	Glay		<del></del>			
		Clay, some silt, Gray Sand, f-m, & Gray clay layers						
62 77		a Gray clay I	ayers		ļ			
77 85		Sand, m-c						
85 88	Sand, f-m	comp crave		Notes:	Notes:			
88 120 Sand, m-c, some gravel								
11 CONTRACTOR'S OR LANDOWNER'S CERTIFICATION: This water well was constructed, reconstructed, or plugged								
under my jurisdiction and was completed on (mo-day-year) .1/7/2020 and this record is true to the best of my knowledge and belief.								
Kansas Water Well Contractor's License No. 527 This Water Well Record was completed on (mo-day-year) 2/5/2020								
under the business name of GeoCore, LLC. Signature								
Mail 1 white copy along with a fee of \$5.00 for each constructed well to: Kansas Department of Health and Environment, Bureau of Water, GWTS Section, 1000 SW Jackson St., Suite 420, Topeka, Kansas 66612-1367. Mail one to Water Well Owner and retain one for your records. Telephone 785-296-5524.								
			612-1367. Mail one to			e for your records. Telepl	none 785-296-5524.	
Visit us at http://www.kdheks.gov/waterwell/index.html KSA 82a-1212 Revised 7/10/2015								

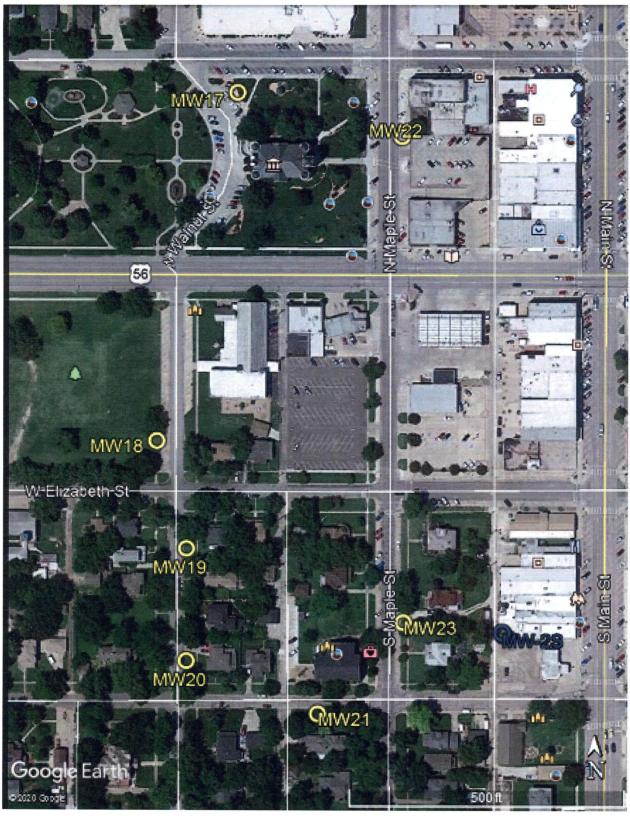

Mid Kansas Coop, McPherson 100 S. Maple, McPherson

## **GPS Coordinates**:

MW17: 38.37023, -97.66921 MW18: 38.36852, -97.66972 MW19: 38.36798, -97.66953 MW20: 38.36743, -97.66954 MW21: 38.36716, -97.66870 MW22: 38.37005, -97.66819 MW23: 38.36761, -97.66818