



WATER WELL RECORD Form WWC-5 1222172

Original Record Correction Change in Well Use

Division of Water Resources App. No.

Well ID

1 LOCATION OF WATER WELL:
County: Fraction 1/4 1/4 1/4 1/4 Section Number Township Number T S Range Number R E W

2 WELL OWNER: Last Name: First: Street or Rural Address where well is located (if unknown, distance and direction from nearest town or intersection): If at owner's address, check here:
Business: Address: Address: City: State: ZIP:

3 LOCATE WELL WITH "X" IN SECTION BOX:
N

W NW NE SE SW
E
S
-----1 mile-----

4 DEPTH OF COMPLETED WELL: ft.
Depth(s) Groundwater Encountered: 1) ft.
2) ft. 3) ft., or 4) Dry Well
WELL'S STATIC WATER LEVEL: ft.
 below land surface, measured on (mo-day-yr).....
 above land surface, measured on (mo-day-yr).....
Pump test data: Well water was ft.
after hours pumping gpm
Well water was ft.
after hours pumping gpm
Estimated Yield:gpm
Bore Hole Diameter: in. to ft. and
..... in. to ft.

5 Latitude:(decimal degrees)
Longitude:(decimal degrees)
Datum: WGS 84 NAD 83 NAD 27
Source for Latitude/Longitude:
 GPS (unit make/model:)
(WAAS enabled? Yes No)
 Land Survey Topographic Map
 Online Mapper:

6 Elevation:ft. Ground Level TOC
Source: Land Survey GPS Topographic Map
 Other

7 WELL WATER TO BE USED AS:
1. Domestic: Household Lawn & Garden Livestock
2. Irrigation
3. Feedlot
4. Industrial
5. Public Water Supply: well ID
6. Dewatering: how many wells?
7. Aquifer Recharge: well ID
8. Monitoring: well ID
9. Environmental Remediation: well ID
 Air Sparge Soil Vapor Extraction
 Recovery Injection
10. Oil Field Water Supply: lease
11. Test Hole: well ID
 Cased Uncased Geotechnical
12. Geothermal: how many bores?
a) Closed Loop Horizontal Vertical
b) Open Loop Surface Discharge Inj. of Water
13. Other (specify):

Was a chemical/bacteriological sample submitted to KDHE? Yes No If yes, date sample was submitted:
Water well disinfected? Yes No

8 TYPE OF CASING USED: Steel PVC Other **CASING JOINTS:** Glued Clamped Welded Threaded
Casing diameter in. to ft., Diameter in. to ft., Diameter in. to ft.
Casing height above land surface in. Weight lbs./ft. Wall thickness or gauge No.

TYPE OF SCREEN OR PERFORATION MATERIAL:
 Steel Stainless Steel Fiberglass PVC Other (Specify)
 Brass Galvanized Steel Concrete tile None used (open hole)
SCREEN OR PERFORATION OPENINGS ARE:
 Continuous Slot Mill Slot Gauze Wrapped Torch Cut Drilled Holes Other (Specify)
 Louvered Shutter Key Punched Wire Wrapped Saw Cut None (Open Hole)
SCREEN-PERFORATED INTERVALS: From ft. to ft., From ft. to ft., From ft. to ft.
GRAVEL PACK INTERVALS: From ft. to ft., From ft. to ft., From ft. to ft.

9 GROUT MATERIAL: Neat cement Cement grout Bentonite Other
Grout Intervals: From ft. to ft., From ft. to ft., From ft. to ft.

Nearest source of possible contamination:
 Septic Tank Lateral Lines Pit Privy Livestock Pens Insecticide Storage
 Sewer Lines Cess Pool Sewage Lagoon Fuel Storage Abandoned Water Well
 Watertight Sewer Lines Seepage Pit Feedyard Fertilizer Storage Oil Well/Gas Well
 Other (Specify)
Direction from well? Distance from well? ft.

10 FROM	TO	LITHOLOGIC LOG	FROM	TO	LITHO. LOG (cont.) or PLUGGING INTERVALS
		Notes:			

11 CONTRACTOR'S OR LANDOWNER'S CERTIFICATION: This water well was constructed, reconstructed, or plugged under my jurisdiction and was completed on (mo-day-year) and this record is true to the best of my knowledge and belief. Kansas Water Well Contractor's License No. This Water Well Record was completed on (mo-day-year) under the business name of



ASSIGNMENT OF WATER WELL TO LANDOWNER

I, K-5 Land LLC of PO Box 990
(Landowner's address)

Great Bend Kansas am the landowner on which a water well is located in
(City) (State)
the NE quarter of the NW quarter of the NW quarter in Section 12, Township 21,
Range 19 E/W, in Pawnee County, Kansas which is approximately
330 feet north/south, and 990 feet east/west of the apparent NW section
corner. The water well was drilled in September 2014 (month/year).

I hereby request that Murfin Drilling Company leave the water well,
(Operator name)

which was drilled by Temporary Water Permit # 20140831, unplugged, and I will
assume all responsibility for the plugging of said water well in accordance with the requirements
of the Kansas Department of Health and Environment regulation K.A.R. 28-30-7.

LANDOWNER:

K5 Land LLC 9/24/14
(Signature) (Date)
by: Carlos Kuhn - member - Manager
K5 Land LLC
(Print)

OPERATOR:

Christina Campbell 9/15/14
(Signature) (Date)
By: _____
(Agent)

IF ADDITIONAL LANDOWNER

(Signature) (Date)



(Print)

RECEIVED
SEP 29 2014
BUREAU OF WATER

File No. 20140831 - Temporary Water Well Location

Legend

- WIMAS_PD

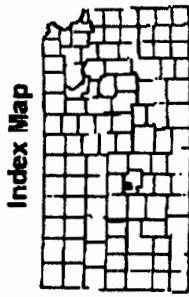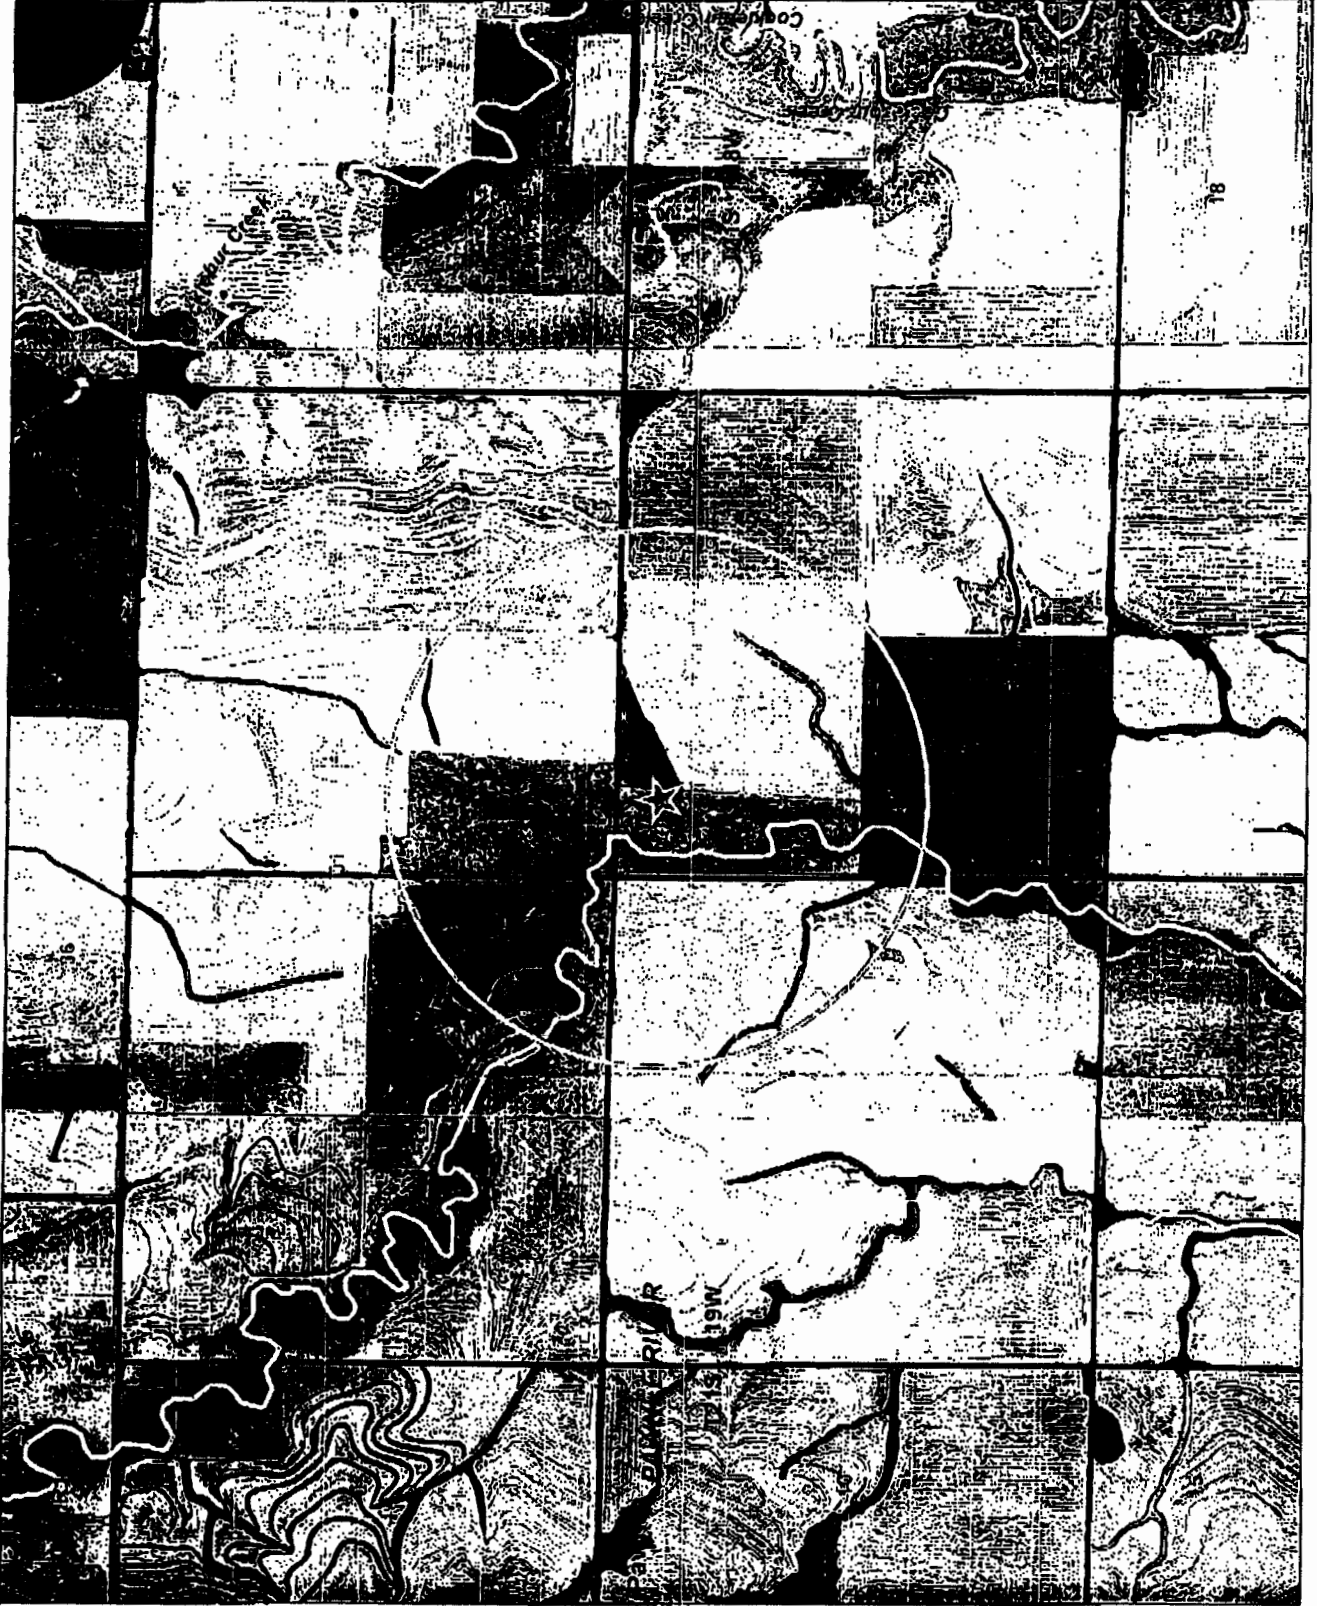

This map was created by KAK/DWR