

WATER WELL RECORD

Form WWC-5

Revised

Division of Water Resources App. No.


Well ID

MW12

Original Record Correction Change in Well Use

1 LOCATION OF WATER WELL: County McPherson Fraction NE 1/4 NW 1/4 NW 1/4 NW 1/4 Section Number 26 Township Number T 21 S Range Number R 2 E X W

2 WELL OWNER: Last Name: Business: KDHE (Convenience Mart) Address: 1000 SW Jackson Blvd City Topeka State: KS ZIP: 66612 Street or Rural Address where well is located (if unknown, distance and direction from nearest town or intersection): 100 S Wedel Ave., Moundridge KS

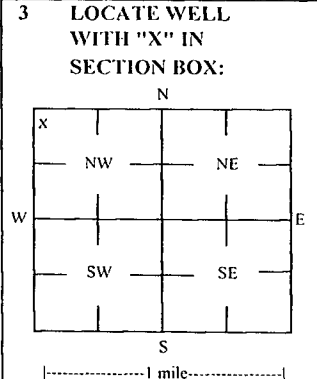

3 LOCATE WELL WITH 'X' IN SECTION BOX: 4 DEPTH OF COMPLETED WELL: 39 ft Depth(s) Groundwater Encountered: 1) 39 ft 2) 27.7 ft or 3) 27.7 ft, or 4) Dry Well WELL'S STATIC WATER LEVEL: 27.7 ft X below land surface, measured on (mo-day-yr) 10/14/21

5 Latitude: 38.20282 (decimal degrees) Longitude: 97.51781 (decimal degrees) Horizontal Datum: X WGS 84 GPS (unit make/model): Land Survey X Topographic Map

7 WELL WATER TO BE USED AS: 1 Domestic: 2 Irrigation 3 Feedlot 4 Industrial 5 Public Water Supply: well ID 6 Dewatering: how many wells? 7 Aquifer Recharge: well ID 8 X Monitoring: well ID MW12 9 Environmental Remediation: well ID 10 Oil Field Water Supply: lease 11 Test Hole: well ID 12 Geothermal: How many bores?

Was a chemical/bacteriological sample submitted to KDHE? Yes No X No If yes, date sample was submitted:

8 TYPE OF CASING USED: Steel X PVC Other CASING JOINTS: Glued Clamped Welded X Threaded Casing diameter 2 in. to 24 ft. Diameter in. to ft. Casing height above land surface -0.25 in. Weight lbs./ft. Well thickness or gauge No TYPE OF SCREEN OR PERFORATION MATERIAL: Steel Stainless Steel Fiberglass X PVC Brass Galvanized Steel Concrete tile None used (open hole) SCREEN OR PERFORATION OPENINGS ARE: Continuous Slot X Mill Slot Gauze Wrapped Torch Cut Drilled Holes Other (Specify) Louvered Shutter Key Punched Wire Wrapped Saw Cut None (Open Hole) SCREEN-PERFORATED INTERVALS: From 24 ft. to 39 ft. GRAVEL PACK INTERVALS: From 22 ft. to 39 ft.

9 GROUT MATERIAL: Neat cement Cement grout X Bentonite X Other Concrete: 0-0.7 Grout intervals: From 0.7 ft. to 22 ft. From ft. to ft. From ft. to ft.

Nearest source of possible contamination: Septic Tank Lateral Lines Pit Privy Livestock Pens Insecticide Storage Sewer Lines Cess Pool Sewage Lagoon X Fuel Storage Abandoned Water Well Watertight Sewer Lines Seepage Pit Feedyard Fertilizer Storage Oil Well / Gas Well Other (Specify) Direction from well? W Distance from well? ~175 ft

Table with 3 columns: FROM, TO, LITHOLOGIC LOG. Rows show depth intervals and lithology: 0-0.7 Topsoil, 0.7-1 Silty clay, 1-6 Clay, 6-15 Fine sand, 15-20 Sandy clay, 20-39 Mudstone.

Notes: KDHE ID: Convenience Mart; U5-059-15162 Target of monitoring well is shallow groundwater, <20' of grout was installed at the direction of KDHE.

11 CONTRACTOR'S OR LANDOWNER'S CERTIFICATION: This water well was X constructed, reconstructed or plugged under my jurisdiction and was completed on (mo-day-year) 10/12/21 and this record is true to the best of my knowledge and belief. License No 757 This Water Well Record was completed on (mo-day-year) 11/4/21 under the business name of Larsen & Associates, Inc. Signature

MEMPHIS

26-21-2W

DENNIS L HANDKE

1820 NW 59th Terrace
TOPEKA, KANSAS 66618
785-286-4047 Home

Jess Chapman
Larsen & Associates
1311 E. 25th Street, Suite B
Lawrence, Kansas 66046

October 25, 2021

RE: Monitor Well Elevation Survey
100 S. Christian Ave., Moundridge, Kansas

Proj. 21-00HH
Convenience Mart
KDHE ID U5-059-15162


Bench Mark: Chisled Sq. on North center of concrete pump island.

Elev: 1497.24	North 5301.44	West 5100.59	(from SE Cor. Sec. 26-21-2W)
MW-10 rim	1494.61	North 5243.89	NE1/4,NE1/4,NE1/4,NE1/4 (Sec. 27-21-2W)
top pipe	1494.28	West 5437.31	Lat = 38.20275 Long = 97.51964
11 MW-11 rim	1496.17	North 5209.35	NW1/4,NW1/4,NW1/4,NW1/4
top pipe	1495.88	West 5133.66	Lat = 38.20265 Long = 97.51858
12 MW-12 rim	1495.58	North 5368.27	NE1/4,NW1/4,NW1/4,NW1/4
top pipe	1495.33	West 4912.20	Lat = 38.20282 Long = 97.51781
13 MW-14 rim	1493.02	North 4998.78	NE1/4,NW1/4,NW1/4,NW1/4
top pipe	1492.72	West 4909.34	Lat = 38.20208 Long = 97.51780

Elevation derived from existing project. NAVD 88.

Lat & Long derived from Moundridge 7.5 Quad Map WGS84.

If you have any questions, please feel free to call me. Thank you for the opportunity to be of service to you.

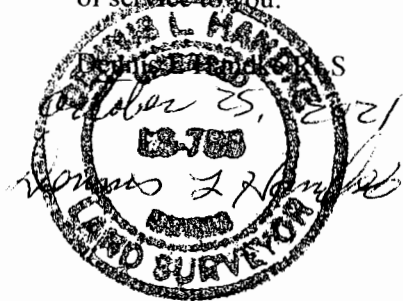

NOTE: Figures exhibited within this report are only to be used within the context of this report. Placement of property lines, wells, structures, and roads is based on the available information from county appraiser maps, surveys, site visits, and/or previous vendor reports and should be considered approximate.

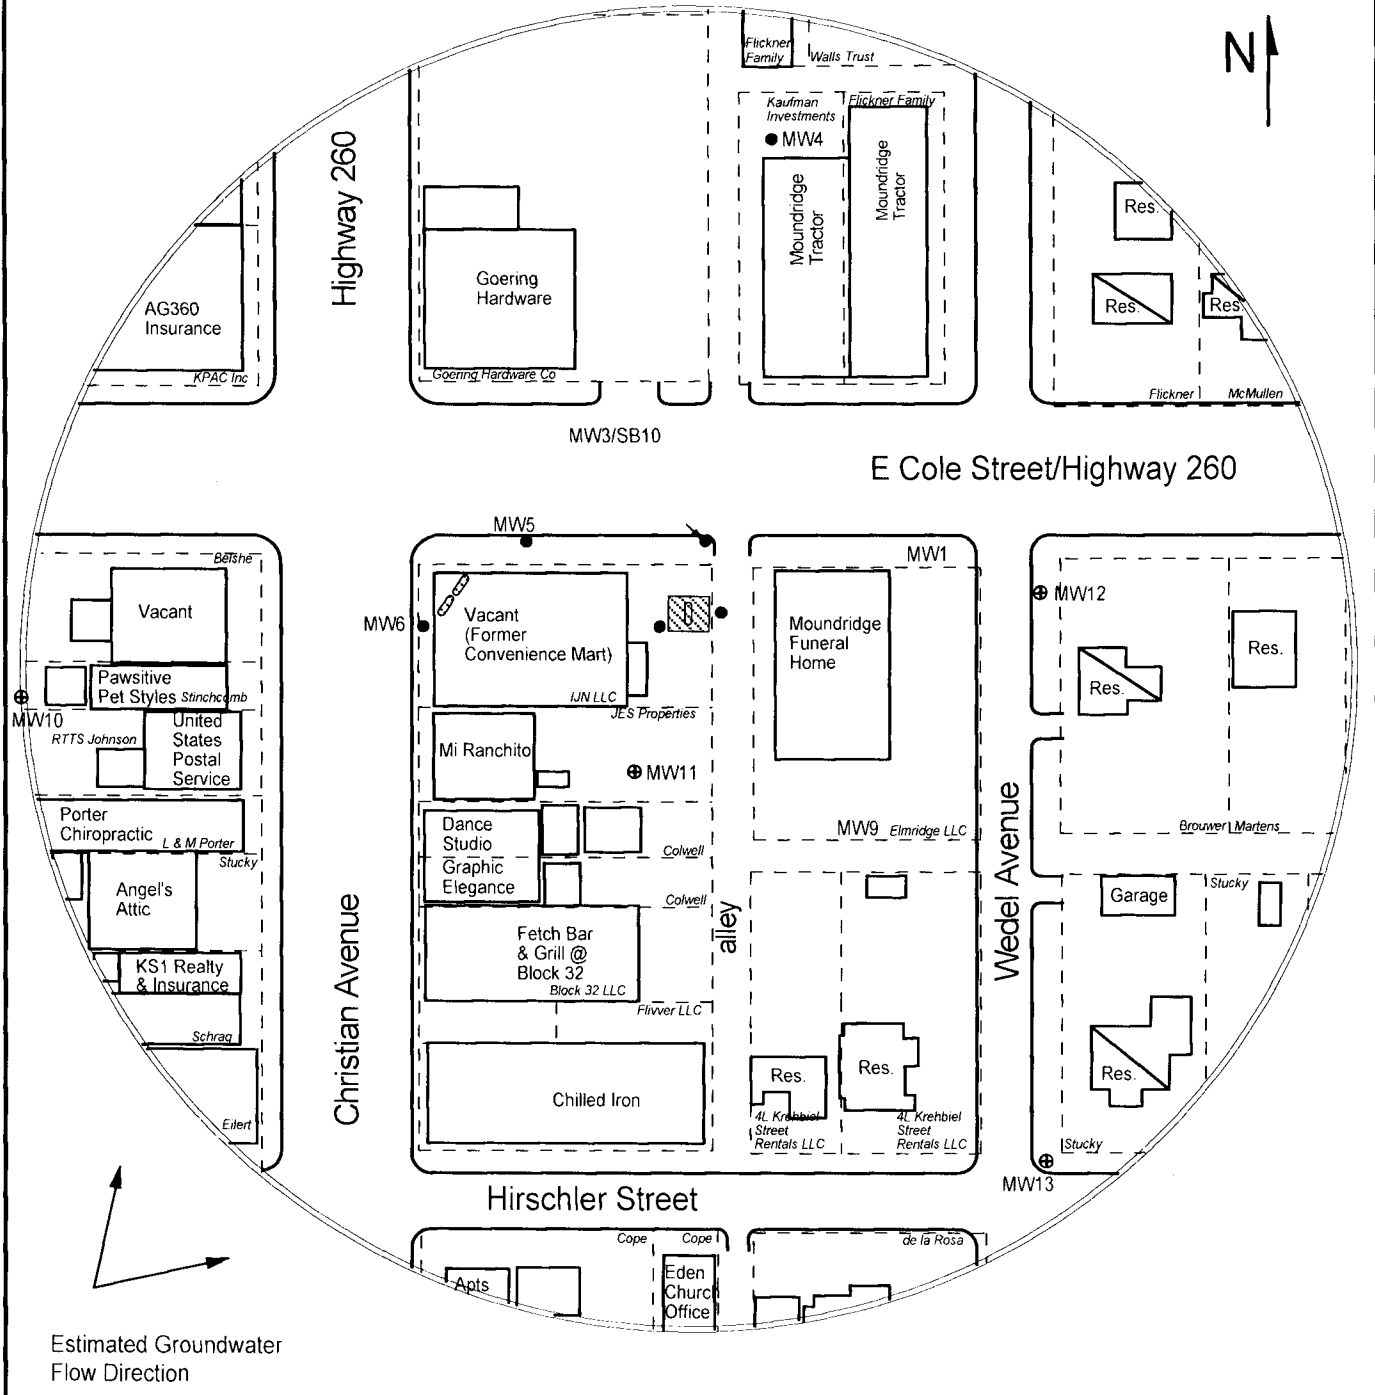


FIGURE 2.1 - 350 FT RADIUS AREA BASE MAP



PROJECT:

Convenience Mart
 100 S. Christian Ave.
 Moundridge, KS
 KDHE ID: U5-059-15162
 Date: 10/14/21



LEGEND:

- Approximate Location of Former UST Basin & Pump Islands
- Building with Basement
- Approximate Location of Property Line
- Existing Monitoring Well
- Monitoring Well (Installed 10/12-13/21)
- Soil Boring (Drilled 12/9-11/20, 12/15-17/20)
- Fire Hydrant
- Electric Lines (1.5 - 3 ft bgs)
- Gas Lines (1.5 - 3 ft bgs)
- Sewer Lines (2 - 6 ft bgs)
- Overhead Lines (25'-40' high)
- Telephone Lines (2 - 6 ft bgs)
- Water Lines (1.5 - 3 ft bgs)

NOTE: Utility depths, heights and locations are approximate.
 NOTE: SB1 & SB10 were drilled to collect hydrologic samples

1311 E 25th St. Suite B 785-841-8707 office
 Lawrence, KS 66046 785-865-4282 fax